


PAINT TOWNSHIP
N.W. QTR. SECTION 2
T-14N; R-11W
HOLMES COUNTY, OHIO
 (SURVEYED FOR: RAYMOND MILLER)

9900000343
 Filed for Record in
 HOLMES COUNTY, OH
 SALLY MILLER
 On 01-22-1999 At 11:18 am.
 SMALL PLAT 20.00
 Book OR Vol. 16 Pg. 982 - 982
 or vol. 24 pgs 735+738

INDEXED

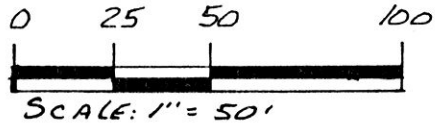

- ▲ R.R. SPIKE FOUND
- IRON PIN FOUND
- △ R.R. SPIKE SET
- 5/8" RE BAR WITH I.D. CAP SET
 I.D. CAP MARKED "BAKER 6938"

REFERENCES:

DEED VOL. 241	PAGE 839
" " 274	" 507
" " 202	" 447
" " 240	" 769
" " 223	" 875

NOTE: The 0.467 Ac. Parcel
 To BE ADDED TO ADJOINER
 To THE WEST.

990020
 APPROVED FOR TRANSFER ONLY
 NO SUBDIVISION PLAT REQUIRED
 (O.R.C. 711.001 & 711.131)
 Lot(s) not for building unless
 approved by Board of Health.
 HOLMES CO. PLANNING COMM.


By RD Date 1/24/99



I CERTIFY THIS SURVEY TO BE CORRECT
 TO THE BEST OF MY KNOWLEDGE.

Donald C. Baker
 DONALD C. BAKER P.S. 6938
 138 N. CLAY ST.
 MILLERSBURG, OHIO 44654
 PH. (330) 674-4788

AUGUST 10, 1998
 # 57998 - M.L. DAVIS
 F.C.C. F.D. BAKER

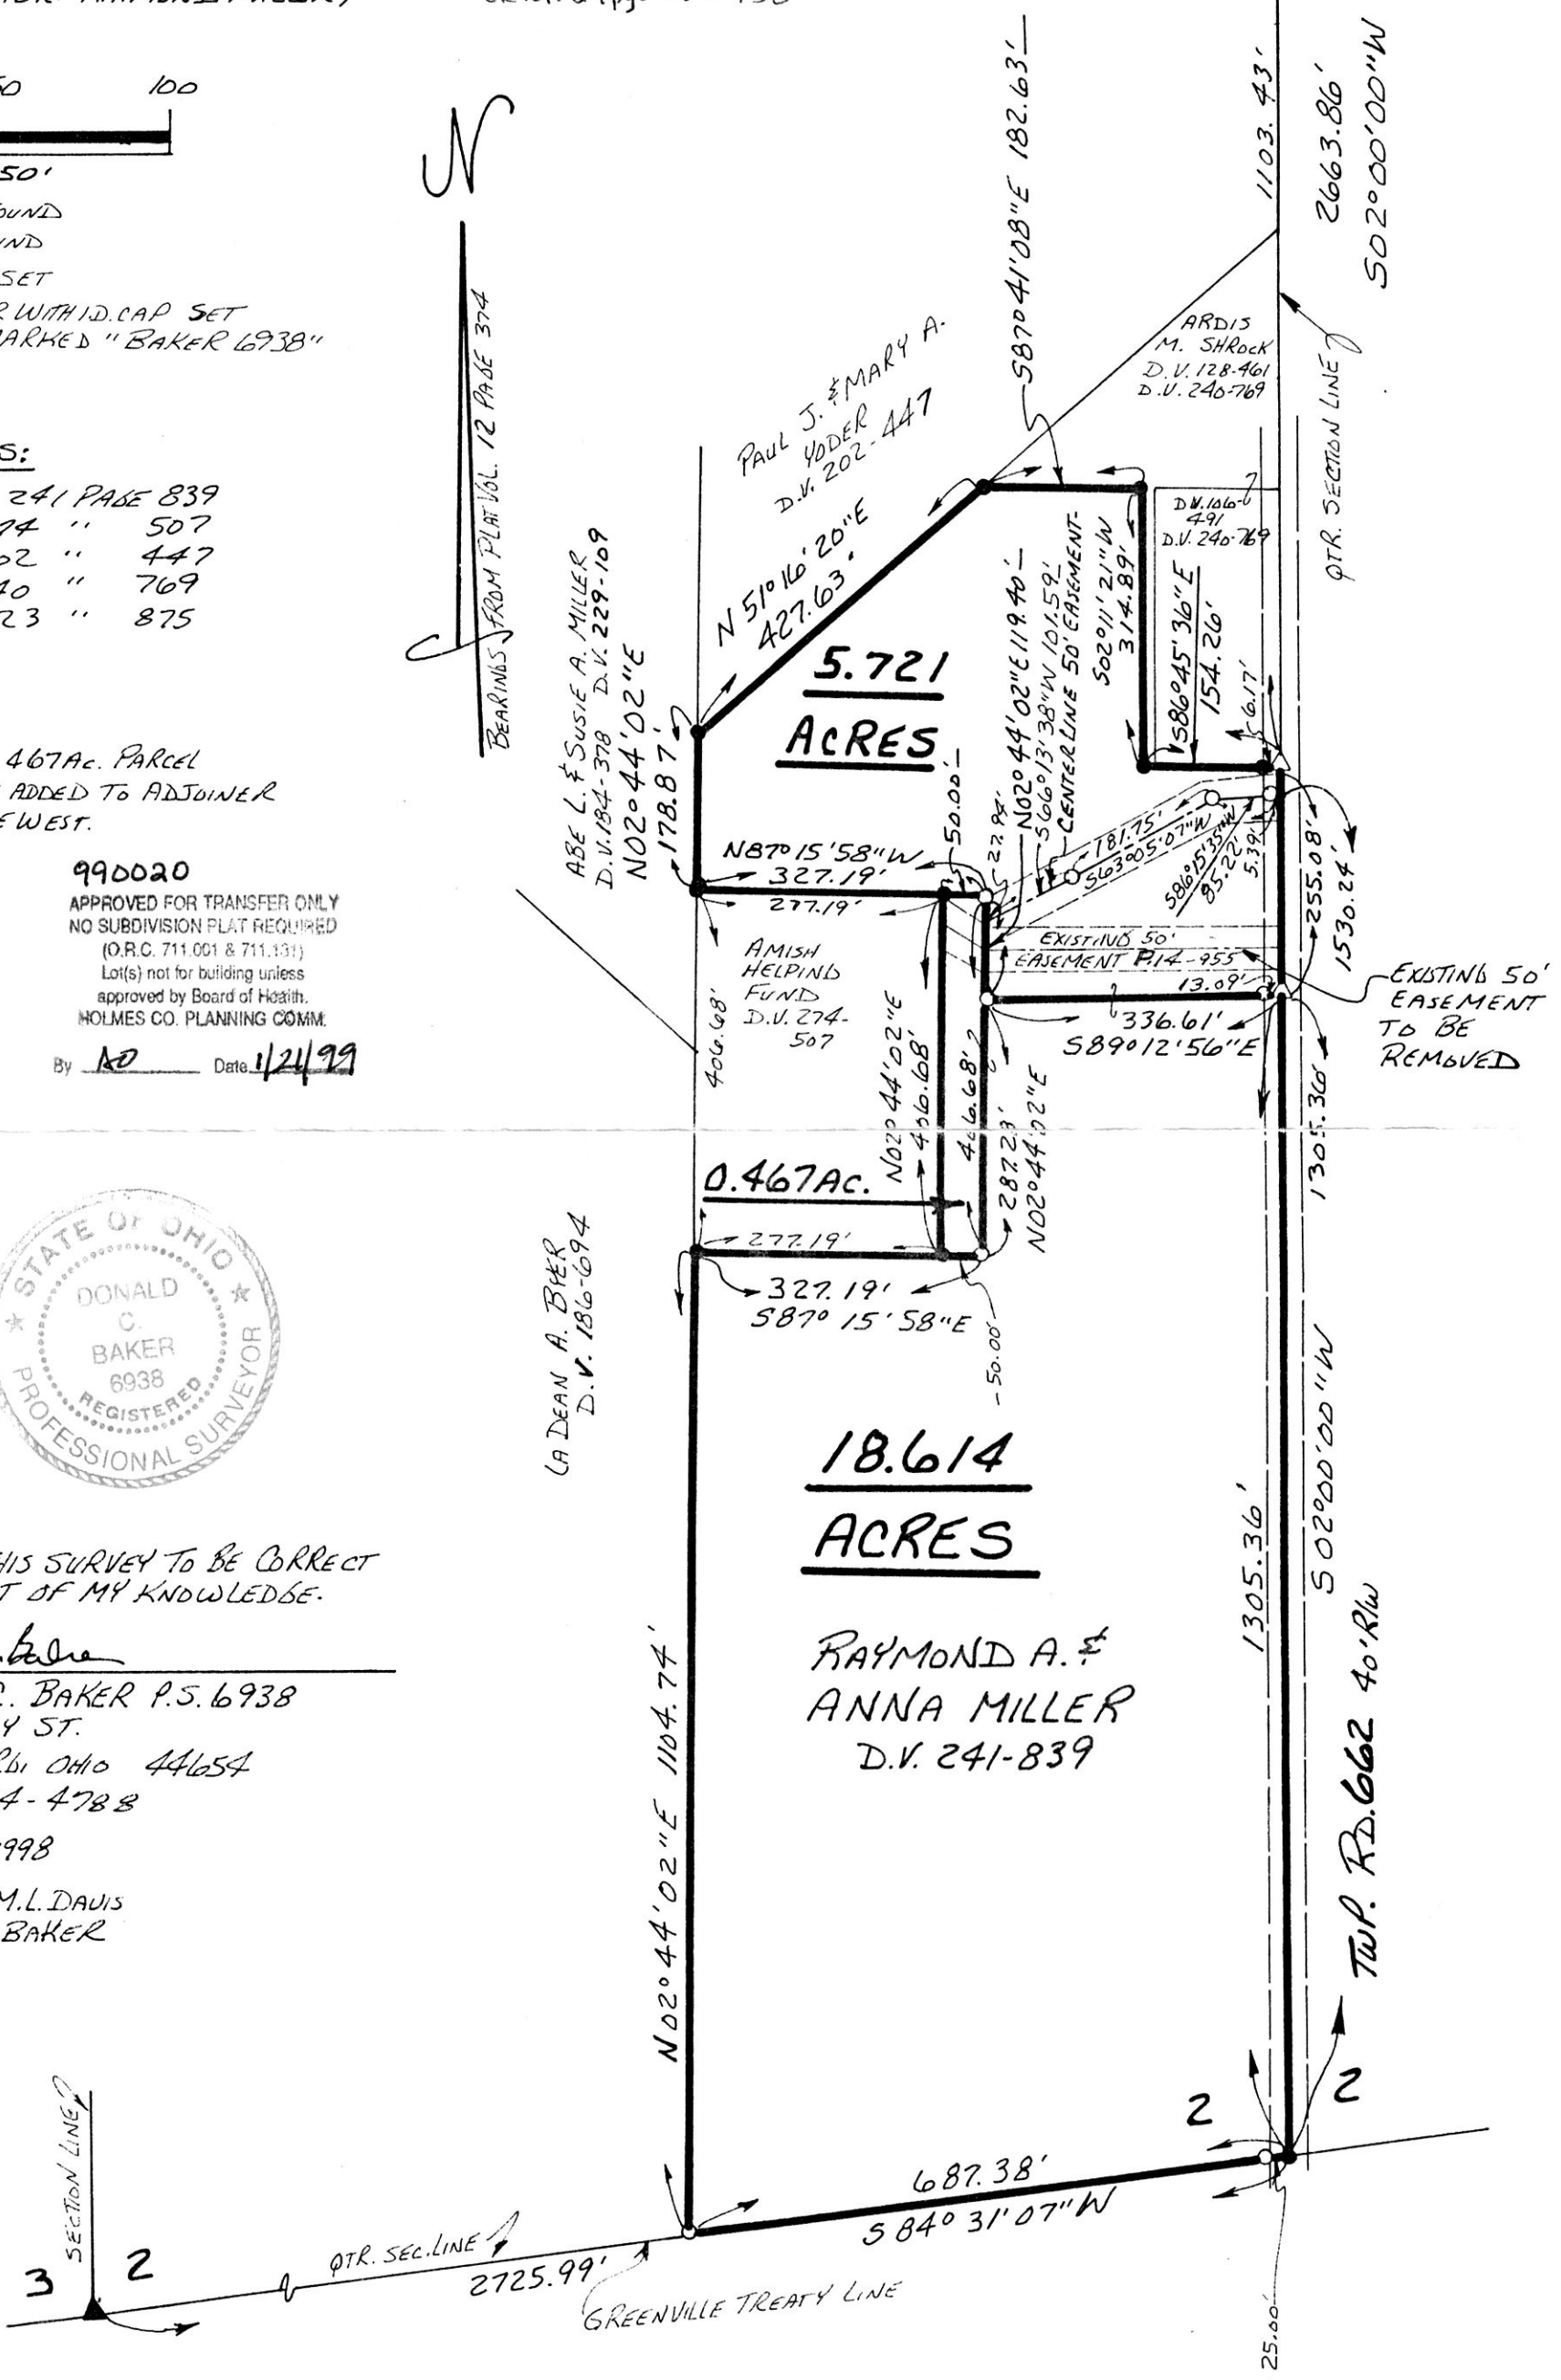

9900000343
 HOLMES CTY TITLE
 MILLERSBURG,

PLAT APPROVED

1/21/998