

SCALE: 1" = 200'

- IRON PIN FOUND
- △ R.R. SPIKE SET
- 3/8" RE BAR WITH I.D. CAP SET
- I.D. CAP MARKED "BAKER 6938"

BEARINGS FROM DEED VOL. 214 PAGE 531

SALT CREEK TOWNSHIP
4TH. QTR. LOT 5
T-10N ; R-6W
HOLMES COUNTY, OHIO
 (SURVEYED FOR: CARL C. & AVALON FRY)

REFERENCES:


DEED VOL. 222 PAGE 704
 " " 97 " 408
 " " 161 " 143
 " " 151 " 481
 " " 182 " 478

PLAT VOL. 5 PAGE 164
 " " 8 " 565
 " " 8 " 564
 " " 4 " 10
 " " 11 " 179

SURVEY RECORD 4 PAGES 14, 15, 16 & 17

990000911
 Filed for Record in
 HOLMES COUNTY, OH
 SALLY MILLER
 On 02-22-1999 At 03:57 pm.
 PLAT MED 21.60
 Book OR Vol. 17 Pg. 9 - 9

990000911
 LAUREL SCHMID ATTY
 MILLERSBURG,

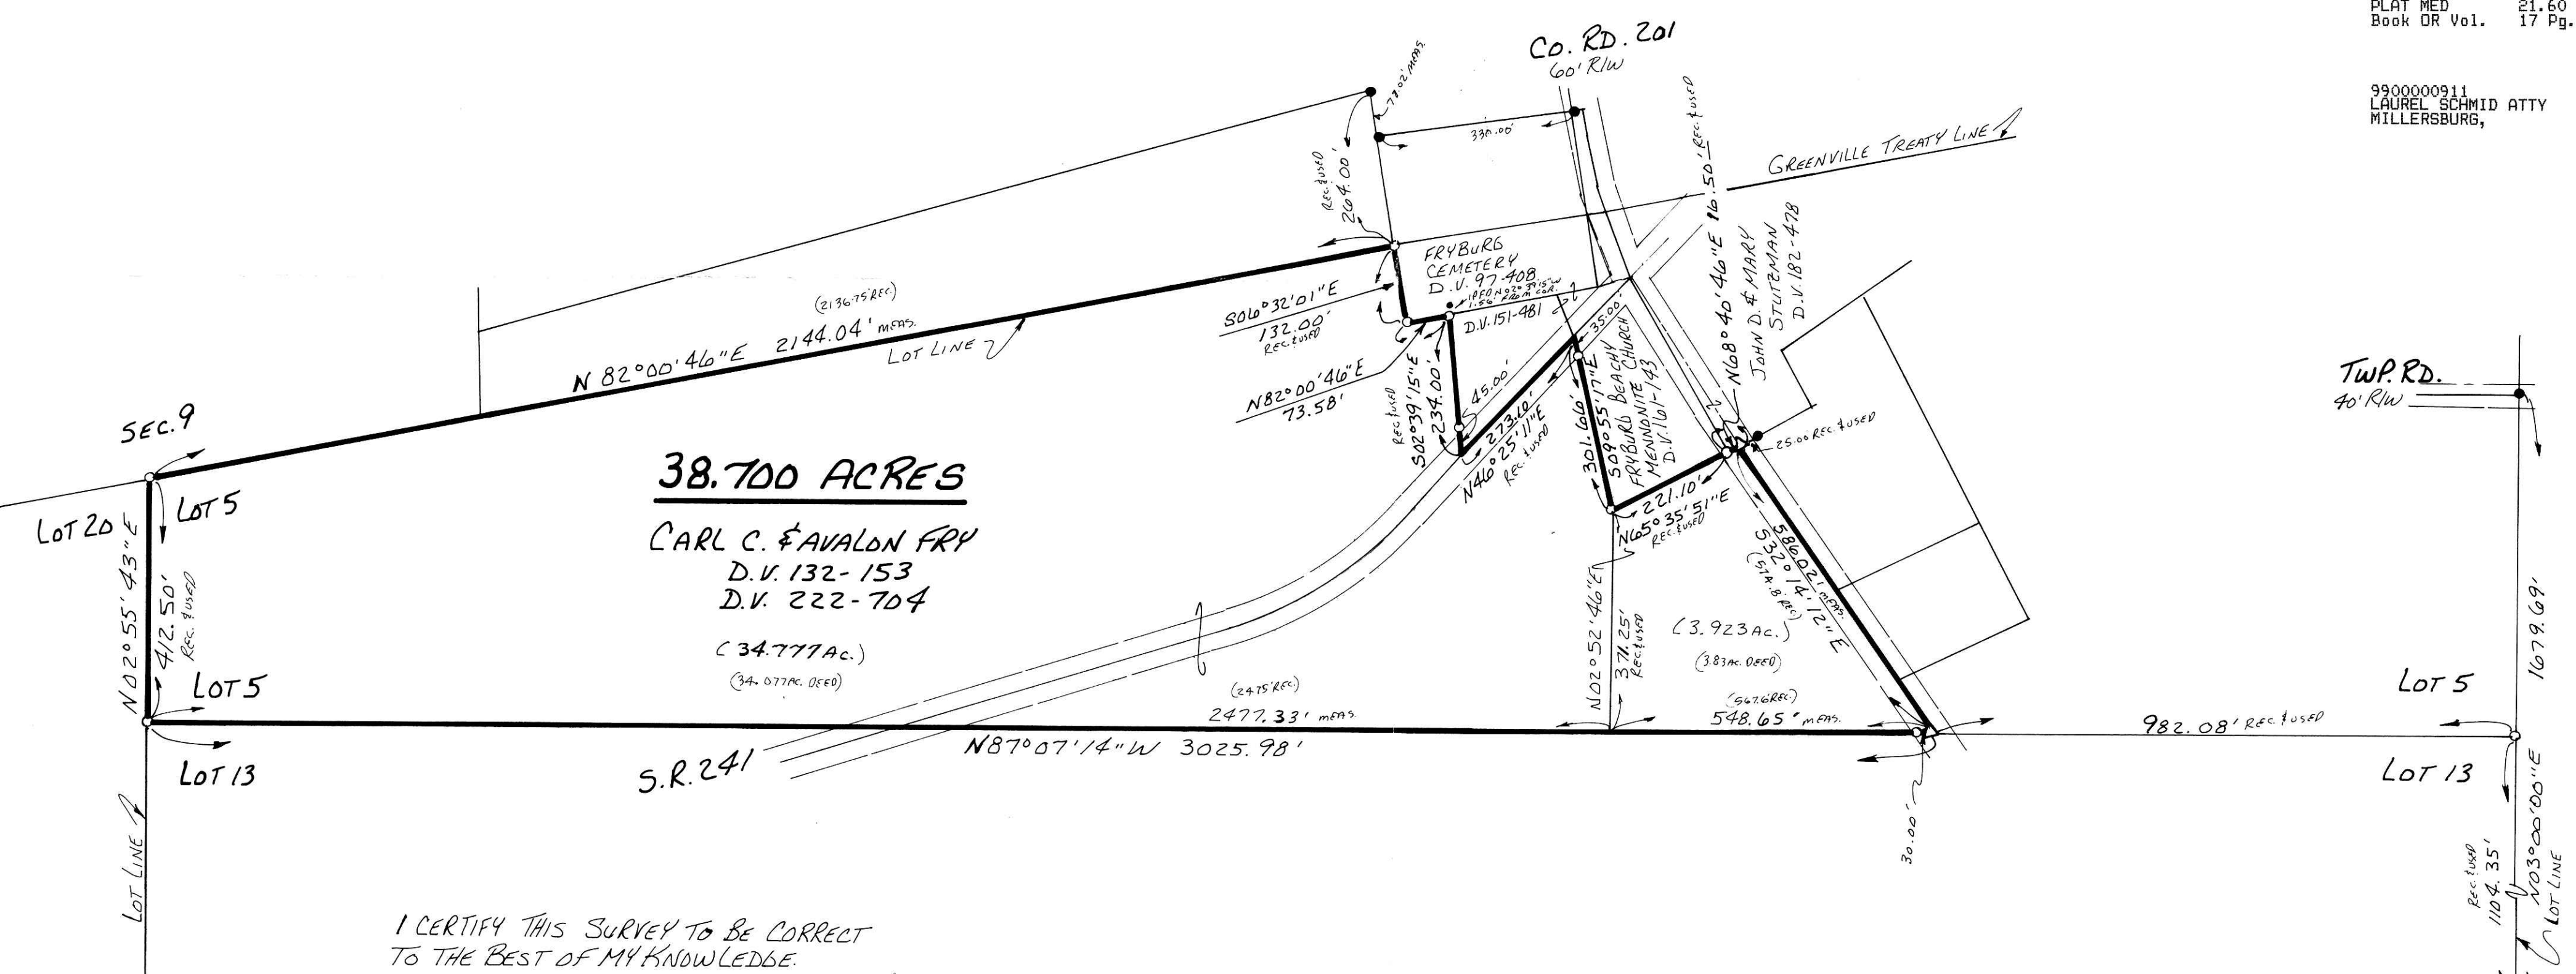

38.700 ACRES
CARL C. & AVALON FRY
 D.V. 132-153
 D.V. 222-704
 (34.777 Ac.)
 (34.077 Ac. DEED)

I CERTIFY THIS SURVEY TO BE CORRECT
 TO THE BEST OF MY KNOWLEDGE.

Donald C. Baker
 DONALD C. BAKER P. S. 6938
 138 N. CLAY ST.
 MILLERSBURG, OHIO 44654
 PH. (330) 674-4788
 FEBRUARY 2, 1999



#92698-M.L. DAVIS
 F.C.C. - F.D. BAKER