


BERLIN TOWNSHIP
4TH. QTR. LOT 11
T-9N:R-6W
HOLMES COUNTY, OHIO

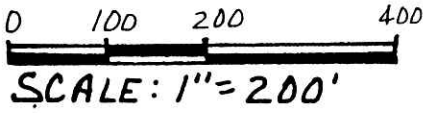

- STONE FOUND
- IRON PIN FOUND
- △ RR SPIKE SET
- 5/8" REBAR WITH I.D. CAPSET, I.D. CAP MARKED "BAKER 6938"



REFERENCES:

DEED Vol. 202 PAGE 389
" " 220 " 821

BEARINGS FROM PLAT VOL. 7 PAGE 227

SURVEYED FOR ROY A. TROYER


9900001790
Filed for Record in
HOLMES COUNTY, OH
SALLY MILLER
On 04-14-1999 At 09:52 am.
SMALL PLAT 20.00
Book OR Vol. 17 Pg. 62 - 62
of vol 29 pg 489

INDEXED

990094

APPROVED FOR TRANSFER ONLY
NO SUBDIVISION PLAT REQUIRED
(O.R.C. 711.001 & 711.131)
Lots) not for building unless
approved by Board of Health,
HOLMES CO. PLANNING COMM.

By Do Date 4/12/99

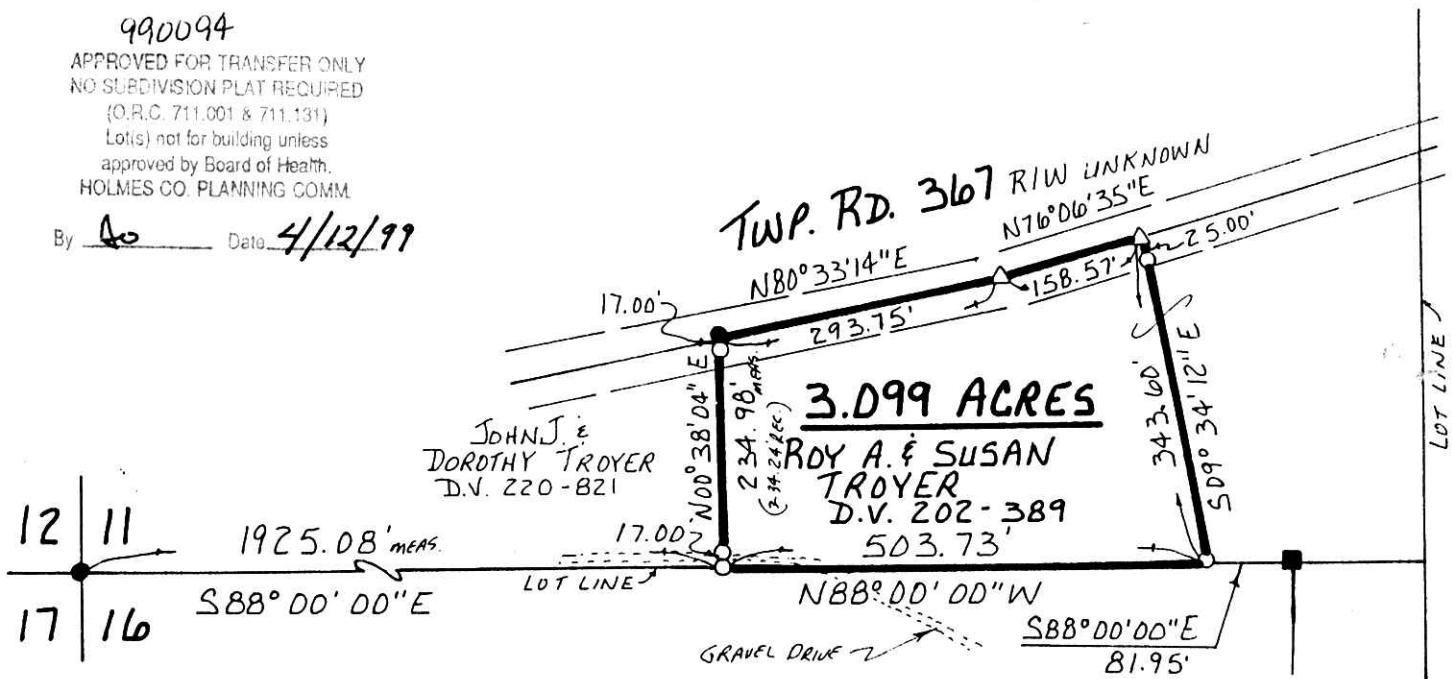

9900001790
DAVID C FEHR
5238 CR 77
MILLERSBURG, OH 44654



I CERTIFY THIS SURVEY TO BE CORRECT
TO THE BEST OF MY KNOWLEDGE.

Donald C. Baker

DONALD C. BAKER P.S. 6938

138 N. CLAY ST.
MILLERSBURG, OHIO 44654
PH: (330) 674-4788

JUNE 29, 1998

#40698-FJM
F.C.C.-D.C. BAKER

PLAT APPROVED

4/14/99b