


HARDY TOWNSHIP
3RD. QTR. LOTS 3 & 8
T. 9N R. 7W
HOLMES COUNTY, OHIO
(SURVEYED FOR: PATRICK W. ROCHE)

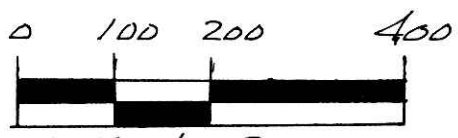

SCALE: 1" = 200'

- STONE FOUND
- ▲ R. R. SPIKE FOUND
- IRON PIN FOUND
- △ R. R. SPIKE SET
- 5/8" RE BAR WITH I.D. CAP SET
I.D. CAP MARKED "BAKER 6938"



REFERENCES:

DEED Vol. 270 Page 450
" " 246 " 901
" " 247 " 277

O.R. Vol. 29 Page 4
PLAT Vol. 7 Page 535
" " 3 " 59
" " 16 " 303

199900003044
Filed for Record in
HOLMES COUNTY, OH
SALLY MILLER
On 06-22-1999 At 08:29 am.
PLAT MED 21.60
OR Book 17 Page 146 - 146
or vol 33 pg 743-800-808


199900003044
ROBERT RINFRET ATTY
MILLERSBURG,

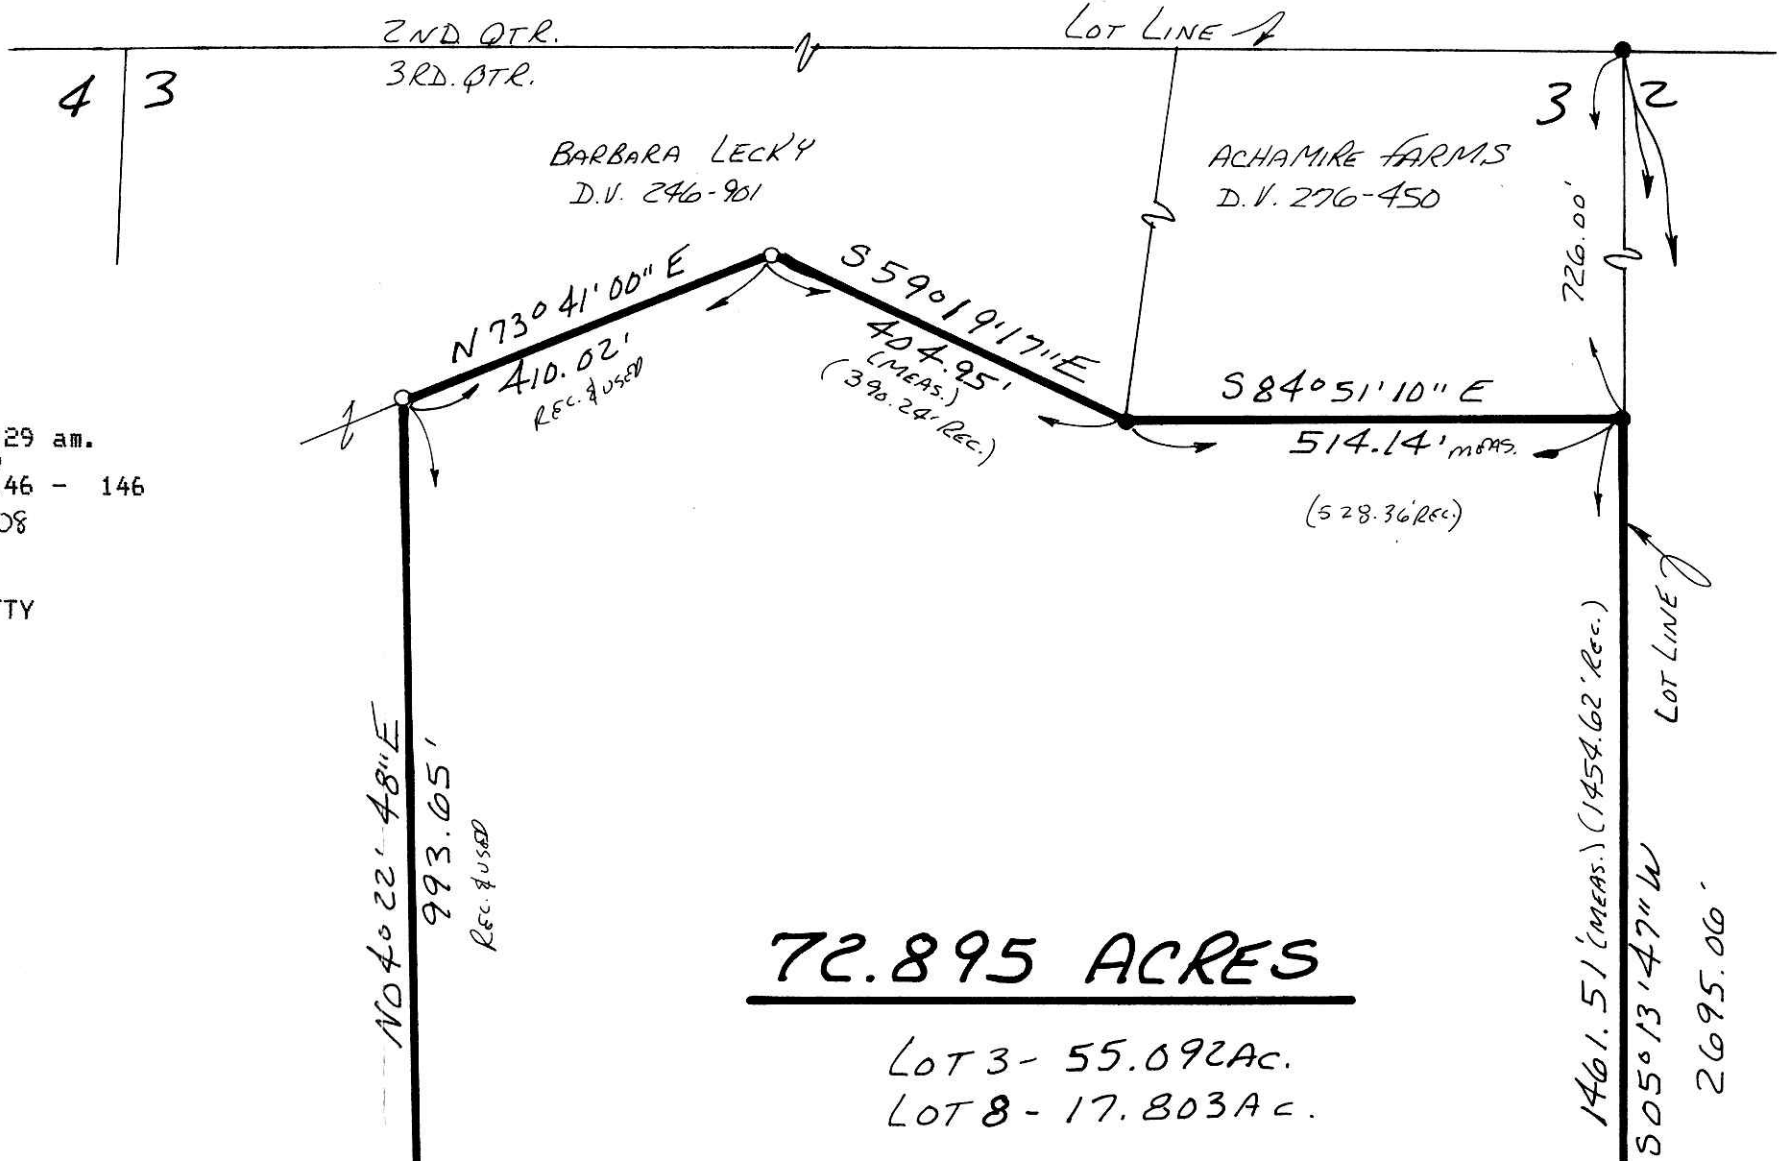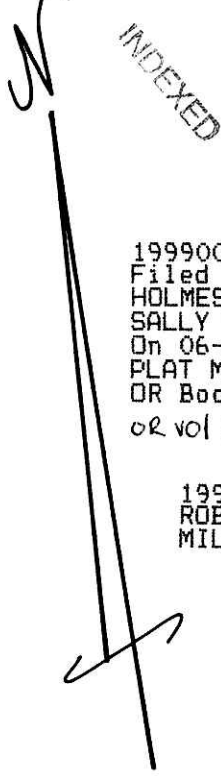

72.895 ACRES

LOT 3 - 55.092 Ac.
LOT 8 - 17.803 Ac.

PATRICK W. ROCHE
O.R. 29-4

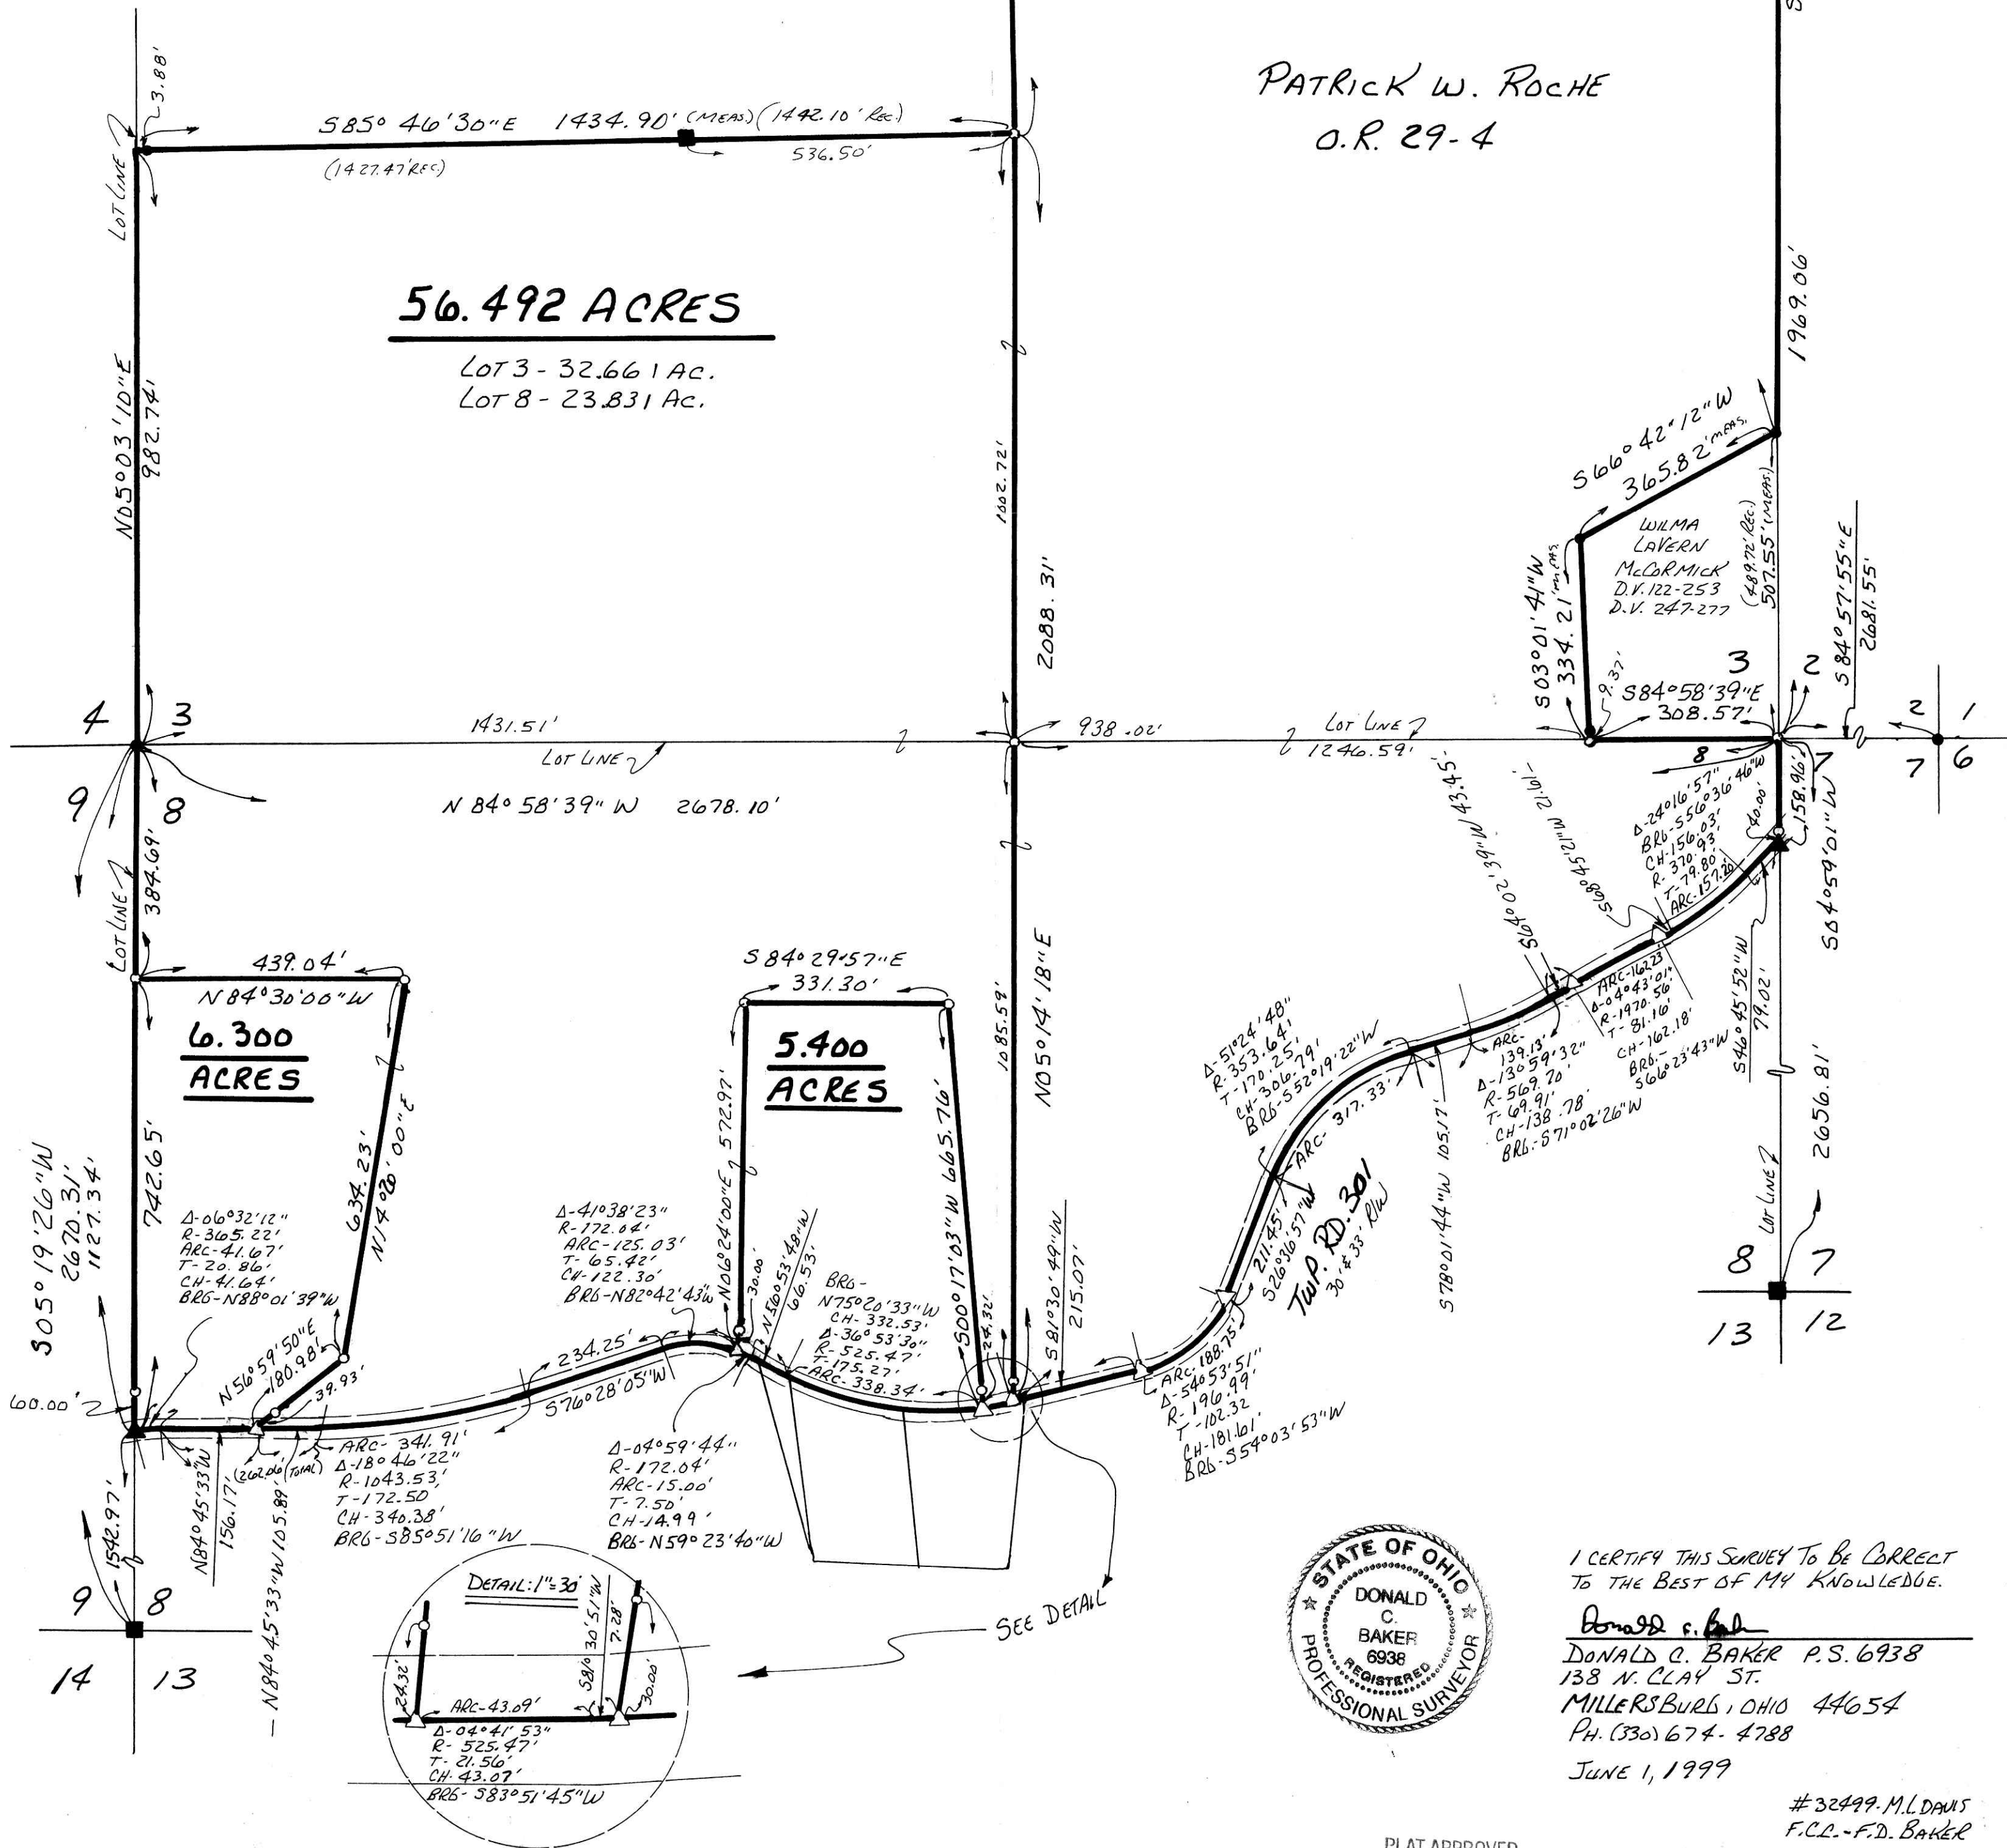

56.492 ACRES

LOT 3 - 32.661 Ac.
LOT 8 - 23.831 Ac.

6.300 ACRES

5.400 ACRES



I CERTIFY THIS SURVEY TO BE CORRECT
TO THE BEST OF MY KNOWLEDGE.
Donald C. Baker
DONALD C. BAKER P.S. 6938
138 N. CLAY ST.
MILLERSBURG, OHIO 44654
PH. (330) 674-4788
JUNE 1, 1999

PLAT APPROVED

6/21/99

#32499 M.L. DAVIS
F.C.C. - F.D. BAKER