


**BERLIN TOWNSHIP
N.E. QTR. SECTION 4
T-9N; R-5W
HOLMES COUNTY, OHIO**

(SURVEYED FOR ANDY & ANNA MILLER)

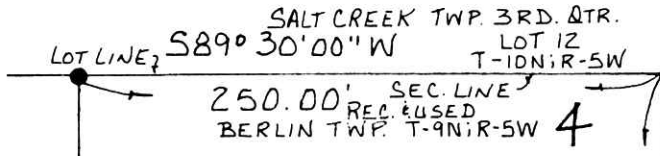


990341
APPROVED FOR TRANSFER ONLY -
NO SUBDIVISION PLAT REQUIRED
(O.R.C. 711.001 & 711.131)
Lot(s) not for building unless
approved by Board of Health
HOLMES CO. PLANNING COMM.

By AD Date 12/2/99

777.90' SEC. LINE 2
WALNUT CREEK TWP.
1ST QTR. LOT 3
T-9N; R-5W

199900005812
Filed for Record in
HOLMES COUNTY, OH
SALLY MILLER
On 12-03-1999 At 11:43 am.
SMALL PLAT 20.00
DR Book 17 Page 321 - 321
or vol 43 p 218

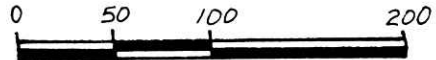

SCALE: 1" = 100'

- ▲ R.R. SPIKE FOUND
- IRON PIN FOUND
- 5/8" REBAR WITH I.D. CAP SET
I.D. CAP MARKED "BAKER 6938"



ANDY J. & ANNA
MILLER
D.V. 206-426

N84°22'25"E
165.25'

**1.538
ACRES**

JACOB E. &
VERNA MILLER
1/2 INT.
ATLEE J. &
ELIZABETH
MILLER 1/2 INT.
D.V. 147-94
D.V. 125-136
D.V. 207-424
D.V. 247-120

500°11'47"E

Twp. Rd. 652 30' R/W

INDEXED

REFERENCES:

DEED VOL. 206	PAGE 426
" " 147	" 94
" " 125	" 136
" " 207	" 424
" " 247	" 120

BEARINGS FROM PLAT VOL. 5 PAGE 5




199900005812
LAUREL SCHMID ATTY
MILLERSBURG,

I CERTIFY THIS SURVEY TO BE CORRECT
TO THE BEST OF MY KNOWLEDGE.

Donald C. Baker
DONALD C. BAKER P.S. 6938
138 N. CLAY ST.
MILLERSBURG, OHIO 44654
PH: (330) 674-4788

MAY 6, 1999 # 22899- FJM
F.C.C. - J.D. DARR

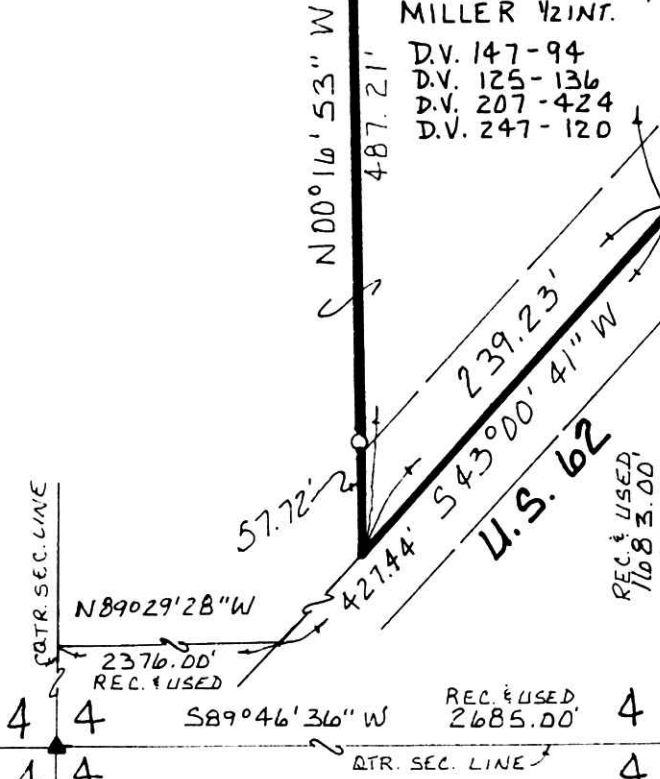

PLAT APPROVED

12/3/99 b