



0 25 50 100

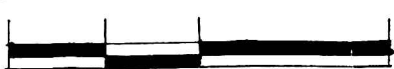

SCALE: 1" = 50'

- STONE FOUND
- IRON PIN FOUND
- 5/8" RE BAR WITH I.D. CAP SET
- I.D. CAP MARKED "BAKER 6938"

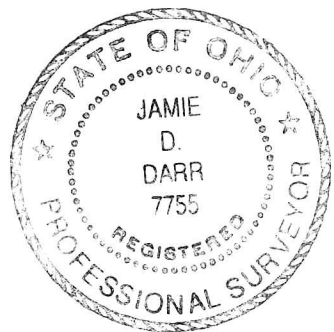

MECHANIC TOWNSHIP
 S.E. & S.W. QTRS. SECTION 2
 T-8N; R-7W
 HOLMES COUNTY, OHIO
 (SURVEYED FOR: MARILYN R. WOODS RABER)

RESURVEY OF D.V. 228 P6. 664

REFERENCES:


DEED VOL. 228 PAGE 664
 " " 257 " 352
 " " 213 " 5
 " " 281 " 534
 PLAT VOL 8 PAGE 740
 " " 8 " 741
 " " 12 " 204

BEARINGS FROM PLAT VOL. 15
PAGE 57

199900006041
 Filed for Record in
 HOLMES COUNTY, OH
 SALLY MILLER
 On 12-17-1999 At 02:54 pm.
 SMALL PLAT 20.00
 OR Book 17 Page 335 - 335
 Off. Rec. 44 Page 35

INDEXED

199900006041
 TOWER CITY
 TITLE
 HIGHLAND HTS, OH

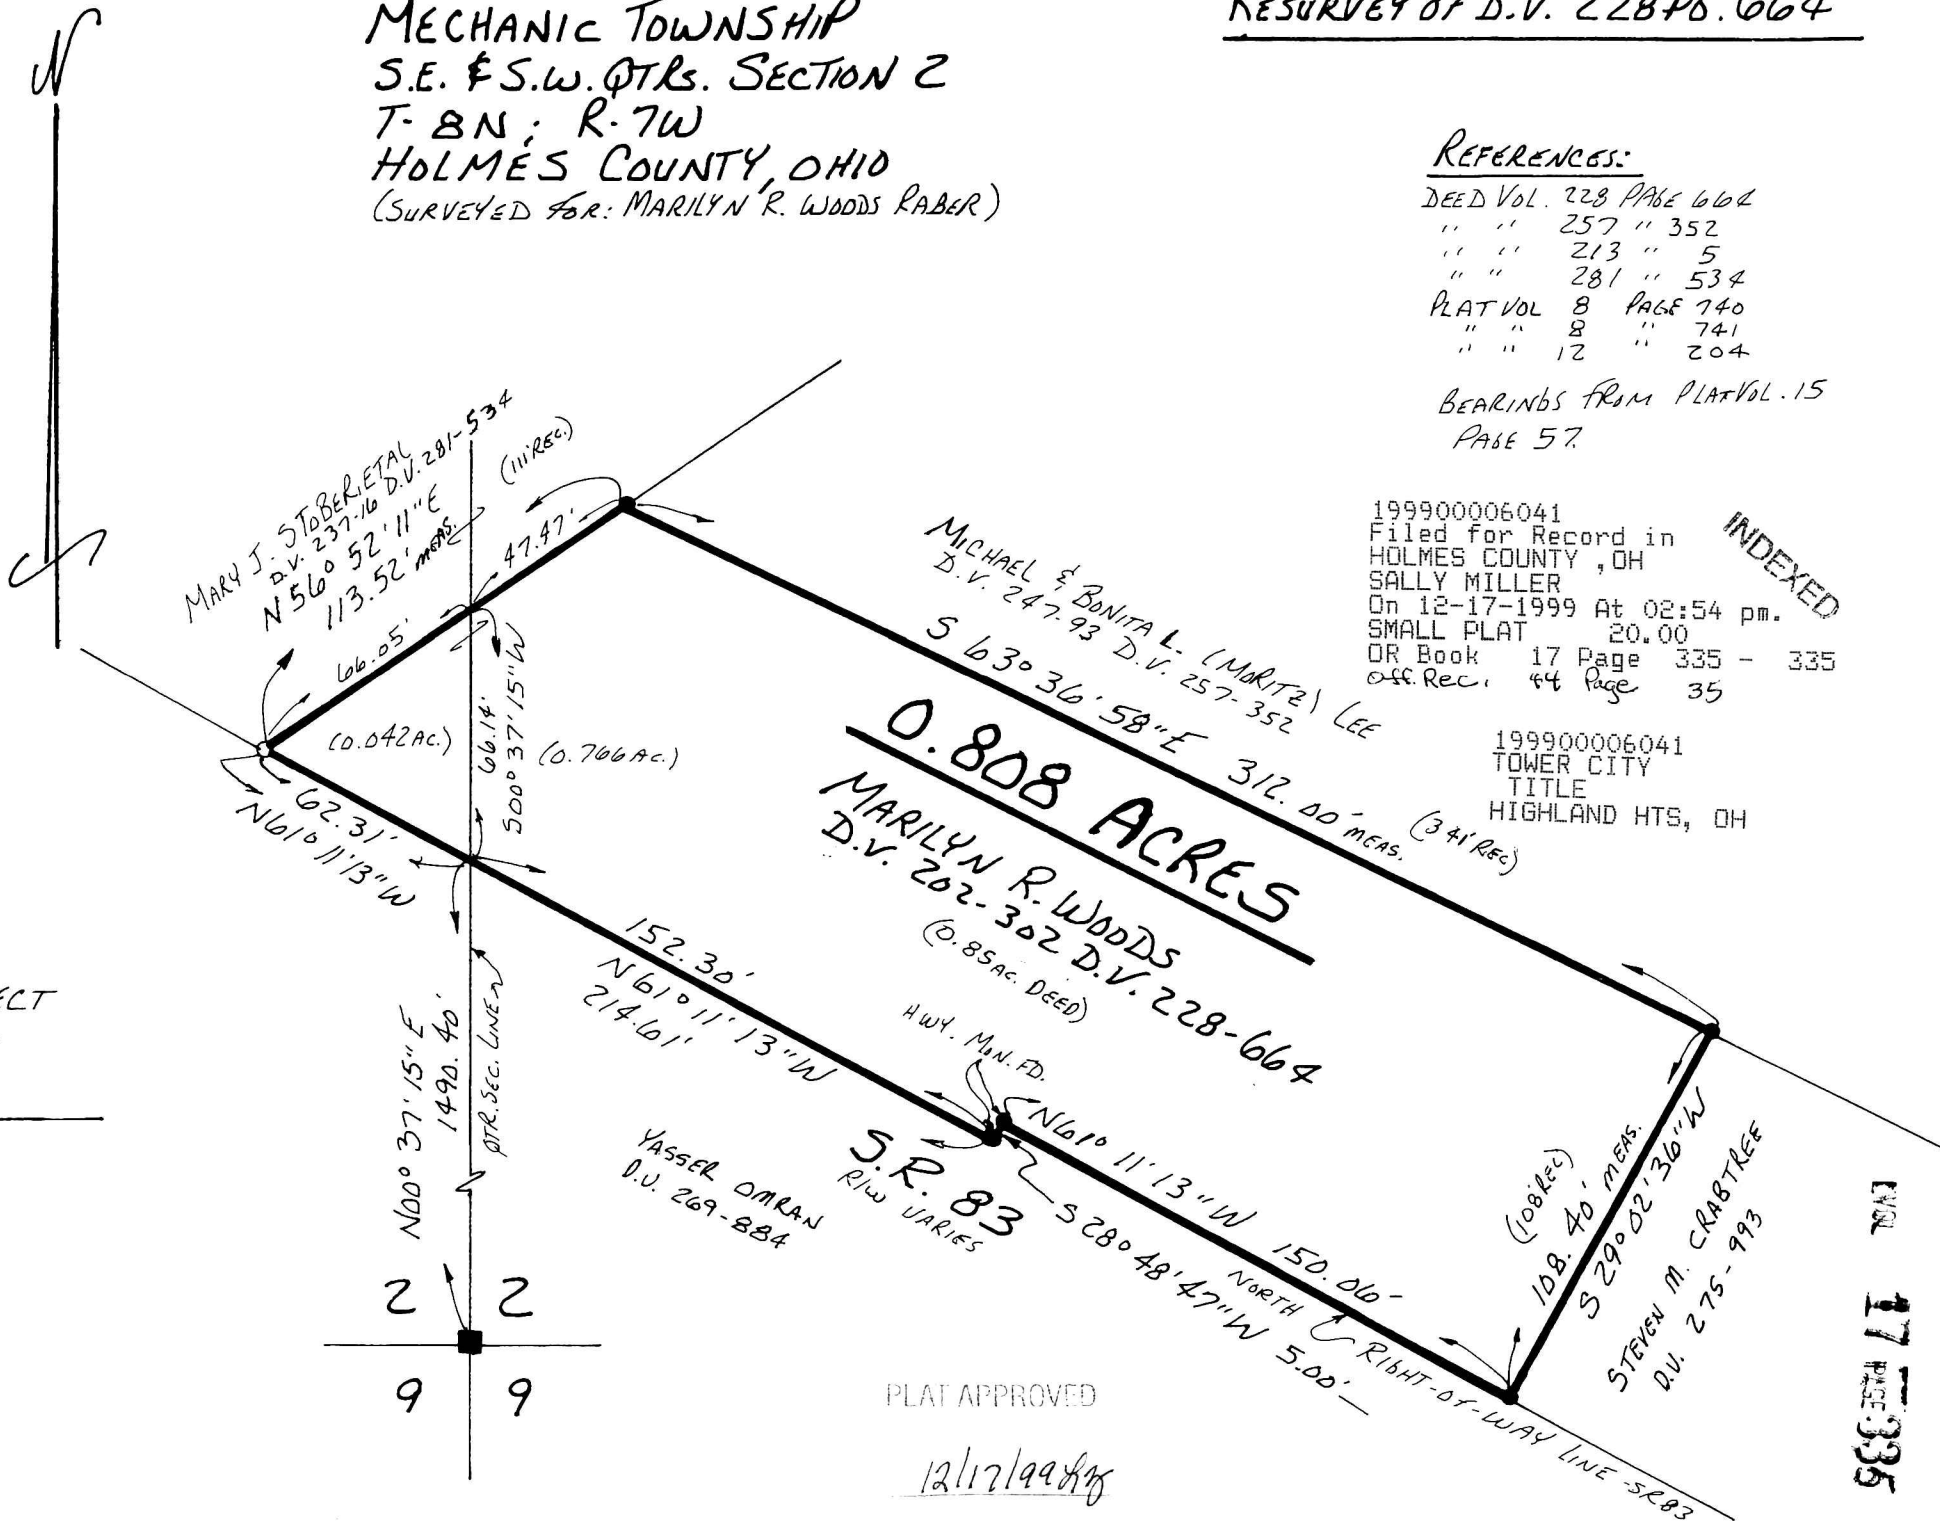

I CERTIFY THIS SURVEY TO BE CORRECT TO THE BEST OF MY KNOWLEDGE.

JAMIE D. DARR P.S. 7755
 DONALD C. BAKER SURVEYING
 138 N. CLAY ST.
 MILLERSBURG, OHIO 44654
 PH. (330) 674-4788
 NOVEMBER 24, 1999
 #74899- M.L. DAVIS
 F.C.C. - J. D. DARR

FILED 17 FEB 1999