


- SCALE: 1" = 200'
- IRON PIN FOUND
 - P.K. NAIL SET
 - △ R.R. SPIKE SET
 - 5/8" REBAR WITH I.D. CAP SET
 - I.D. CAP MARKED "BAKER 6938"

REFERENCES:
 DEED VOL. 189 PAGE 852
 " " 195 " 98
 " " 269 " 195
 PLAT VOL. 7 PAGE 441
 " " 6 " 56

KILLBUCK TOWNSHIP
N.E. QTR. SECTION 6
T-8N R-7W
HOLMES COUNTY, OHIO
 (SURVEYED FOR: SHREINER SOLE CO., INC.)

(A) BARBARA J. McFARLAND D.V. 269-195

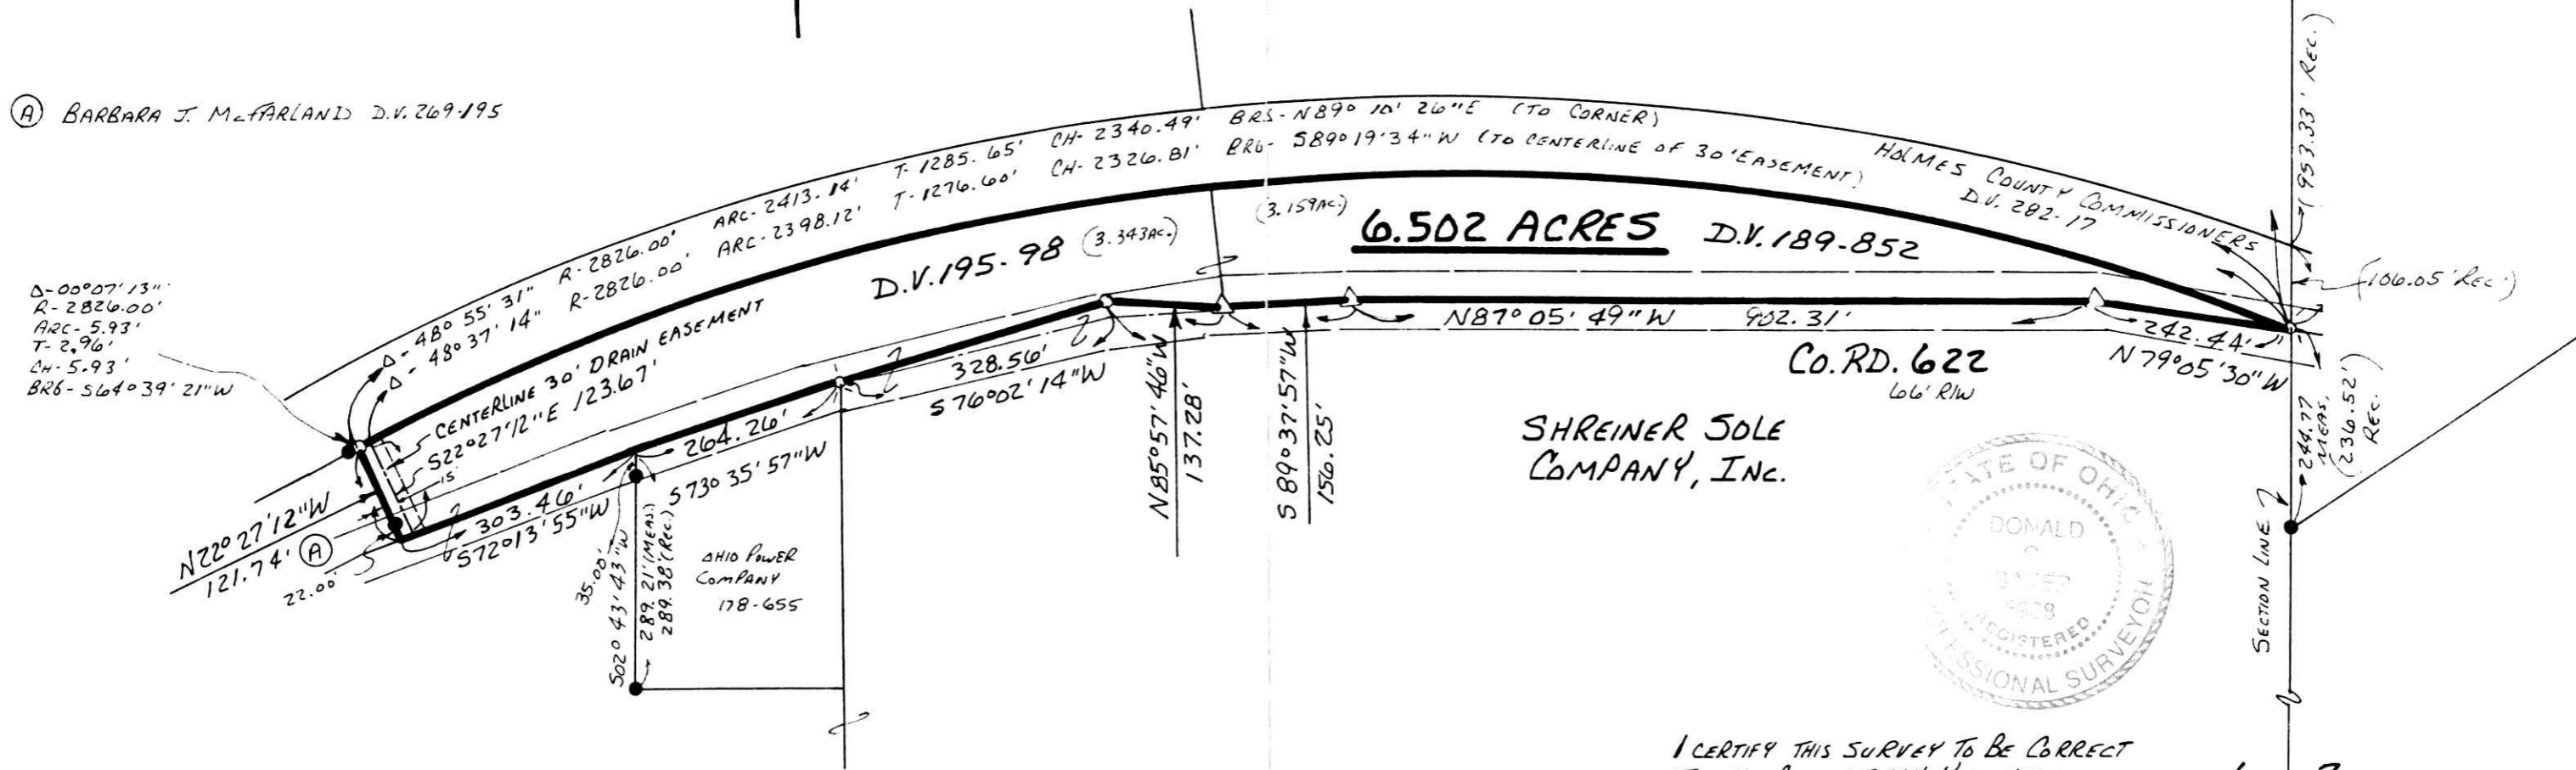

Δ-00°07'13"
 R-2826.00'
 ARC-5.93'
 T-2.96'
 CH-5.93'
 BR6-564°39'21"W

INDEXED

199900006182
 Filed for Record in
 HOLMES COUNTY, OH
 SALLY MILLER
 On 12-28-1999 At 08:53 am.
 SMALL PLAT 20.00
 OR Book 17 Page 345 - 345
 OR vol 44 page 465

199900006182
 DANIEL MATHIE ATTY
 MILLERSBURG,



I CERTIFY THIS SURVEY TO BE CORRECT
 TO THE BEST OF MY KNOWLEDGE.

Donald C. Baker
 DONALD C. BAKER P.S. 6938
 138 N. CLAY ST.
 MILLERSBURG, OHIO 44654
 PH. (330) 674-4788

DECEMBER 7, 1998

6	7
6	7

PLAT APPROVED
 12/23/99 *[Signature]*