

PLAT OF RESURVEY & CORRECTION

17 417

REFERENCES:

DEED VOL. 267 PAGE 750
 " " 115 " 221
 " " 178 " 385
 " " 249 " 545

OFFICIAL RECORD VOL. 24 PAGE 794

BEARINGS FROM D.R. VOL. 24 PAGE 794

WALNUT CREEK TOWNSHIP
 1ST. QTR. LOT 15
 T-9N;R-5W
 HOLMES COUNTY, OHIO

(SURVEYED FOR KEITH & SUSAN MILLER)

0 50 100 200

SCALE: 1" = 100'

- IRON PIN FOUND
- 5/8" REBAR WITH I.D. CAP SET I.D. CAP MARKED "BAKER 6938"

NOTE:
 THIS PLAT OF CORRECTION IS TO CORRECT THE LOT LINE USED IN D.V. 267 Pg. 750.

200000001025
 Filed for Record in
 HOLMES COUNTY, OH
 SALLY MILLER
 On 03-08-2000 At 12:05 pm.
 SMALL PLAT 20.00
 OR Book 17 Page 417 - 417
 OR Vol 48 Page 427

INDEXED


200000001025
 LAUREL
 SCHMID ATTY
 MILLERSBURG,

DAVID H. & FANNIE H.
 (SCHLABACH) MILLER
 D.V. 115-221 D.V. 178-385
 D.V. 249-545



I CERTIFY THIS SURVEY TO BE CORRECT TO THE BEST OF MY KNOWLEDGE.

Donald C. Baker
 DONALD C. BAKER P.S. 6938
 DONALD C. BAKER SURVEYING
 138 N. CLAY ST.
 MILLERSBURG, OHIO 44654
 PH: (330) 674-4788
 FEBRUARY 21, 2000 #8000A-FJM
 F.C.C. - F.D. BAKER

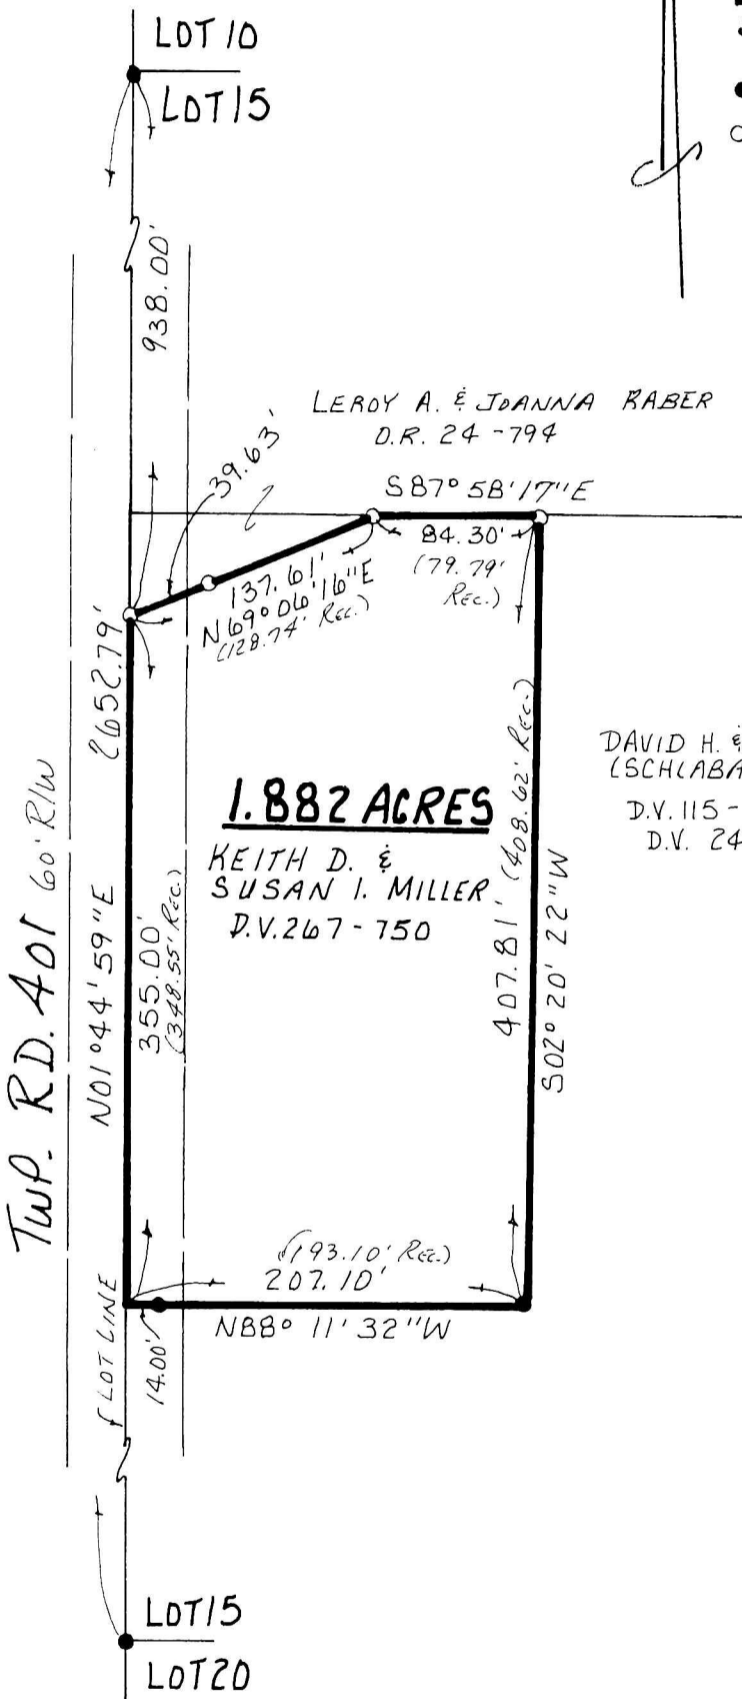

PLAT APPROVED

3/8/004