


VILLAGE OF GLENMONT
 RICHLAND TOWNSHIP
 N.W. QTR. SECTION 1
 T-8N R-9W
 HOLMES COUNTY, OHIO
 (SURVEYED FOR: DAVID M. MILLER)

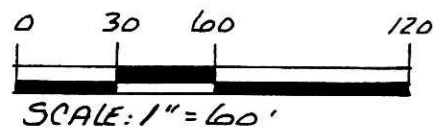

- IRON PIN FOUND
- 5/8" RE BAR WITH I.D. CAP SET
I.D. CAP MARKED "BAKER 6938"

Ⓐ JOSEPH G. KLINE & DOLORES E. BRETZ
 D.V. 275-588



I CERTIFY THIS SURVEY TO BE CORRECT
 TO THE BEST OF MY KNOWLEDGE.

Jamie D. Darr
 JAMIE D. DARR P.S. 7755
 DONALD C. BAKER SURVEYING
 138 N. CLAY ST.
 MILLERSBURG, OHIO 44654
 PH. (330) 674-4788


APRIL 3, 2000

#19900A - M.L. DAVIS
 F.C.R. - J. D. DARR

RESURVEY OF A 2.417 ACRE PARCEL
RECORDED IN O.R. VOL. 45 PAGE 184

- REFERENCES:
- DEED VOL. 267 PAGE 730
 - " " 272 " 935
 - " " 221 " 970
 - " " 275 " 588
 - O.R. VOL. 27 PAGE 976
 - " " 1 " 111
 - " " 45 " 184

BEARINGS FROM PLAT VOL. 17 PG. 242

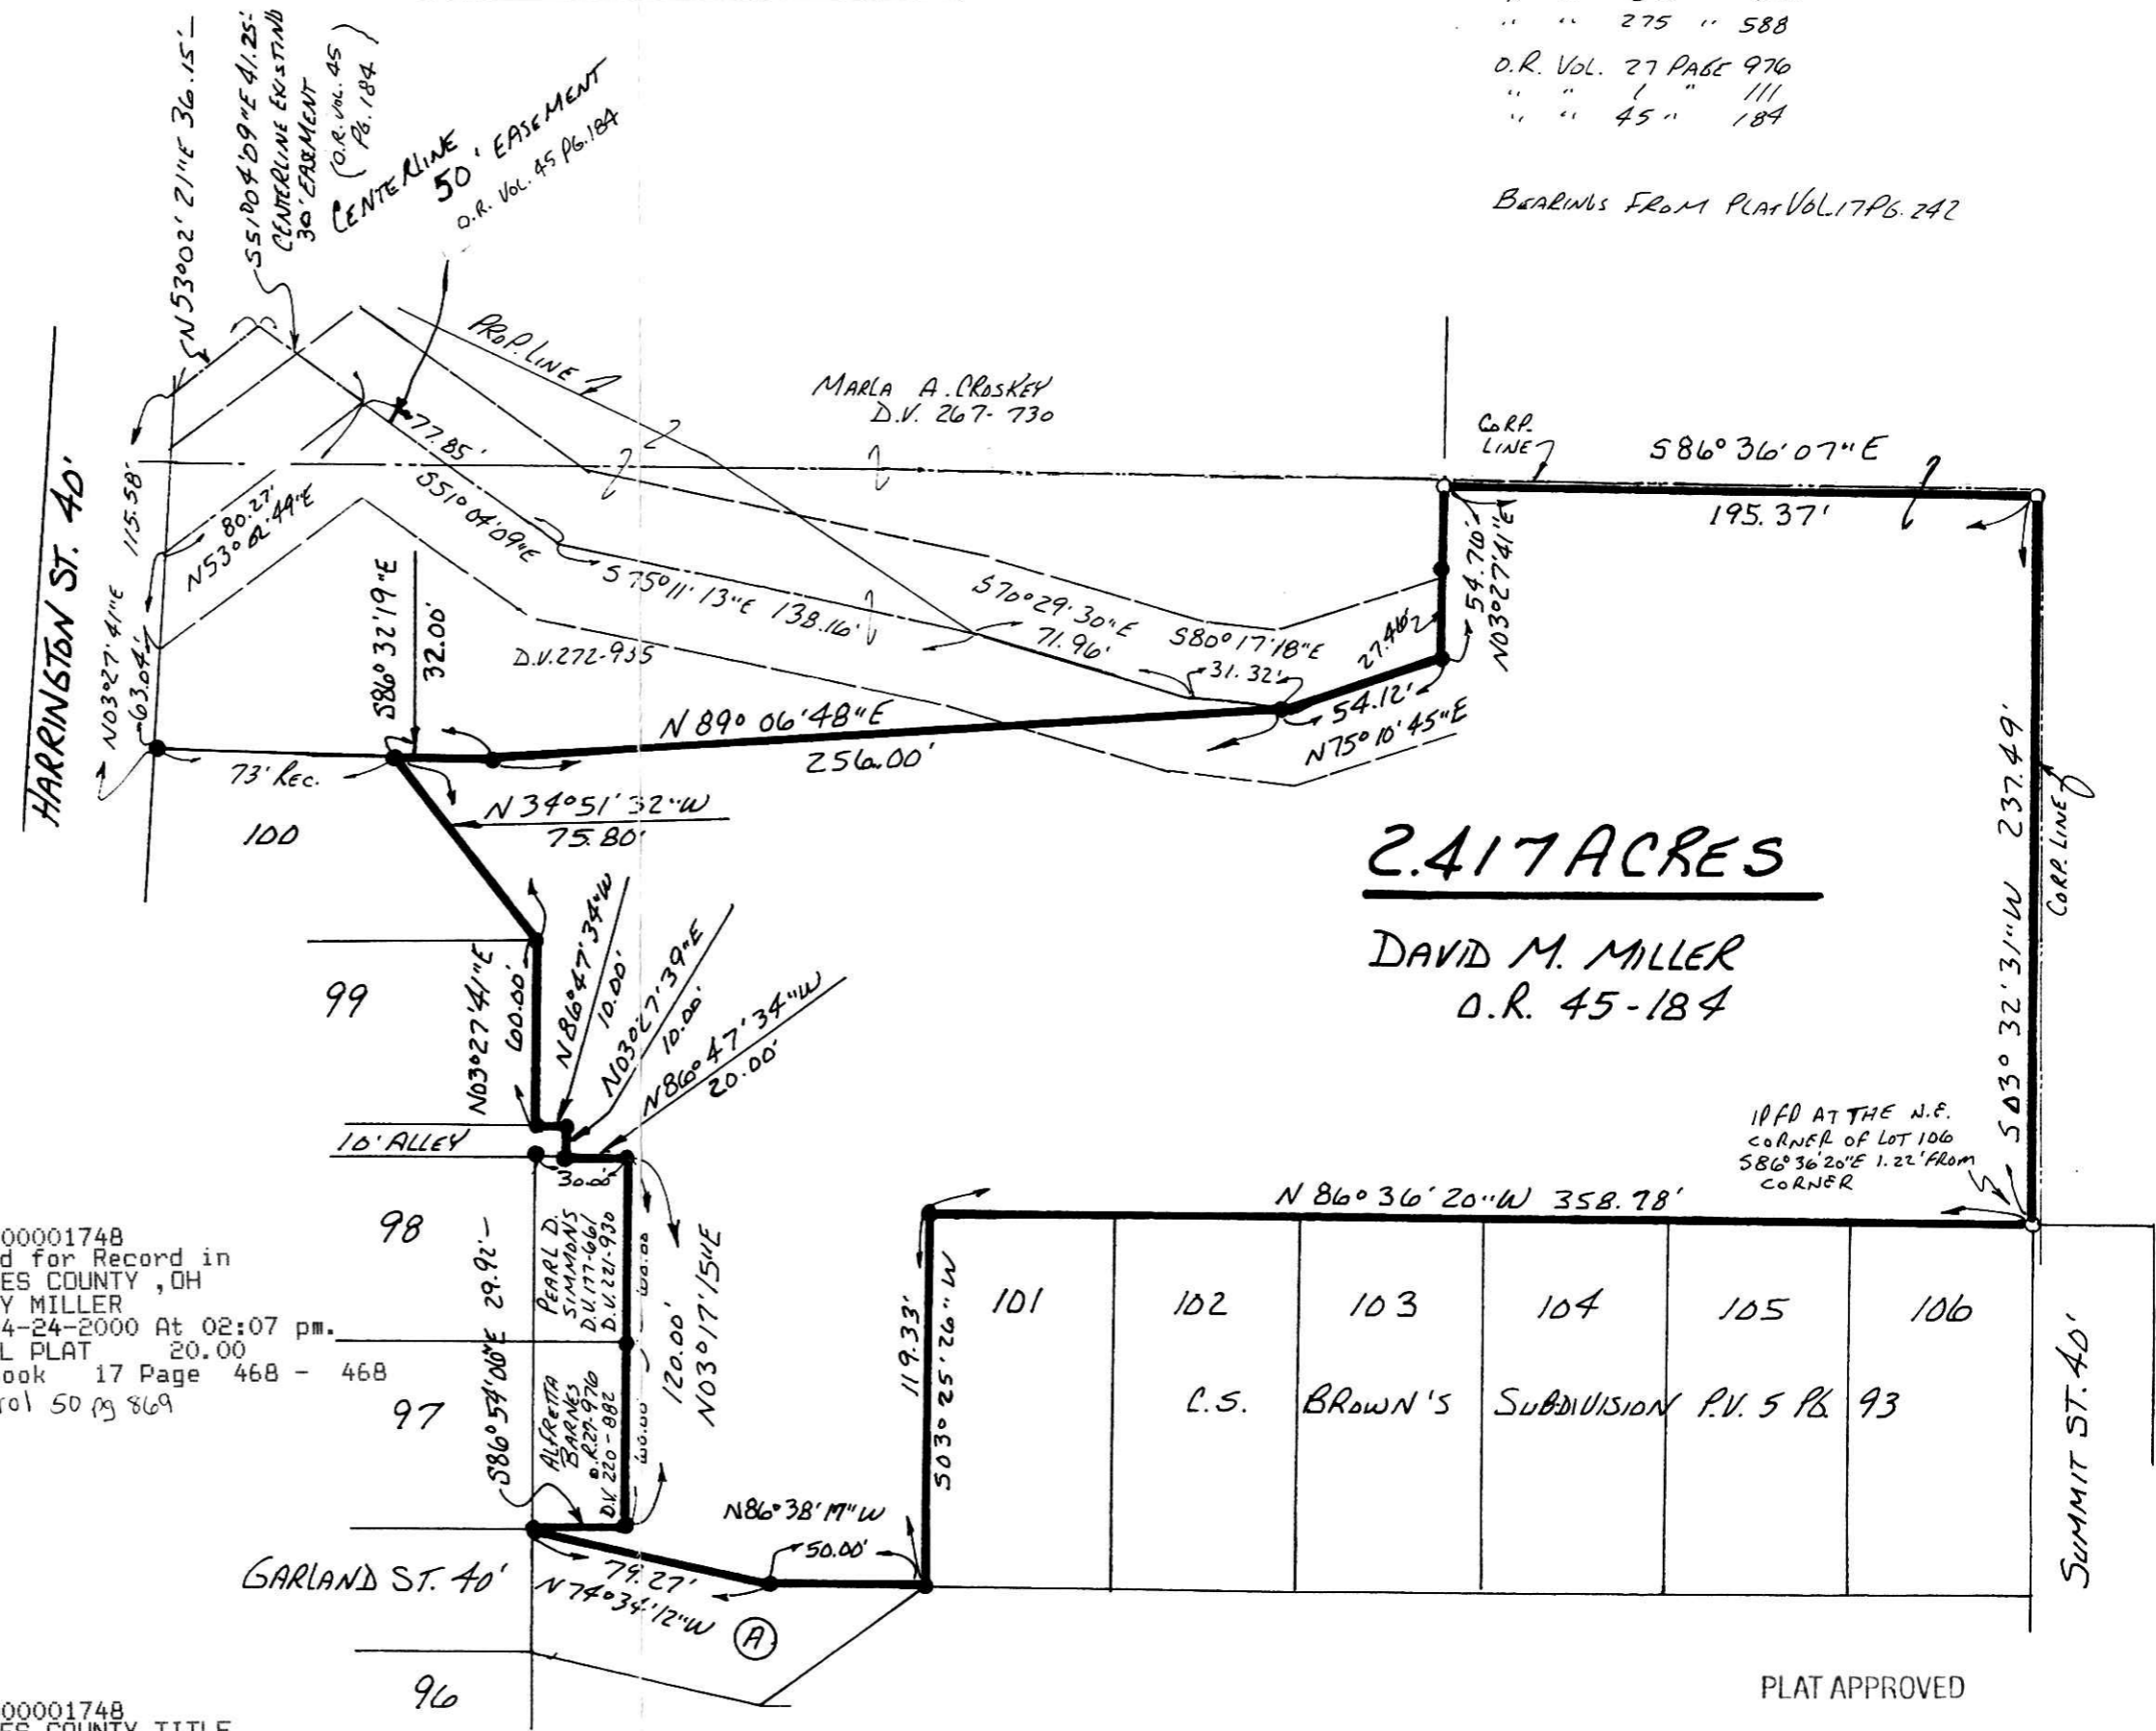

2.417 ACRES

DAVID M. MILLER
 O.R. 45-184

IPFD AT THE N.E.
 CORNER OF LOT 106
 586°36'20"E 1.22' FROM
 CORNER

200000001748
 Filed for Record in
 HOLMES COUNTY, OH
 SALLY MILLER
 On 04-24-2000 At 02:07 pm.
 SMALL PLAT 20.00
 OR Book 17 Page 468 - 468
 OR vol 50 pg 869

200000001748
 HOLMES COUNTY TITLE
 MILLERSBURG, OH 44654

PLAT APPROVED

4/19/00 Rg