VOL 17 PAGE 543

200 0 200 400 600

GRAPHIC SCALE – FEET 1" = 200'

NORTH

BEARINGS ARE TO AN ASSUMED MERIDIAN AND ARE USED TO DENOTE ANGULAR MEAS. ONLY.

LEGEND:
- □ = STONE FD.
- ● = 5/8" RE-BAR FD. UNLESS NOTED
- • = POINT-OF-DEPARTURE
- ○ = 5/8" X 30" RE-BAR W/PLASTIC I.D. CAP SET
- ⊗ = R/R SPIKE SET
- △ = R/R SPIKE FD.

REFERENCE DOCUMENTS:
TAX MAPS
DEEDS AS SHOWN
SURVEY PLATS:
14/867
15/50

HEARTLAND SURVEYING, INC

Jim Shamp
5210 T.R. 257 MILLERSBURG, OH 44654
PH: 330-674-4698

SURVEY			STATE
MAE KAUFFMAN			OHIO
COUNTY	TWP.	RNG.	TWP.
HOLMES	RIPLEY	14 W	18 N
NORTHEAST QUARTER OF SECTION 25			000411

INDEXED

200000002808
Filed for Record in
HOLMES COUNTY ,OH
SALLY MILLER
On 06-28-2000 At 01:15 pm.
SMALL PLAT 20.00
OR Book 17 Page 543 - 543
OR vol 54 pg 514

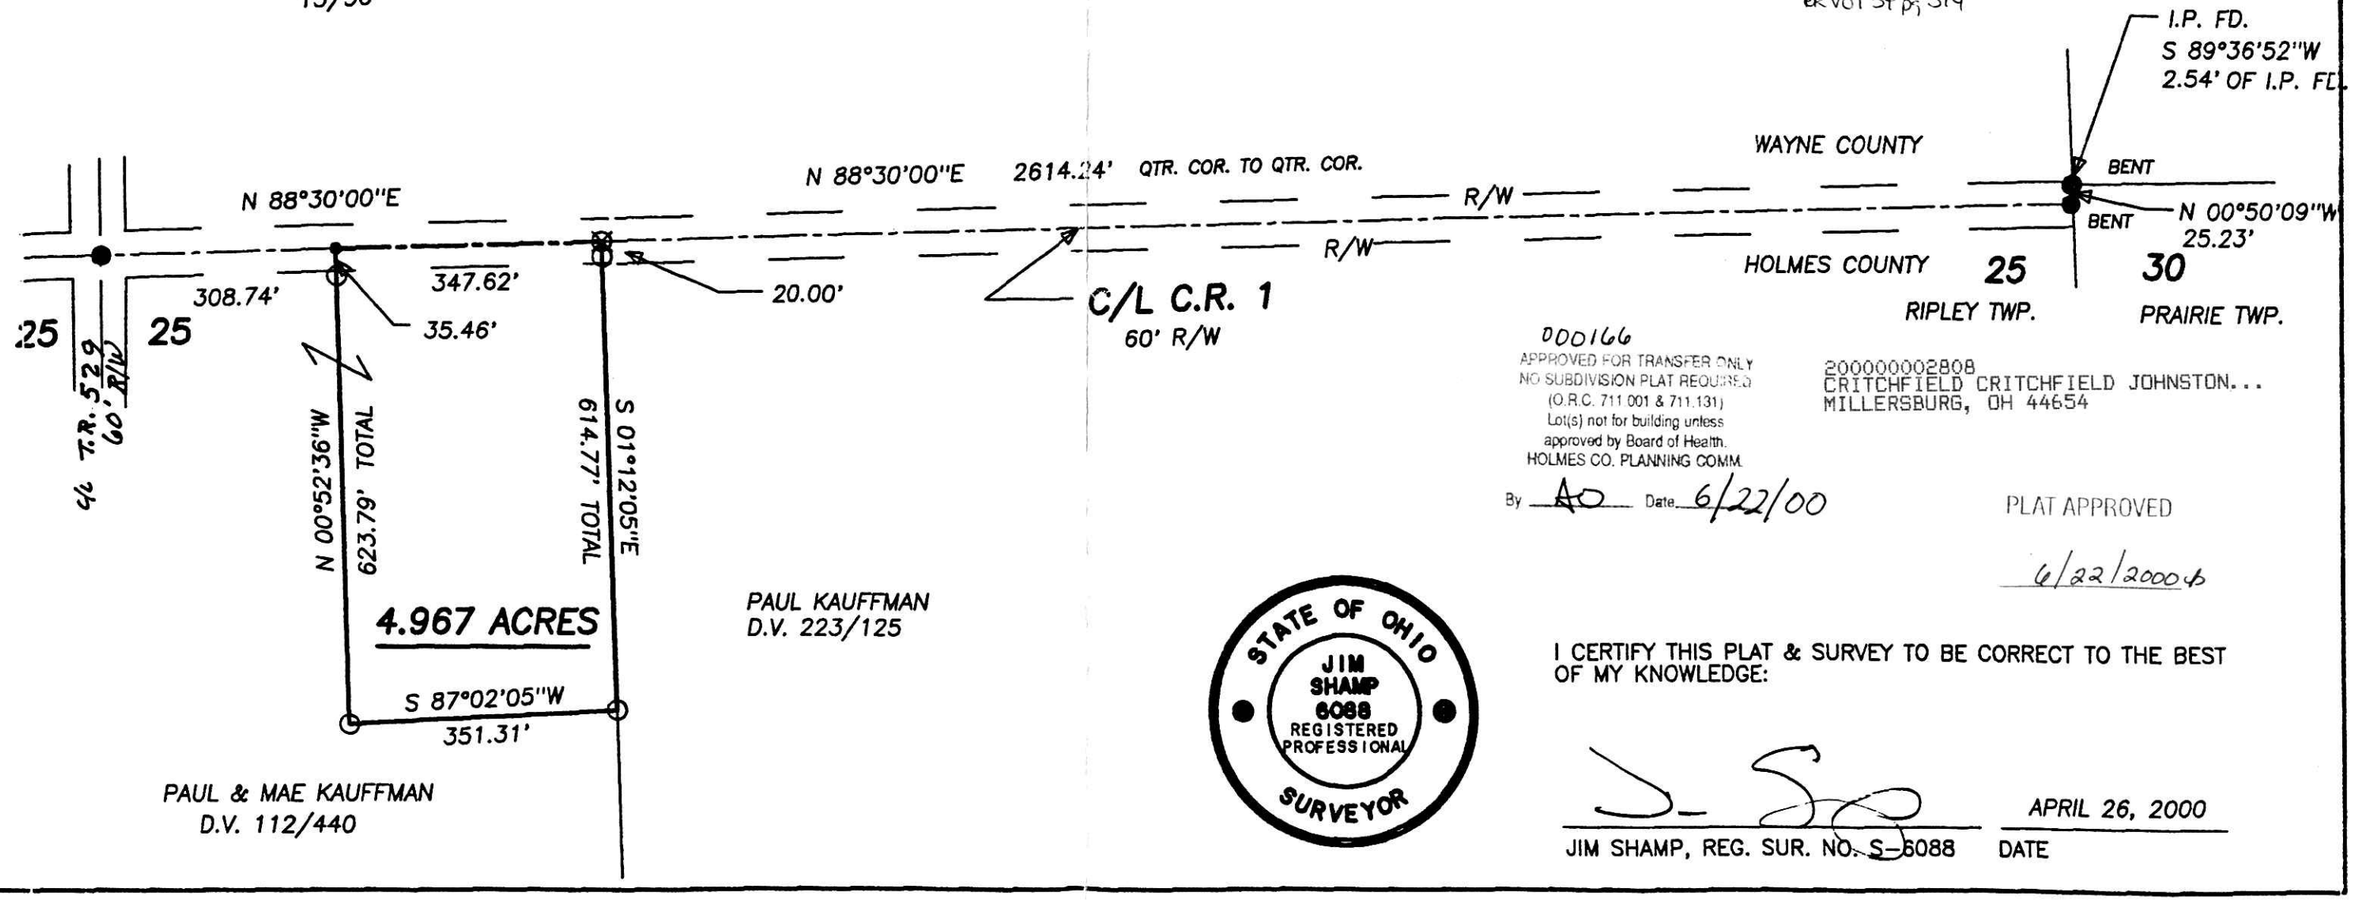

000166
APPROVED FOR TRANSFER ONLY
NO SUBDIVISION PLAT REQUIRED
(O.R.C. 711.001 & 711.131)
Lot(s) not for building unless
approved by Board of Health.
HOLMES CO. PLANNING COMM.
By AO Date 6/22/00

200000002808
CRITCHFIELD CRITCHFIELD JOHNSTON...
MILLERSBURG, OH 44654

PLAT APPROVED
6/22/2000

STATE OF OHIO
JIM SHAMP
6088
REGISTERED PROFESSIONAL
SURVEYOR

I CERTIFY THIS PLAT & SURVEY TO BE CORRECT TO THE BEST OF MY KNOWLEDGE:

JIM SHAMP, REG. SUR. NO. S-6088 — APRIL 26, 2000 DATE