


20000003661
Filed for Record in
HOLMES COUNTY, OH
SALLY MILLER
On 08-23-2000 At 03:23 pm.
PLAT MED 21.60
OR Book 17 Page 607 - 607
OR vol 57 pg 352
LVOL 17 PAGE 607

REFERENCES:

- DEED VOL. 203 P. 81
- DEED VOL. 252 P. 368
- DEED VOL. 254 P. 91
- DEED VOL. 254 P. 450
- DEED VOL. 216 P. 43
- DEED VOL. 207 P. 253
- DEED VOL. 274 P. 569
- DEED VOL. 258 P. 613
- O.R. VOL. 45 P. 171
- O.R. VOL. 4 P. 943
- PLAT VOL. 14 P. 34
- PLAT VOL. 12 P. 720
- PLAT VOL. 12 P. 833
- PLAT VOL. 14 P. 447
- PLAT VOL. 7 P. 160
- PLAT VOL. 8 P. 842
- PLAT VOL. 8 P. 484
- PLAT VOL. 14 P. 354
- PLAT VOL. 16 P. 172
- PLAT VOL. 12 P. 862
- PLAT VOL. 14 P. 133

SURVEYED FOR LEVI STUTZMAN
BEARINGS FROM PLAT VOL. 12 PAGE 862

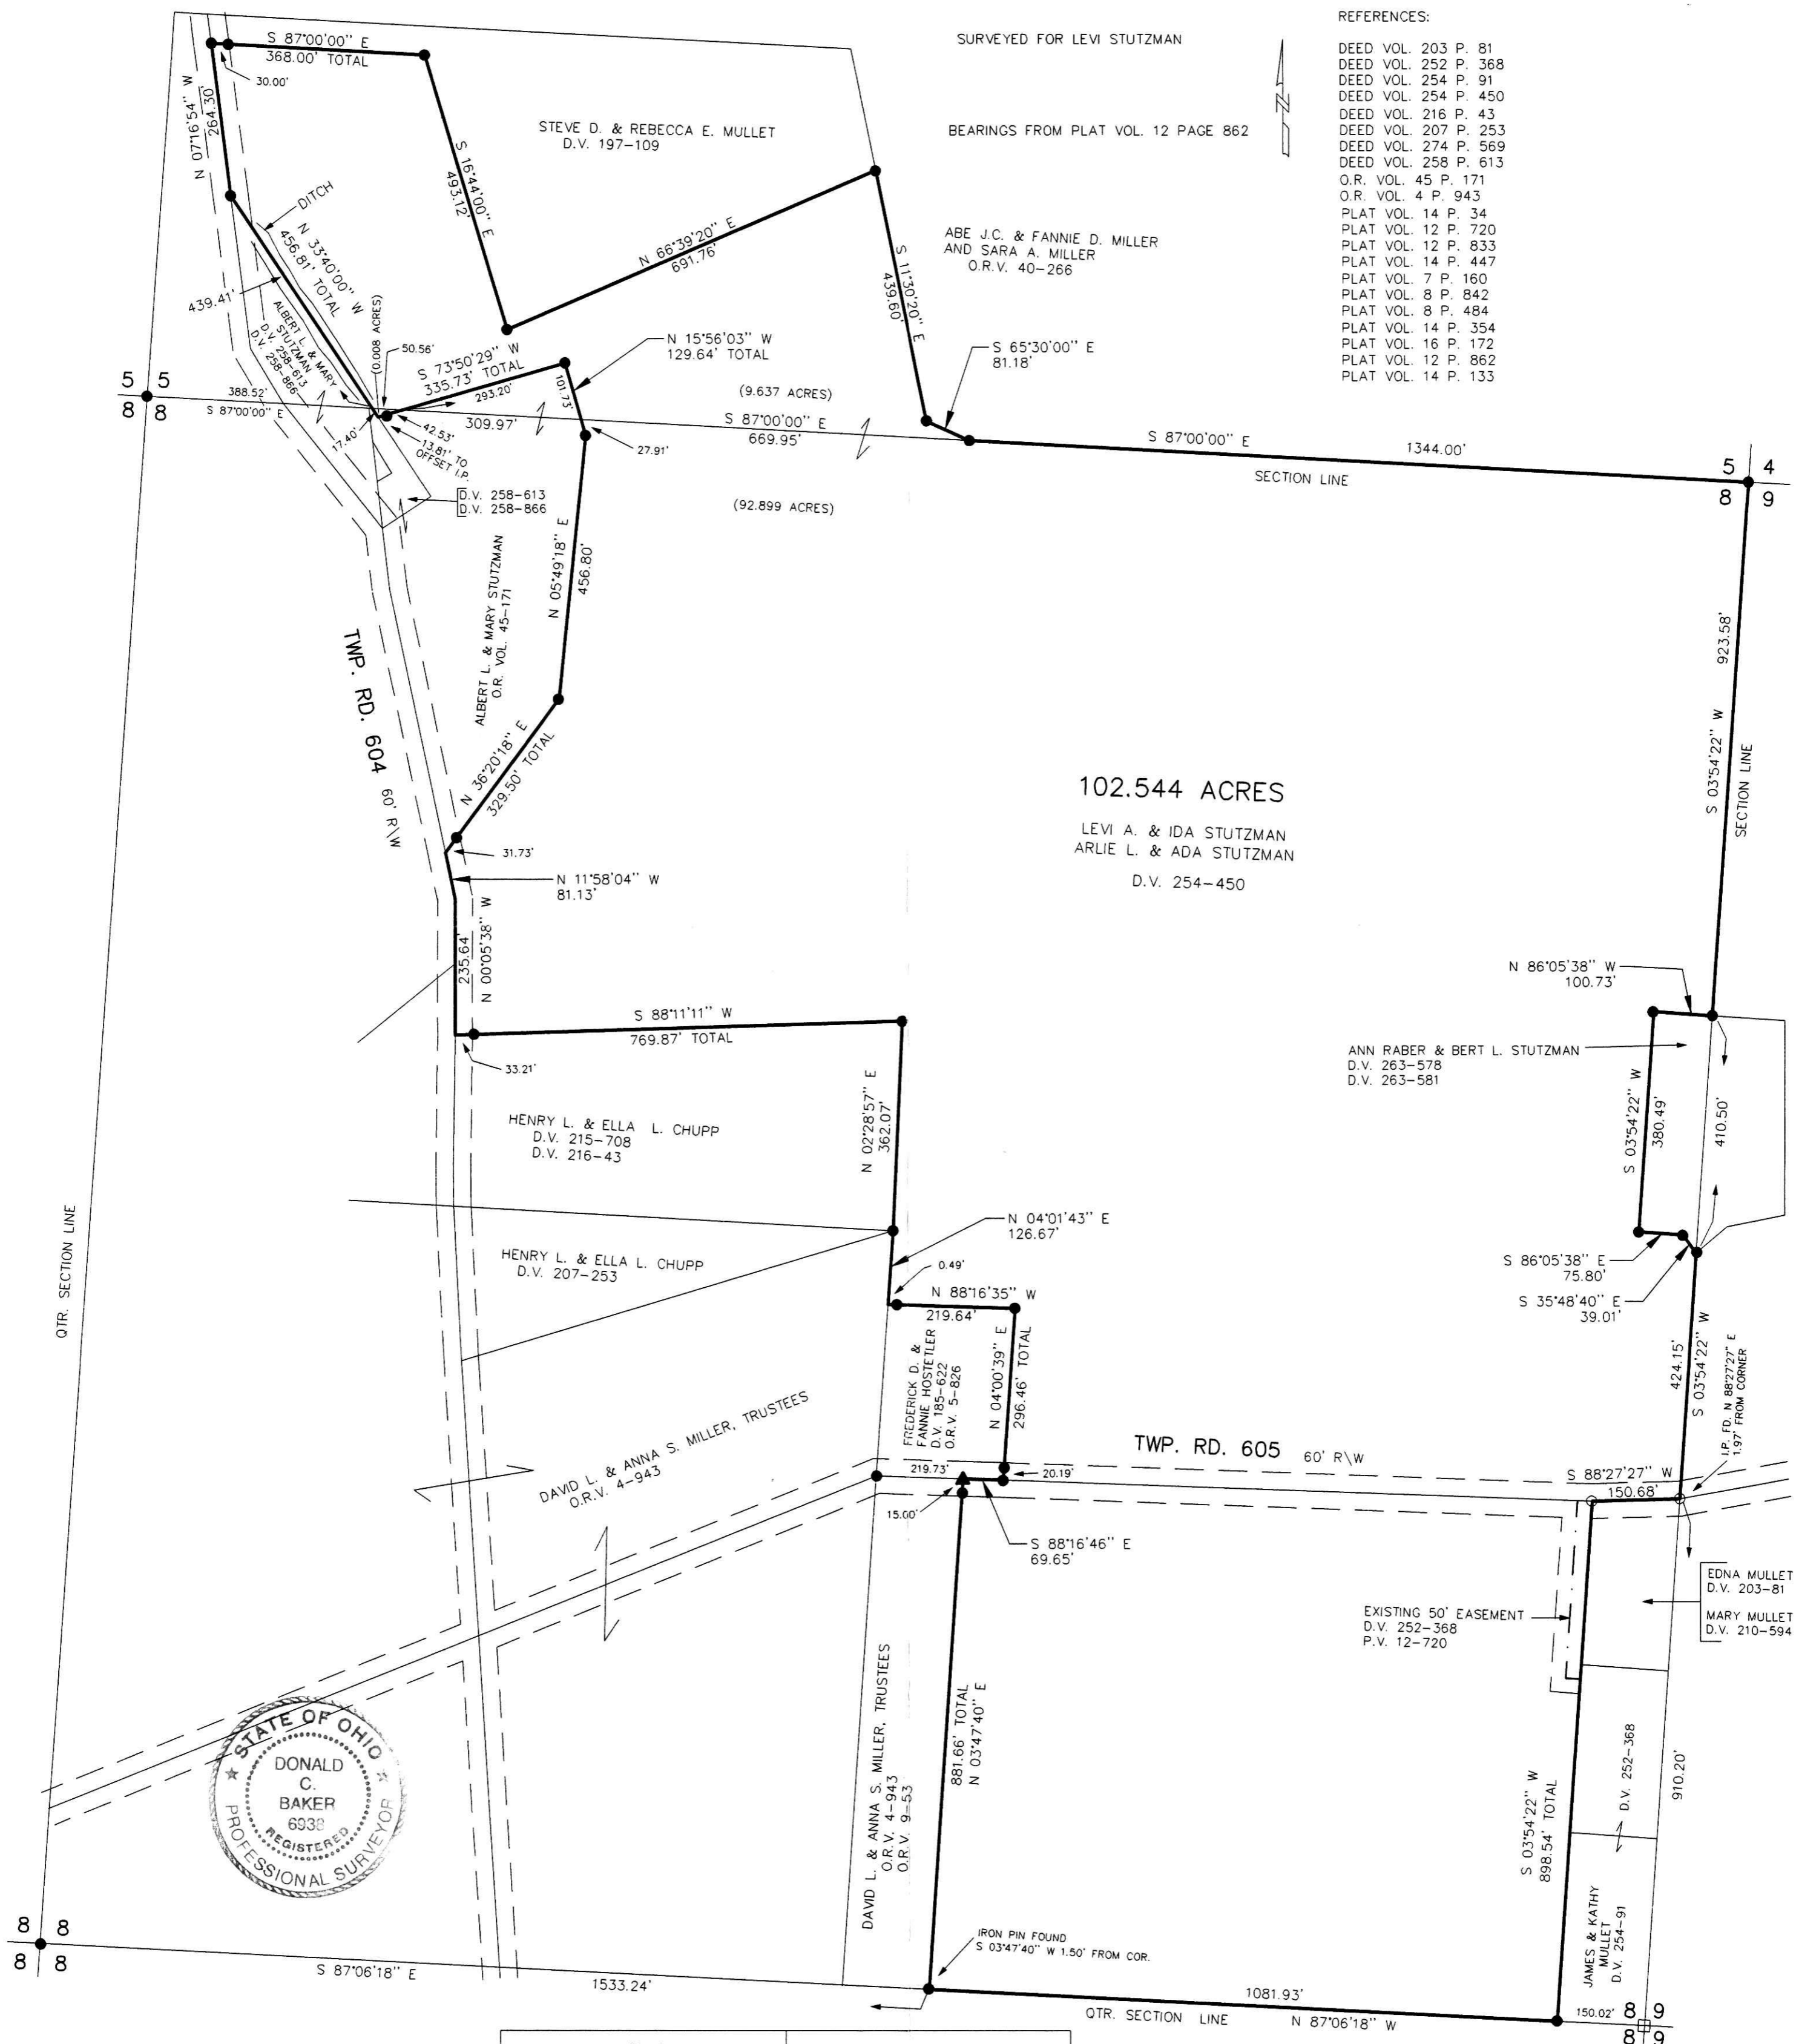

102.544 ACRES

LEVI A. & IDA STUTZMAN
ARLIE L. & ADA STUTZMAN
D.V. 254-450




I CERTIFY THIS SURVEY TO BE CORRECT
TO THE BEST OF MY KNOWLEDGE.

Donald C. Baker
DONALD C. BAKER PS 6938
DATE: MAY 11, 2000

- IRON PIN FOUND
- 5/8" REBAR WITH I.D. CAP SET
I.D. CAP MARKED "BAKER 6938"
- ▲ R.R. SPIKE FOUND
- △ R.R. SPIKE SET
- STONE FOUND

SALT CREEK TOWNSHIP
N.E. QTR. SECTION 8
S.E. QTR. SECTION 5
T-14 N; R-12 W
HOLMES COUNTY, OHIO

DONALD C. BAKER SURVEYING
138 N. CLAY ST.
MILLERSBURG, OHIO 44654
PH. 330-674-4788
FAX 330-674-6027

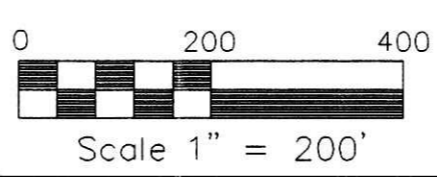

20000003661
PAUL MILLER LAW OFFICE
MILLERSBURG, OH 44654

PLAT APPROVED

8/21/2000