

- IRON PIN FOUND
- 5/8" RE BAR WITH I.D. CAP SET I.D. CAP MARKED "BAKER 6938"

PRAIRIE TOWNSHIP
 N.E. QTR. SECTION 3
 T-13 N; R-13W
 HOLMES COUNTY, OHIO
 (SURVEYED FOR: R. GENE & SUE SMITH)

REFERENCES:
 DEED VOL. 219 PAGE 366
 " " 128 " 298
 " " 281 " 545

P.V. 6 PL. 113
 " 15 " 154
 " 12 " 439
 " 7 " 515

BEARINGS FROM DEED
 VOL. 128 PAGE 298.

200000003806
 Filed for Record in
 HOLMES COUNTY, OH
 SALLY MILLER
 On 08-31-2000 At 04:08 pm.
 SMALL PLAT 20.00
 OR Book 17 Page 620 - 620
 OR vol 57 pgs 872 + 874

INDEXED


000241 000242
 APPROVED FOR TRANSFER ONLY
 NO SUBDIVISION PLAT REQUIRED
 (O.R.C. 711.001 & 711.131)
 Lot(s) not for building unless
 approved by Board of Health,
 HOLMES CO. PLANNING COMM

By AO Date 8/22/00

200000003806
 LAUREL J
 SCHMID ATTY
 MILLERSBURG,



R. GENE SMITH TRUST 1/2
 SUE E. SMITH TRUST 1/2
 O. R. 45-927

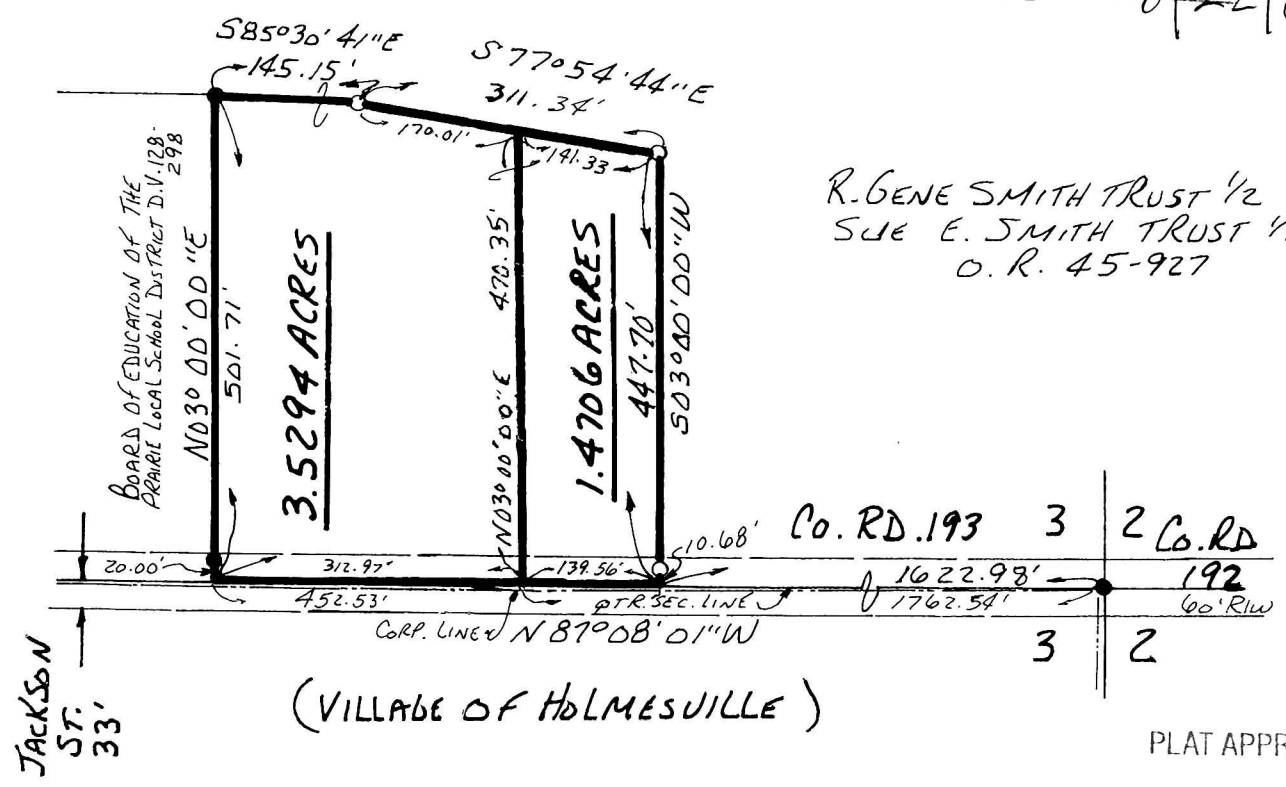

I CERTIFY THIS SURVEY TO BE CORRECT
 TO THE BEST OF MY KNOWLEDGE.

Donald C. Baker
 DONALD C. BAKER P.S. 6938
 DONALD C. BAKER SURVEYING
 138 N. CLAY ST.
 MILLERSBURG, OHIO 44654
 PH. (330) 674-4788

MAY 4, 2000 #26800 - M.L. DAVIS
 REVISED JULY 31, 2000 F.C.C. - F.D. BAKER

PLAT APPROVED

8/22/2000.B