


RICHLAND TOWNSHIP
N. W. QTR. SECTION 17
T. 8 N; R. 9 W
HOLMES COUNTY, OHIO
 (SURVEYED FOR: KENNY BEGS)

REFERENCES:
 DEED VOL. 236 PAGE 409
 " " 138 " 165
 O.R. VOL. 5 PAGE 849
 PLAT VOL. 10 PAGE 148

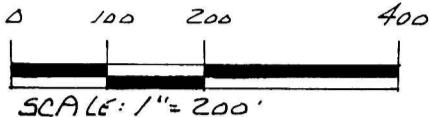


- STONE FOUND
- IRON PIN FOUND
- 5/8" REBAR WITH I.D. CAP SET
I.D. CAP MARKED "BAKER 6938"

BEARINGS FROM PLAT VOL. 17
 PAGE 34.

2000000003820
 Filed for Record in
 HOLMES COUNTY, OH
 SALLY MILLER
 On 09-01-2000 At 03:48 pm.
 SMALL PLAT 20.00
 OR Book 17 Page 622 - 622
 CR vol 57 pg 927

INDEXED

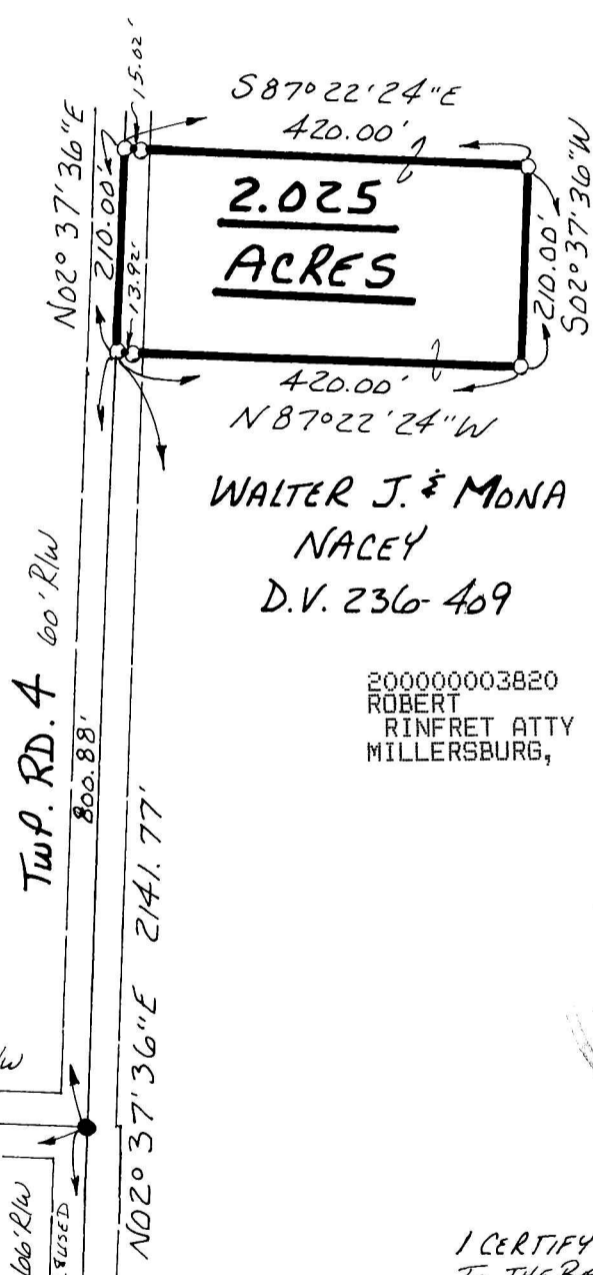

**WALTER J. & MONA
 NACEY**
 D.V. 236-409

2000000003820
 ROBERT
 RINFRET ATTY
 MILLERSBURG,




000247
 APPROVED FOR TRANSFER ONLY
 NO SUBDIVISION PLAT REQUIRED
 (O.R.C. 711.001 & 711.131)
 Lot(s) not for building unless
 approved by Board of Health.
 HOLMES CO. PLANNING COMM.
 By AD Date 9/1/00

Twsp. Rd. 4 60' R/W
 Twsp. Rd. 13 66' R/W
 DANE &
 CLARA WEAVER
 RAYMOND E. &
 FANNIE D.
 YODER
 O.R. 28-68

I CERTIFY THIS SURVEY TO BE CORRECT
 TO THE BEST OF MY KNOWLEDGE.

J. D. Darr
 JAMIE D. DARR P.S. 7755
 DONALD C. BAKER SURVEYING
 138 N. CLAY ST.
 MILLERSBURG, OHIO 44654
 PH. (330) 674-4788
 MARCH 27, 2000

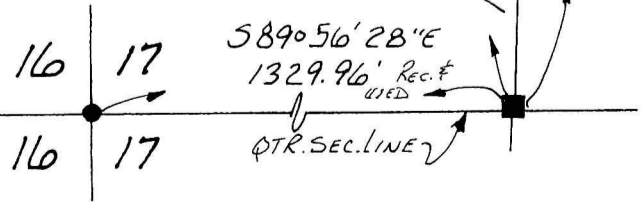

#13500-M.L.DAVIS
 F.C.C.-J.D.DARR

PLAT APPROVED

9/1/00 RZ