


MECHANIC TOWNSHIP
 2ND. QTR. LOT 21
 T-8N; R-6W
 HOLMES COUNTY, OHIO
 (SURVEYED FOR: ANDY ERB)

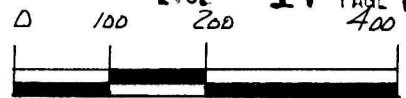

SCALE: 1" = 200'

- IRON PIN FOUND
- 5/8" REBAR WITH I.D. CAP SET
 I.D. CAP MARKED "BAKER 6938"


REFERENCES:

DEED Vol. 280 PAGE 725
 " " 186 " 526
 O.R. Vol. 60 PAGE 837

BEARINGS FROM PLAT Vol. 16
 PAGE 104.

200100006061
 Filed for Record in
 HOLMES COUNTY, OH
 SALLY MILLER
 01-16-2001 01:35 pm.
 SMALL PLAT 20.00
 OR Book 17 Page 760 - 760
 OR vol 65 ps 770

INDEXED

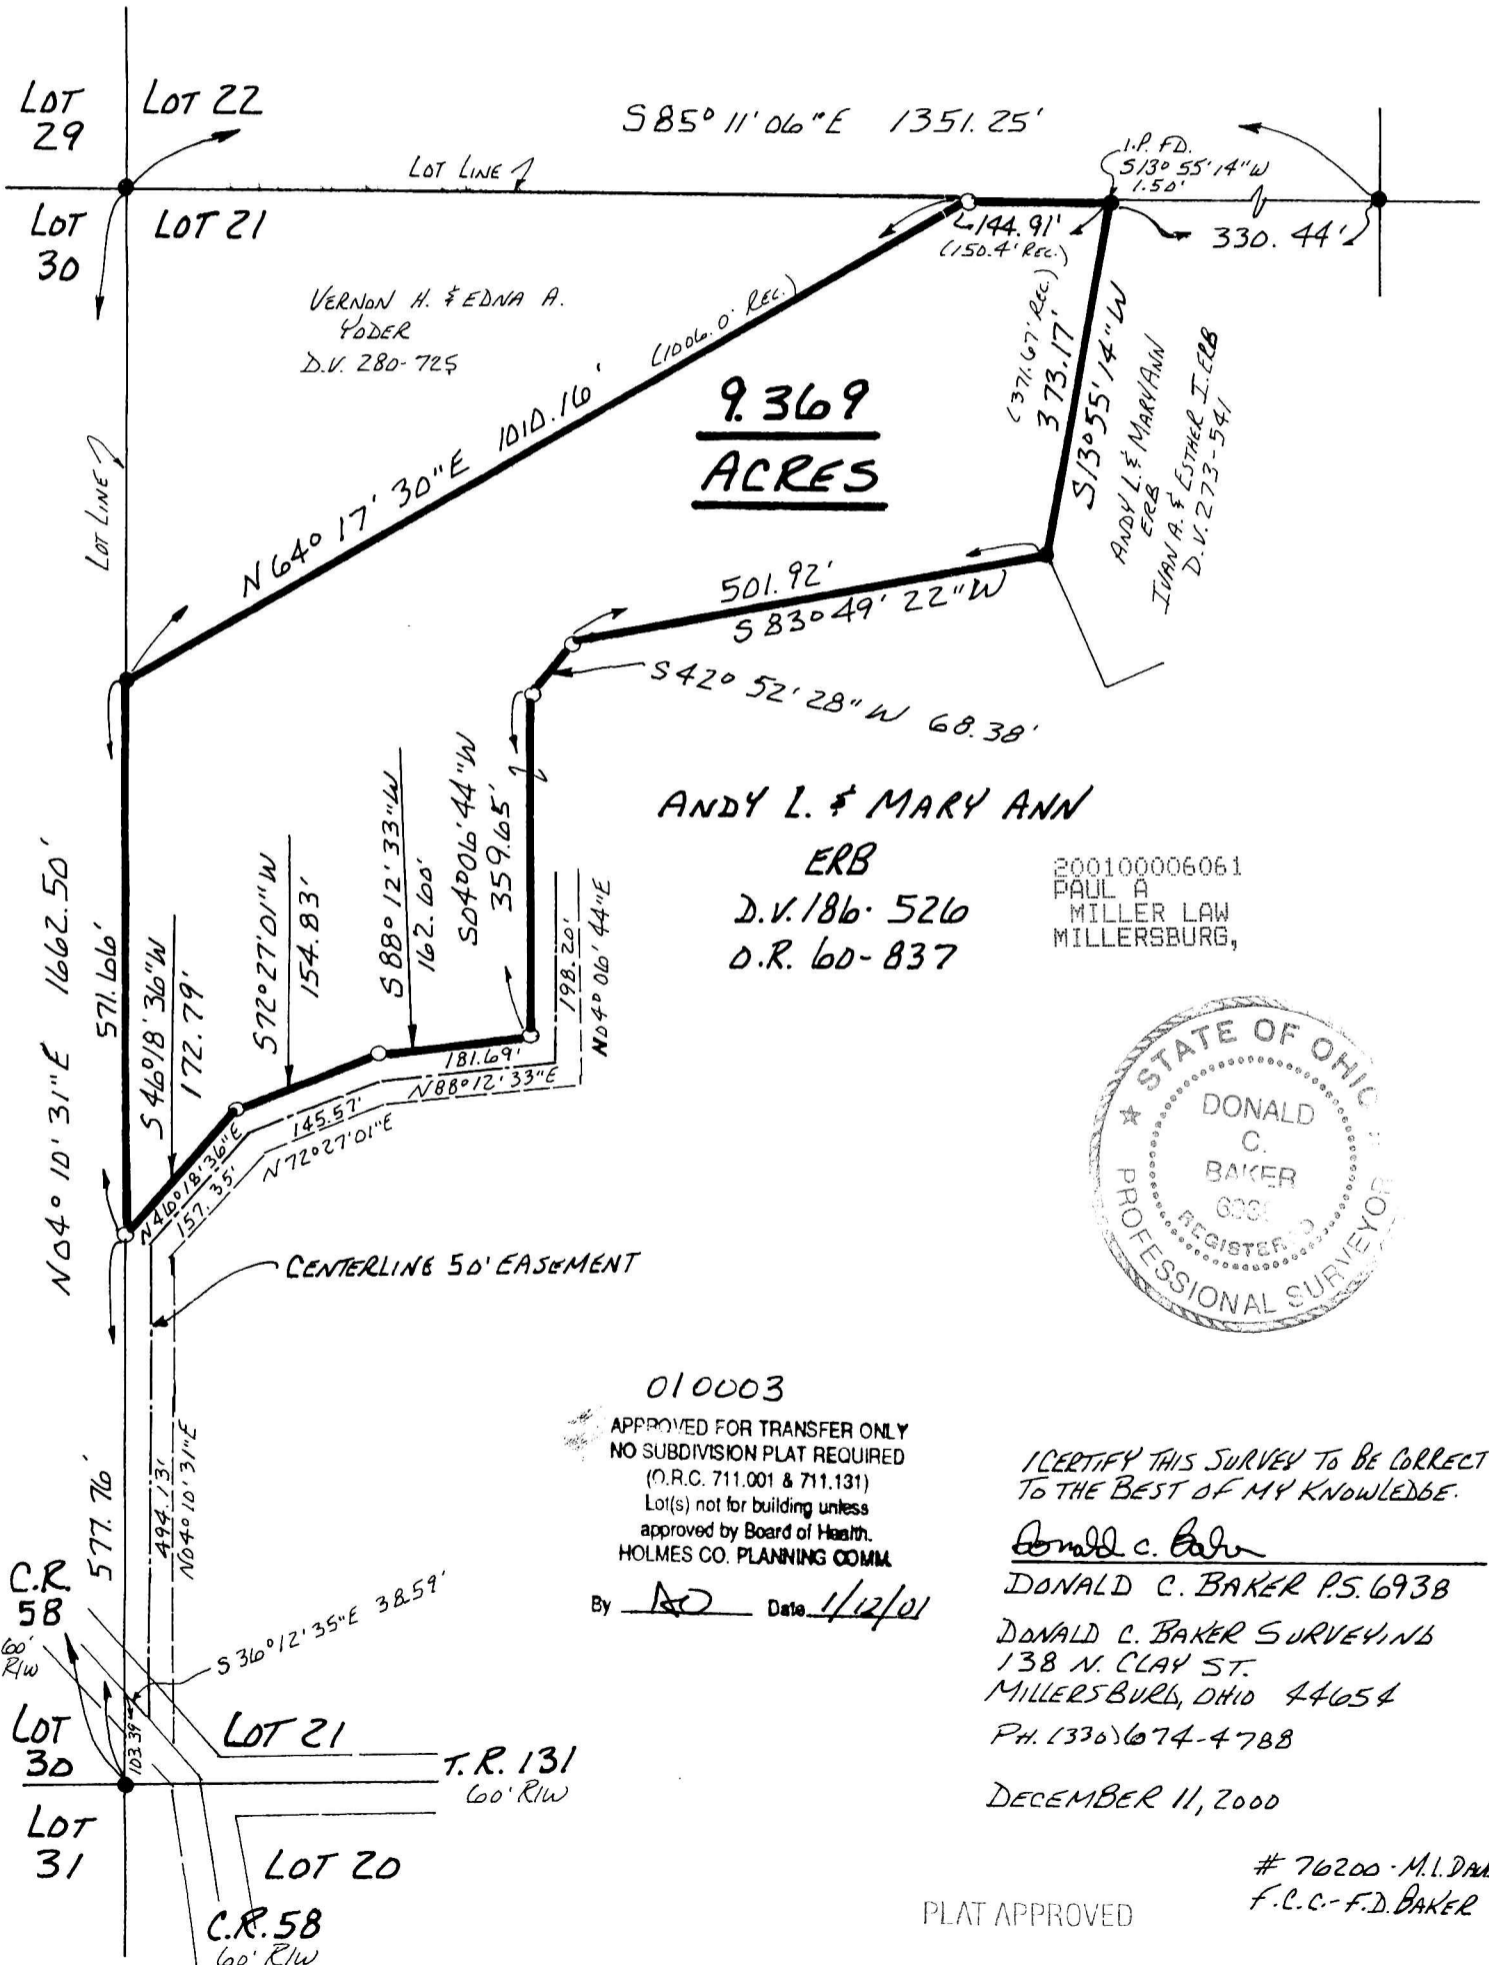

**9.369
 ACRES**

**ANDY L. & MARY ANN
 ERB**
 D.V. 186-526
 O.R. 60-837

200100006061
 PAUL A.
 MILLER LAW
 MILLERSBURG,



010003

APPROVED FOR TRANSFER ONLY
 NO SUBDIVISION PLAT REQUIRED
 (O.R.C. 711.001 & 711.131)
 Lot(s) not for building unless
 approved by Board of Health.
 HOLMES CO. PLANNING COMM.

By AD Date 1/12/01

I CERTIFY THIS SURVEY TO BE CORRECT
 TO THE BEST OF MY KNOWLEDGE.

Donald C. Baker

DONALD C. BAKER P.S. 6938

DONALD C. BAKER SURVEYING
 138 N. CLAY ST.
 MILLERSBURG, OHIO 44654
 PH. (330) 674-4788

DECEMBER 11, 2000

76200 - M.L. DAVIS
 F.C.C. - F.D. BAKER

PLAT APPROVED

1/12/01