

- STONE FOUND
- ▲ R.R. SPIKE FOUND
- IRON PIN FOUND
- 5/8" RE BAR WITH I.D. CAP SET
I.D. CAP MARKED "BAKER 6938"



SALT CREEK TOWNSHIP
 4TH. QTR. LOT 6
 T-10N; R-6W
 HOLMES COUNTY, OHIO
 (SURVEYED FOR: CHRIST JR. & BETTY MILLER)

REFERENCES:
 DEED VOL. 101 PAGE 1
 " " 257 " 474
 " " 228 " 933

200100009304
 HOLMES COUNTY TITLE
 MILLERSBURG, OH 44654

BEARINGS FROM PLAT VOL. 14 PAGE 880

200100009304
 Filed for Record in
 HOLMES COUNTY, OH
 SALLY MILLER
 07-11-2001 11:14 am.
 SMALL PLAT 20.00
 OR Book 18 Page 13 - 13
 off Rec 81 Page 216

INDEXED




I CERTIFY THIS SURVEY TO BE CORRECT
 TO THE BEST OF MY KNOWLEDGE.

Jamie D. Darr
 JAMIE D. DARR P.S. 7755
 DONALD C. BAKER SURVEYING
 138 N. CLAY ST.
 MILLERSBURG, OHIO 44654
 PH. 330-674-4788
 JUNE 14, 2001

#44901 - M.L. DAVIS
 F.C.C. - J.D. DARR

PLAT APPROVED
 7/3/2001 DEJ

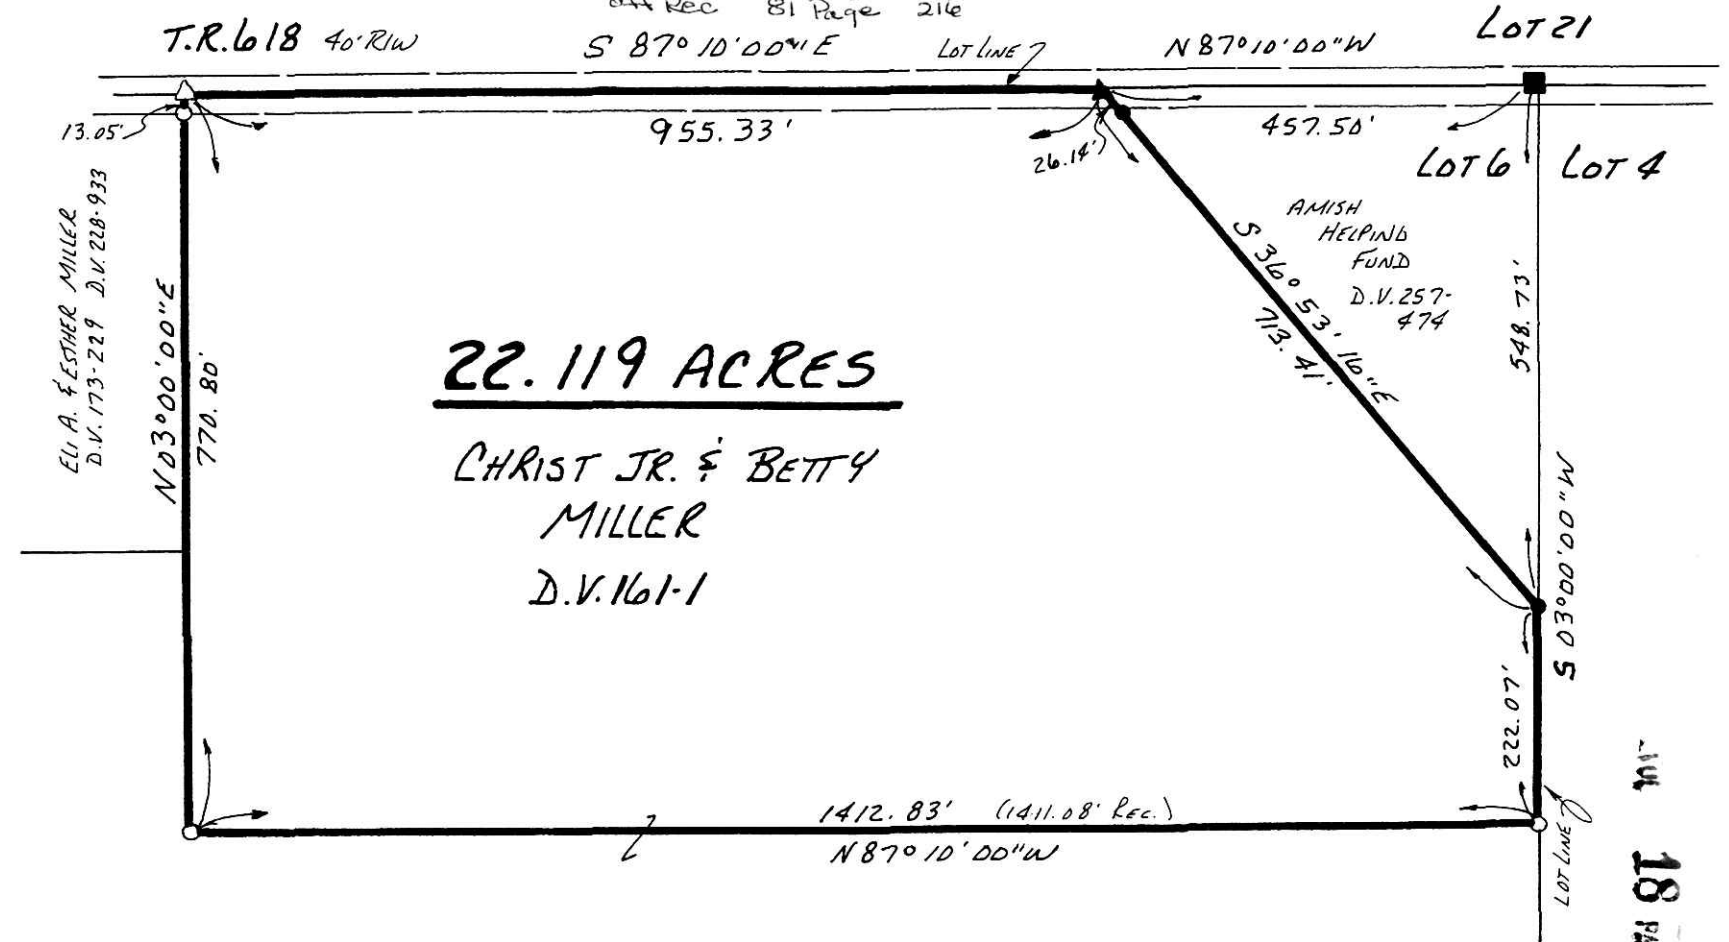

200100009304
 HOLMES COUNTY TITLE
 MILLERSBURG, OH 44654