


REFERENCES:


DEED VOL. 215 P. 537
 DEED VOL. 282 P. 7
 DEED VOL. 271 P. 765
 DEED VOL. 254 P. 76
 DEED VOL. 262 P. 863

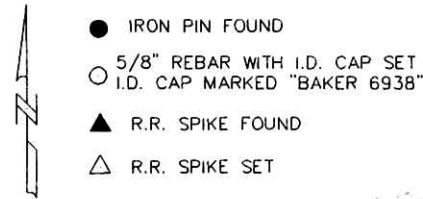

PLAT VOL. 15 P. 155

BEARINGS FROM PLAT VOL. 15 PAGE 155

18 PAGE 166

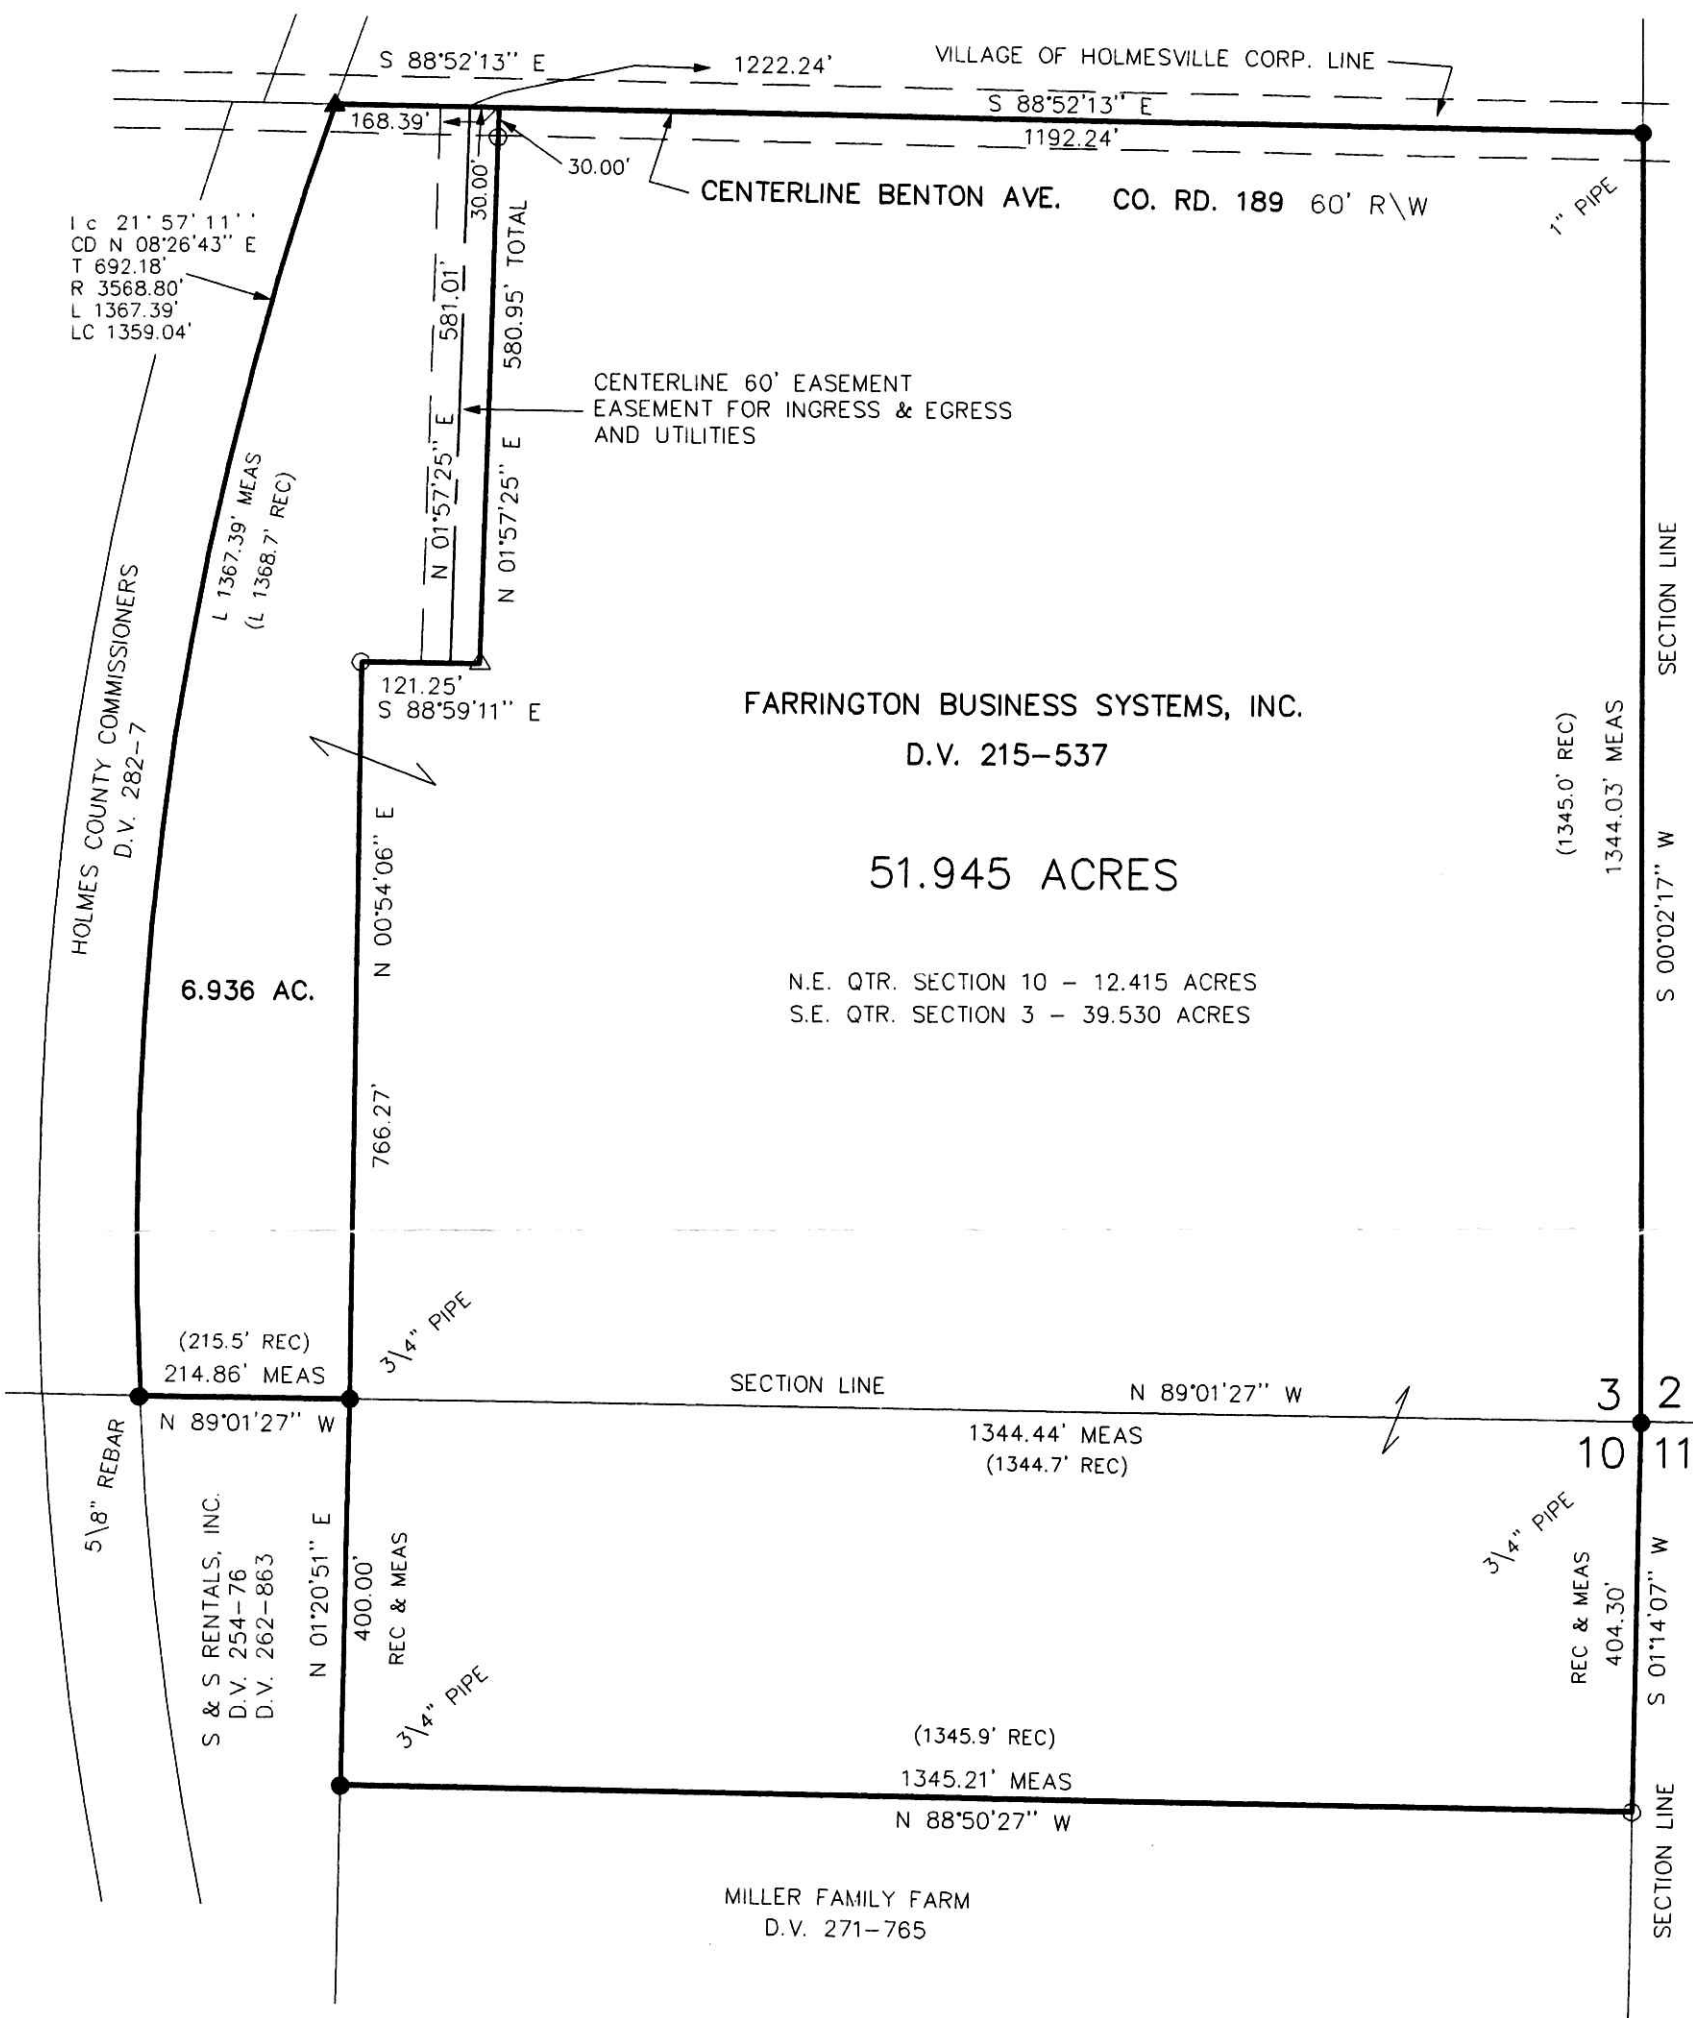

200100012567
 Filed for Record in
 HOLMES COUNTY, OH
 SALLY MILLER
 12-27-2001 03:59 pm.
 SMALL PLAT 20.00
 OR Book 18 Page 166 - 166
 or vol 17 pg 727



I CERTIFY THIS SURVEY TO BE CORRECT TO THE BEST OF MY KNOWLEDGE.

Donald C Baker
 DONALD C. BAKER PS 6938
 138 N. CLAY ST.
 MILLERSBURG, OHIO 44654
 PH. (330) 674-4788

PLAT APPROVED
 12/21/2001

200100012567
 LAUREL J
 SCHMID ATTY
 MILLERSBURG,

DEC. 18, 2001 S1079-01

<p>DONALD C. BAKER SURVEYING 138 N. CLAY ST. MILLERSBURG, OHIO 44654 PH. 330-674-4788 FAX 330-674-6027</p>	<p>0 200 400 Scale 1" = 200'</p>	<p>PRAIRIE TOWNSHIP N.E. QTR. SECTION 10 S.E. QTR. SECTION 3 T-13 N; R-13 W HOLMES COUNTY, OHIO</p>
--	---	---