


BERLIN TOWNSHIP  
 S.E. QTR. SECTION 4  
 WALNUT CREEK TOWNSHIP  
 S.W. QTR. SECTION 3  
 T- 9 N R- 5 W  
 HOLMES COUNTY, OHIO  
 (SURVEYED FOR DAVID TROYER)


- REFERENCES:  
 DEED VOL. 127 PAGE 223  
 DEED VOL. 128 PAGE 357  
 DEED VOL. 132 PAGE 331  
 DEED VOL. 161 PAGE 525  
 DEED VOL. 162 PAGE 178  
 DEED VOL. 193 PAGE 665  
 DEED VOL. 195 PAGE 148  
 DEED VOL. 197 PAGE 785  
 DEED VOL. 201 PAGE 605  
 DEED VOL. 208 PAGE 647  
 DEED VOL. 235 PAGE 41  
 DEED VOL. 264 PAGES 1 & 188  
 DEED VOL. 272 PAGE 992  
 DEED VOL. 276 PAGE 905  
 O.R. VOL. 4 PAGE 683  
 O.R. VOL. 30 PAGE 261  
 O.R. VOL. 36 PAGE 794  
 O.R. VOL. 96 PAGE 706 & 708  
 BEARINGS FROM PLAT VOL. 18 PAGE 154

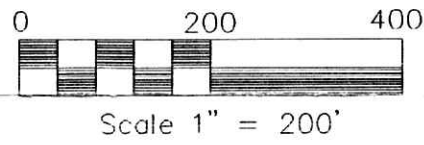

- 5/8" REBAR FOUND UNLESS OTHERWISE NOTED
- ▲ R.R. SPIKE FOUND
- STONE FOUND
- △ R.R. SPIKE SET
- 5/8" REBAR WITH I.D. CAP SET I.D. CAP MARKED "BAKER 6938"



I CERTIFY THIS SURVEY TO BE CORRECT TO THE BEST OF MY KNOWLEDGE.  
*Donald C. Baker*  
 DONALD C. BAKER P.S. 6938  
 FDB/ FCC DATE JAN. 28, 2002  
 File name: C:\JOBST\S-62-02\ERZ

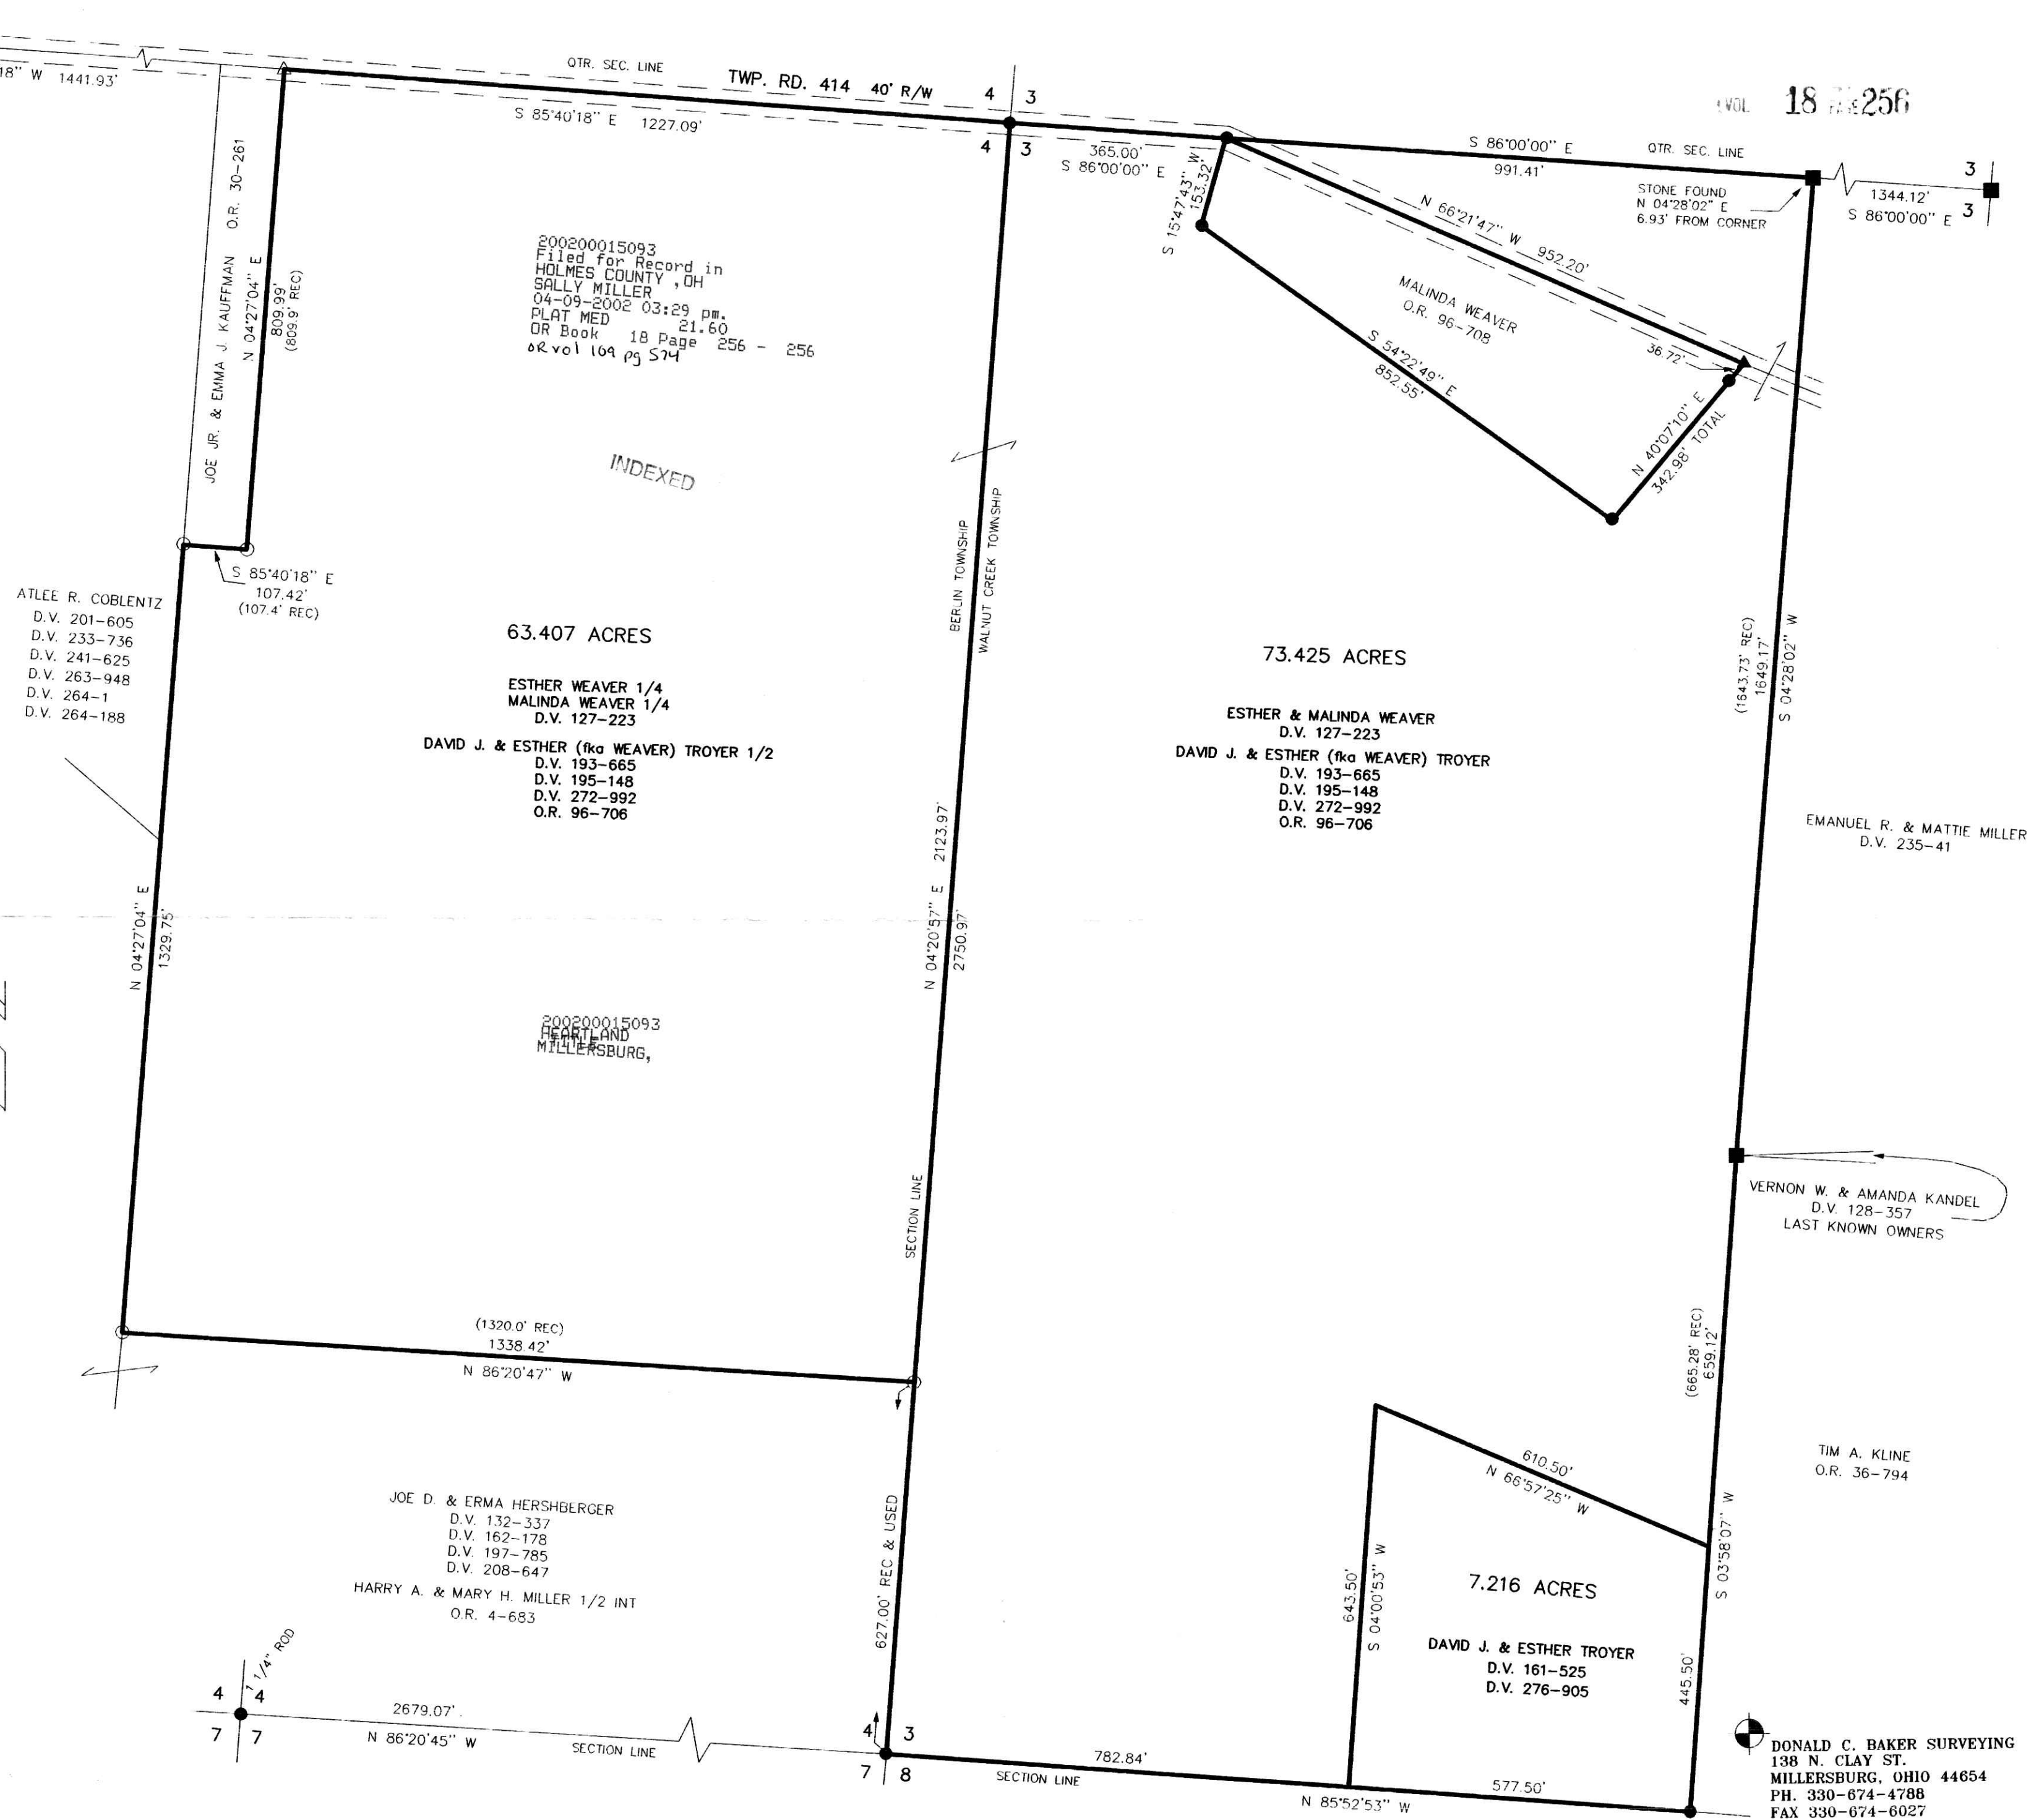

VOL 18 PAGE 256

PLAT APPROVED  
 3/20/2002

DONALD C. BAKER SURVEYING  
 138 N. CLAY ST.  
 MILLERSBURG, OHIO 44654  
 PH. 330-674-4788  
 FAX 330-674-6027