

**BERLIN TOWNSHIP
4TH. QTR., LOT 7
T-9 N; R-6 W
HOLMES COUNTY, OHIO**

SURVEYED FOR: DENNIS J. MILLER

200300021718
Filed for Record in
HOLMES COUNTY, OH
SALLY MILLER
03-04-2003 02:36 pm.
SMALL PLAT 20.00
OR Book 18 Page 542 - 542
OR vol 140 pg 810

REFERENCES:


DEED VOL. 232 PAGE 661
DEED VOL. 235 PAGE 400

PLAT VOL. 11 PAGE 95
PLAT VOL. 16 PAGE 249


BEARINGS FROM PLAT VOL. 17 PAGE 293

200300021718
PAUL A
MILLER LAW
MILLERSBURG,

DENNIS J. & CLARIE D. MILLER
D.V. 232-661

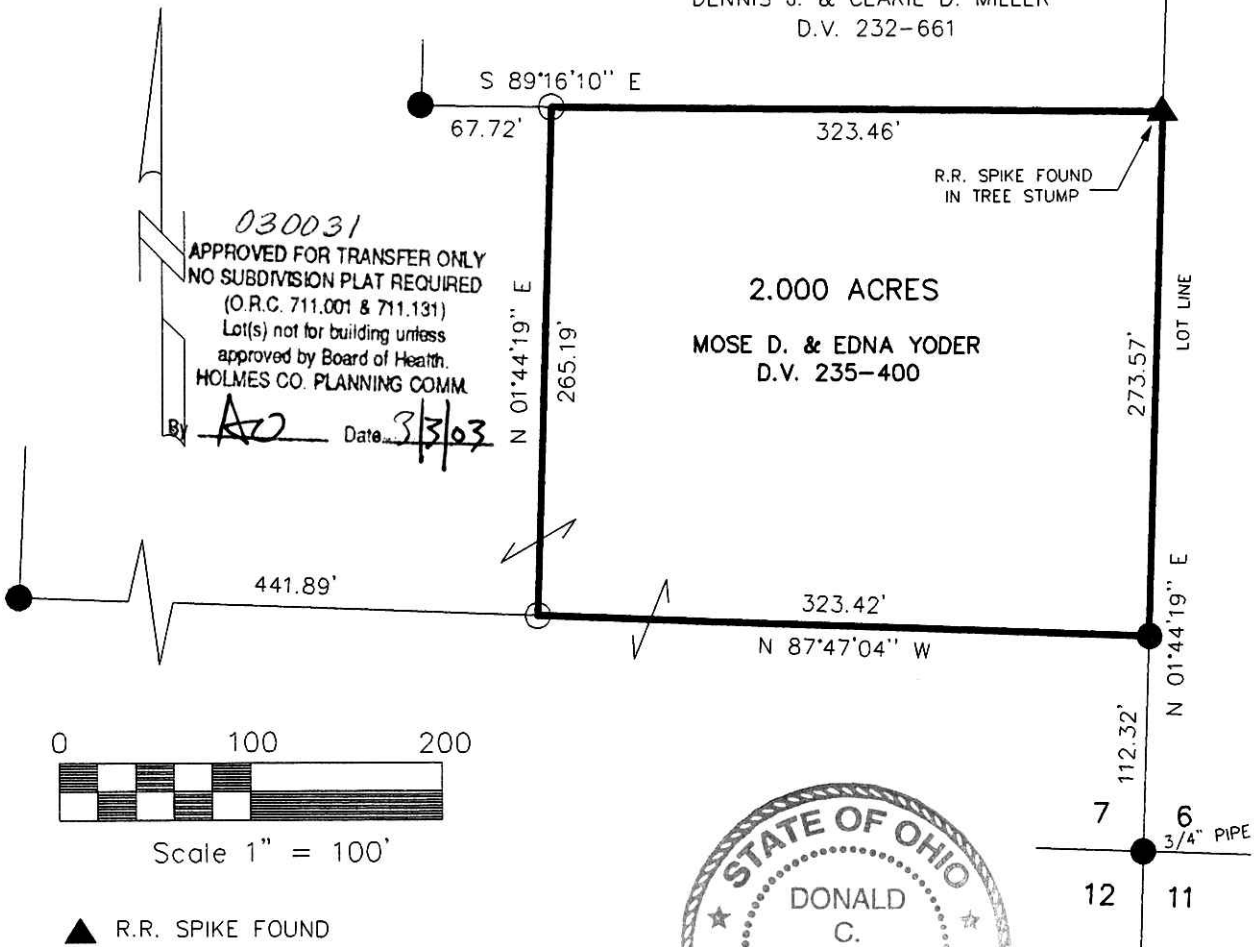

030031
APPROVED FOR TRANSFER ONLY
NO SUBDIVISION PLAT REQUIRED
(O.R.C. 711.001 & 711.131)
Lot(s) not for building unless
approved by Board of Health.
HOLMES CO. PLANNING COMM.
By AO Date 3/3/03

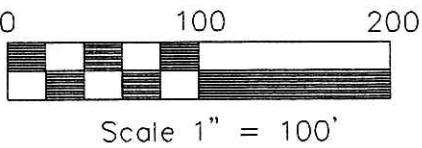

- ▲ R.R. SPIKE FOUND
- 5/8" REBAR FOUND
UNLESS OTHERWISE NOTED
- 5/8" REBAR WITH I.D. CAP SET
I.D. CAP MARKED "BAKER 6938"



DONALD C. BAKER SURVEYING
138 N. CLAY ST.
MILLERSBURG, OHIO 44654
PH. 330-674-4788
FAX 330-674-6027

I CERTIFY THIS SURVEY TO BE CORRECT
TO THE BEST OF MY KNOWLEDGE.
Donald C Baker
DONALD C. BAKER P.S. 6938
AUG. 26, 2002 FDB/FCC
File Name: C:\JOBS1\S-617-02\ERZ

PLAT APPROVED
3/4/2003