

CLARK TOWNSHIP
N.W. QTR. SECTION 25
T-8 N; R-4 W
HOLMES COUNTY, OHIO

SURVEYED FOR: JACOB E. BARKMAN

200300022140
Filed for Record in
HOLMES COUNTY, OH
SALLY MILLER
03-24-2003 02:34 pm.
SMALL PLAT 20.00
OR Book 18 Page 561 - 561
CR vol 142 pg 859



REFERENCES:

DEED VOL. 276 PAGES 762 & 884
PLAT VOL. 16 PAGE 309
BEARINGS FROM PLAT VOL. 16 PAGE 309

030043
APPROVED FOR TRANSFER ONLY
NO SUBDIVISION PLAT REQUIRED
(O.R.C. 711.001 & 711.131)
Lot(s) not for building unless
approved by Board of Health.
HOLMES CO. PLANNING COMM.
By As Date 3/21/03

INDEXED

200300022140
MILLER &
MAST ATTYS
MILLERSBURG,

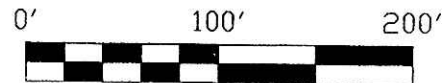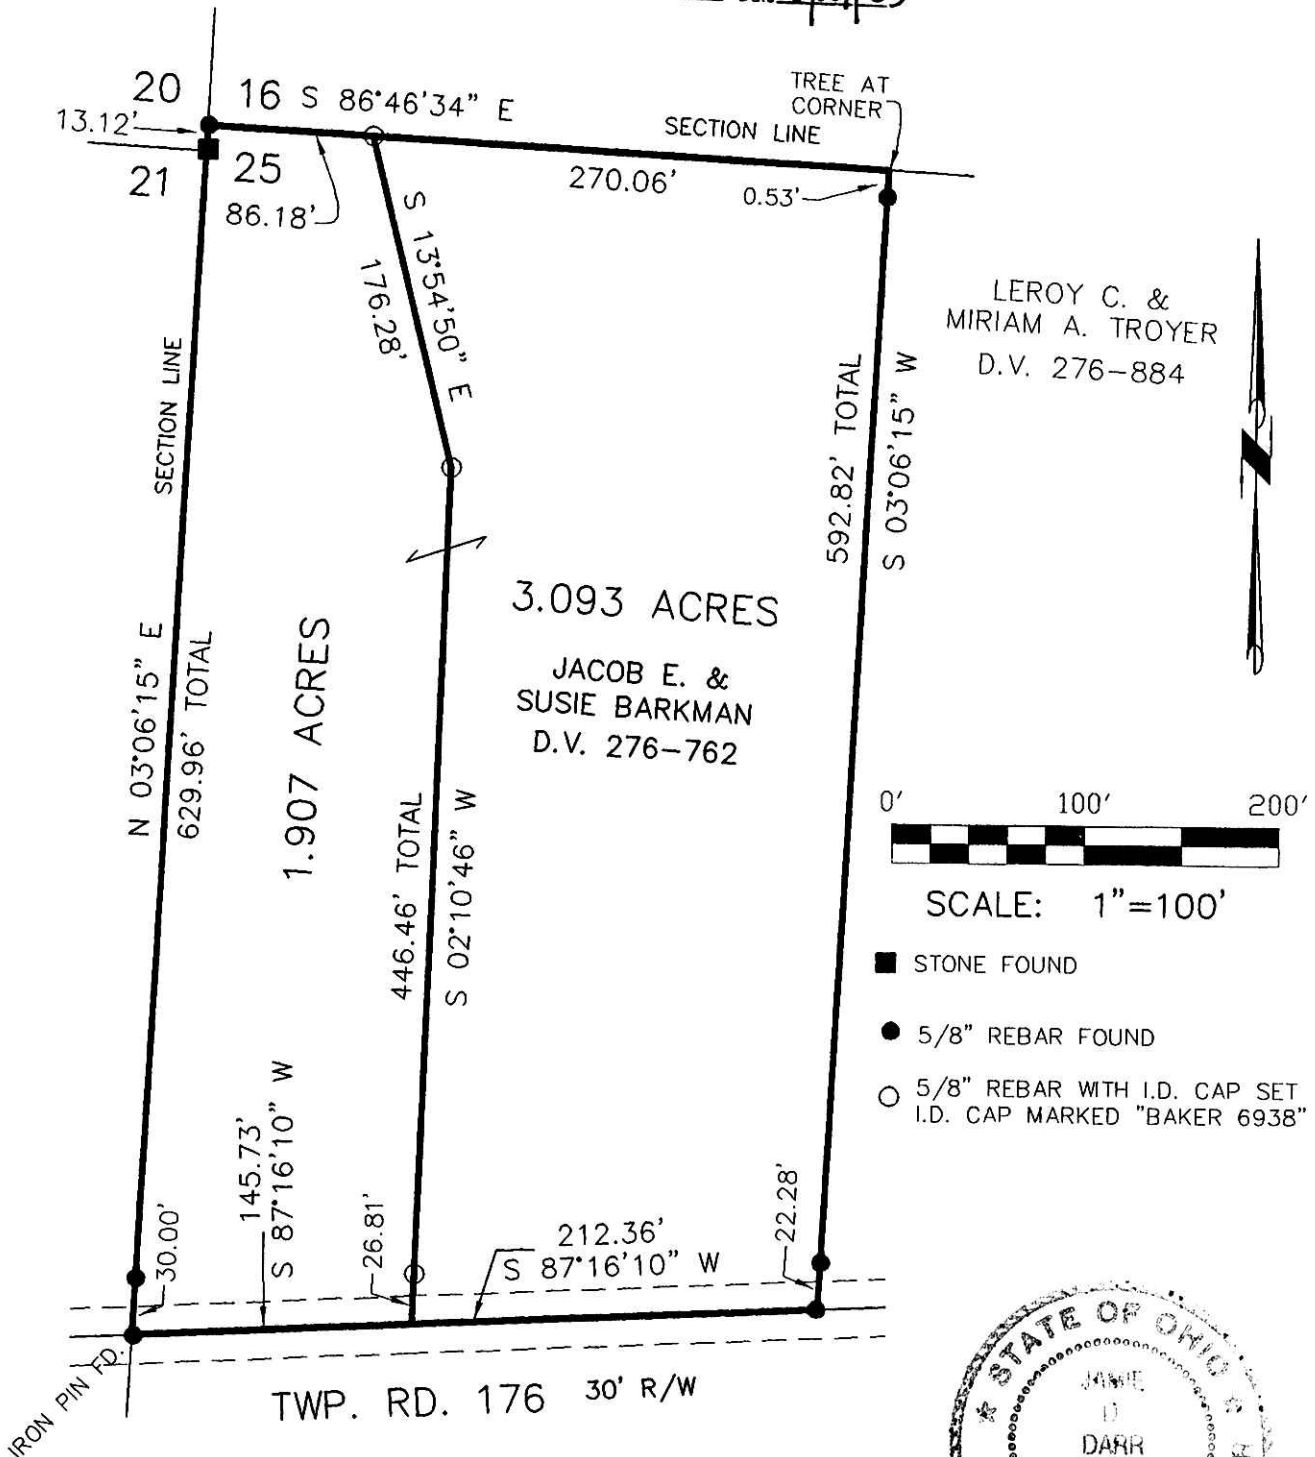

SCALE: 1"=100'

- STONE FOUND
- 5/8" REBAR FOUND
- 5/8" REBAR WITH I.D. CAP SET
I.D. CAP MARKED "BAKER 6938"



PLAT APPROVED

3/24/2003



DONALD C. BAKER SURVEYING
138 N. CLAY ST.
MILLERSBURG, OH 44654
PH. 330-674-4788
FAX: 330-674-6027

I CERTIFY THIS SURVEY TO BE CORRECT
TO THE BEST OF MY KNOWLEDGE.

JAMIE D. DARR PS 7755

CC\JDD DATE: FEB. 5, 2003
File Name: C:\JOBS1\S-16-03\ERZ