


WC-3
WC-2

WALNUT CREEK TOWNSHIP
S.E. QTR. SECTION 13
N.E. QTR. SECTION 18
T. 9 N.; R. 5 W
HOLMES COUNTY, OHIO
(SURVEYED FOR: MERVIN P. & LEONA MAE MILLER)

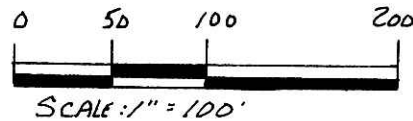

VOL 18 PAGE 615

SCALE: 1" = 100'

- 5/8" REBAR FOUND (UNLESS OTHERWISE NOTED)
- STONE FOUND
- 5/8" REBAR WITH I.D. CAP SET I.D. CAP MARKED "BAKER 6938"

REFERENCES:

DEED VOL. 233 PAGE 895
 " " 275 " 87
 " " 275 " 610
 " " 269 " 401
 " " 255 " 746
 " " 257 " 465


200300023265
 Filed for Record in
 HOLMES COUNTY, OH
 SALLY MILLER
 05-13-2003 09:09 am.
 SMALL PLAT 20.00
 OR Book 18 Page 615 - 615
 OR 149 pg 24

OR VOL. 64 PAGE 432
 PLAT VOL. 12 PAGE 943

BEARINGS FROM PLAT VOL. 10
 PAGE 682

200300023265
 HEARTLAND
 TITLE
 MILLERSBURG,

INDEXED

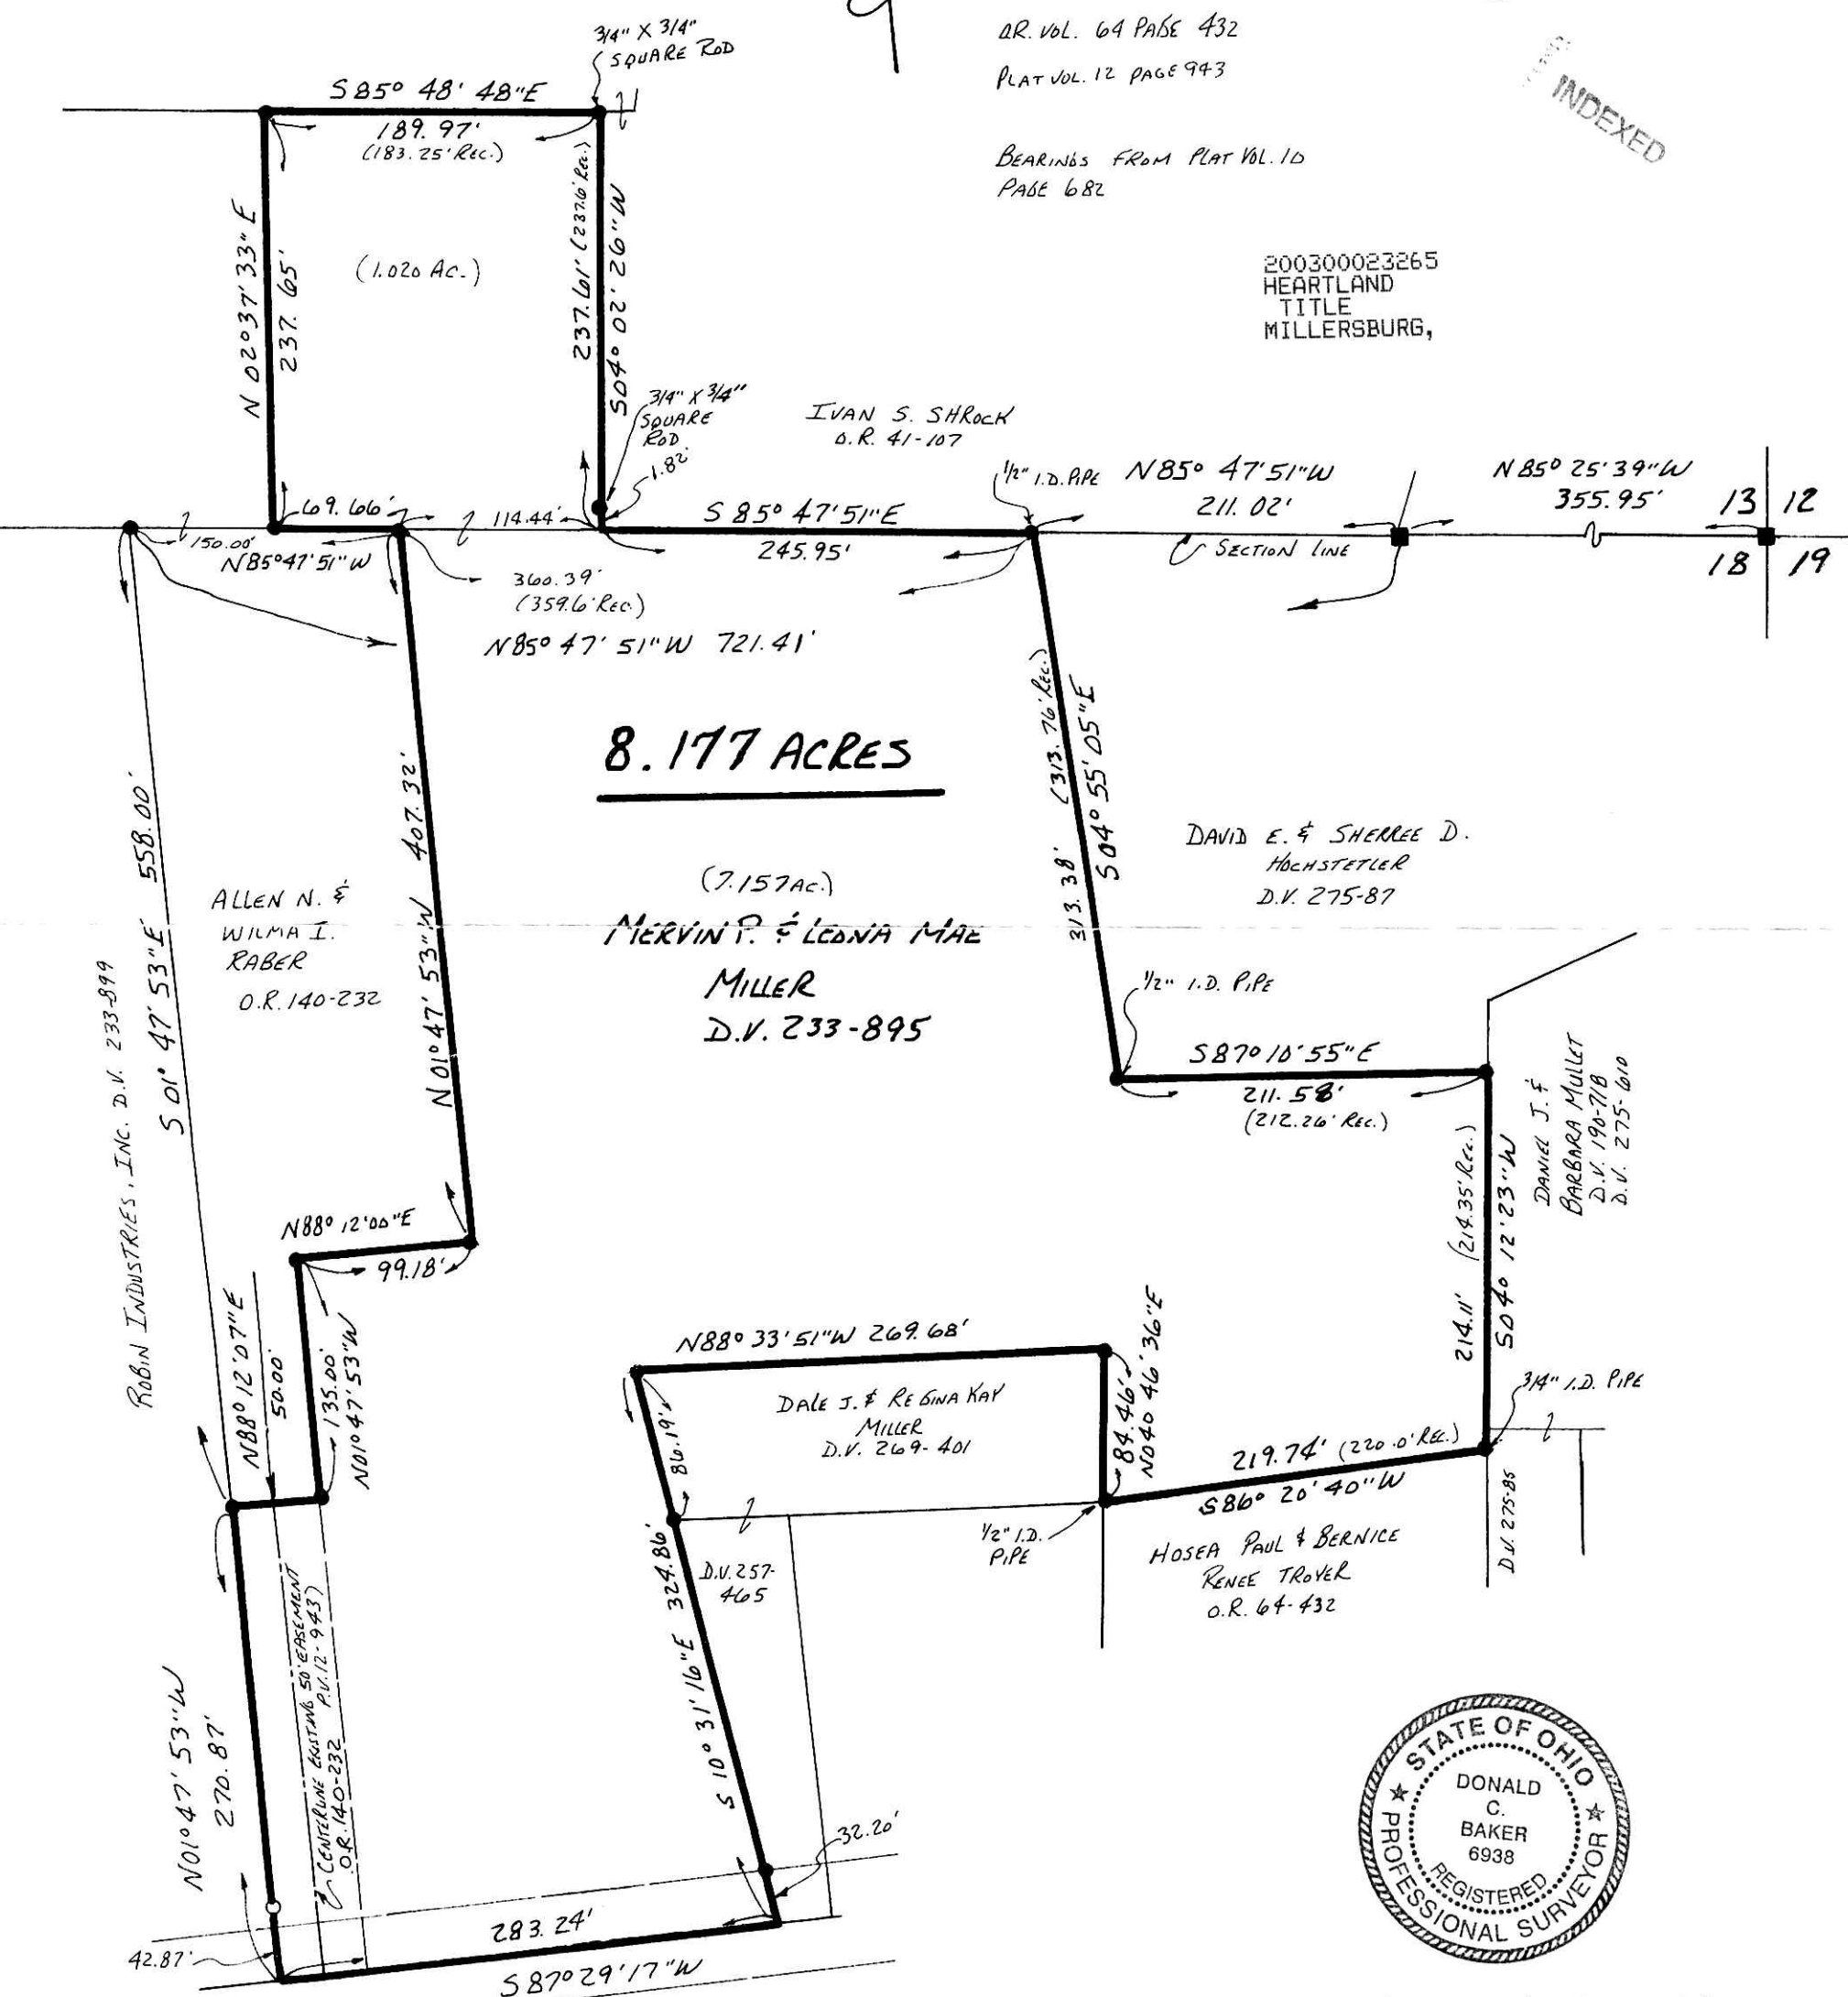

I CERTIFY THIS SURVEY TO BE CORRECT TO THE BEST OF MY KNOWLEDGE.

Donald C. Baker
 DONALD C. BAKER P.S. 6938
 DONALD C. BAKER SURVEYING
 138 N. CLAY ST.
 MILLERSBURG, OHIO 44654
 PH. 330-674-4788

PLAT APPROVED

5/9/2003

F.C.C.: F.O.B./K.E.S.

APRIL 25, 2003
#29403

S.R. 39 R/W VARIES