

MONROE TOWNSHIP
1ST. QTR., LOT 30
T-9 N; R-8 W
HOLMES COUNTY, OHIO

SURVEYED FOR: JIM STEELE

REFERENCES:

DEED VOL. 244 PAGE 938
DEED VOL. 255 PAGE 659
PLAT VOL. 18 PAGE 143
BEARINGS FROM PLAT VOL. 18 PAGE 143



m. 12
VOL 0018 PAGE 637

Instrument Book Page
200300023785 OR 18 637

200300023785
Filed for Record in
HOLMES COUNTY, OH
SALLY MILLER
06-05-2003 At 02:24 pm.
SMALL PLAT 20.00
OR Book 18 Page 637 - 637
ok vol 151 pg 778

200300023785
HOLMES COUNTY TITLE
MILLERSBURG, OH 44654

INDEXED

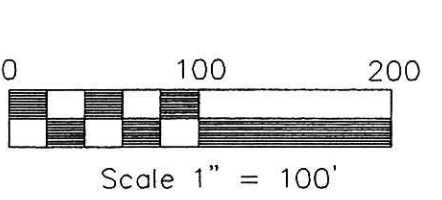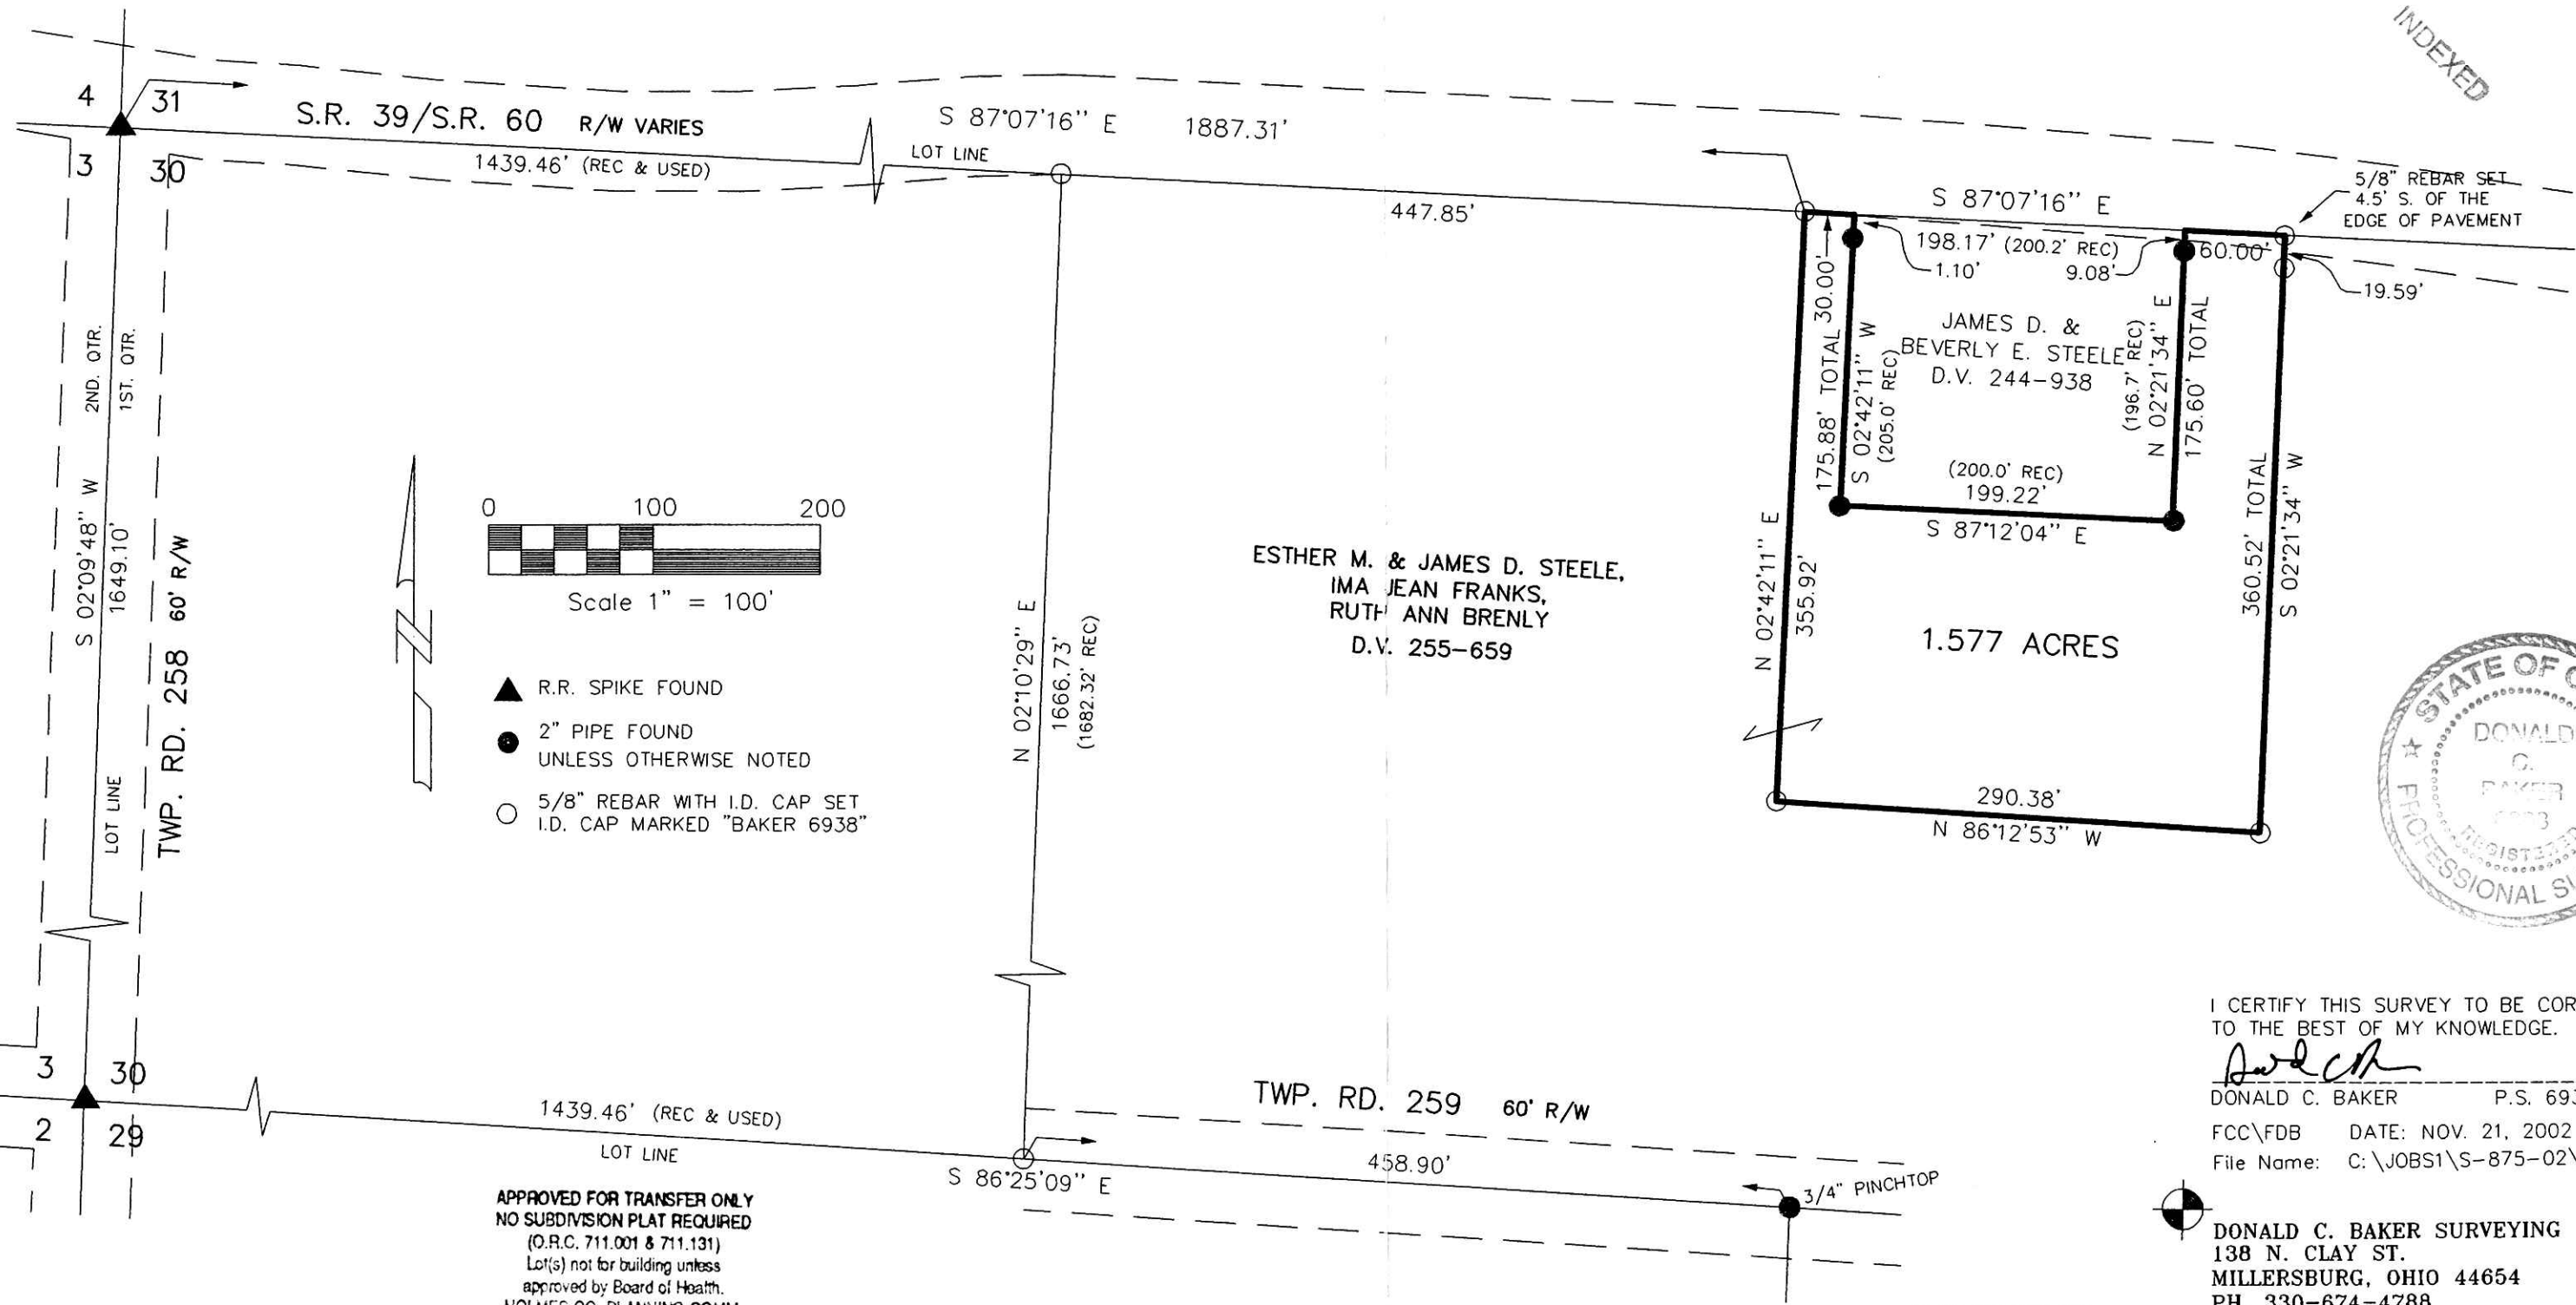

- ▲ R.R. SPIKE FOUND
- 2" PIPE FOUND
UNLESS OTHERWISE NOTED
- 5/8" REBAR WITH I.D. CAP SET
I.D. CAP MARKED "BAKER 6938"

ESTHER M. & JAMES D. STEELE,
IMA JEAN FRANKS,
RUTH ANN BRENLAY
D.V. 255-659

1.577 ACRES



APPROVED FOR TRANSFER ONLY
NO SUBDIVISION PLAT REQUIRED
(O.R.C. 711.001 & 711.131)
Lot(s) not for building unless
approved by Board of Health.
HOLMES CO. PLANNING COMM.

By AC Date 6/3/03
030111

I CERTIFY THIS SURVEY TO BE CORRECT
TO THE BEST OF MY KNOWLEDGE.

Donald C. Baker
DONALD C. BAKER P.S. 6938
FCC\FDB DATE: NOV. 21, 2002
File Name: C:\JOBS1\S-875-02\ERZ

⊙ DONALD C. BAKER SURVEYING
138 N. CLAY ST.
MILLERSBURG, OHIO 44654
PH. 330-674-4788
FAX 330-674-6027

PLAT APPROVED

6/4/2003