

CLARK TOWNSHIP
N.E. QTR. SECTION 8
T-8 N; R-5 W
HOLMES COUNTY, OHIO


SURVEYED FOR: JOHN HENRY TROYER

REFERENCES:

- DEED VOL. 229 PAGE 905
- DEED VOL. 278 PAGE 174
- O.R. VOL. 2 PAGE 425
- O.R. VOL. 3 PAGE 709
- PLAT VOL. 9 PAGE 75
- PLAT VOL. 10 PAGE 515
- PLAT VOL. 13 PAGE 15
- BEARINGS FROM PLAT VOL. 13 PAGE 15

030161
 APPROVED FOR TRANSFER ONLY
 NO SUBDIVISION PLAT REQUIRED
 (O.R.C. 711.001 & 711.131)
 Lot(s) not for building unless
 approved by Board of Men'th.
 HOLMES CO. PLANNING COMM.

By AD Date 8/4/03

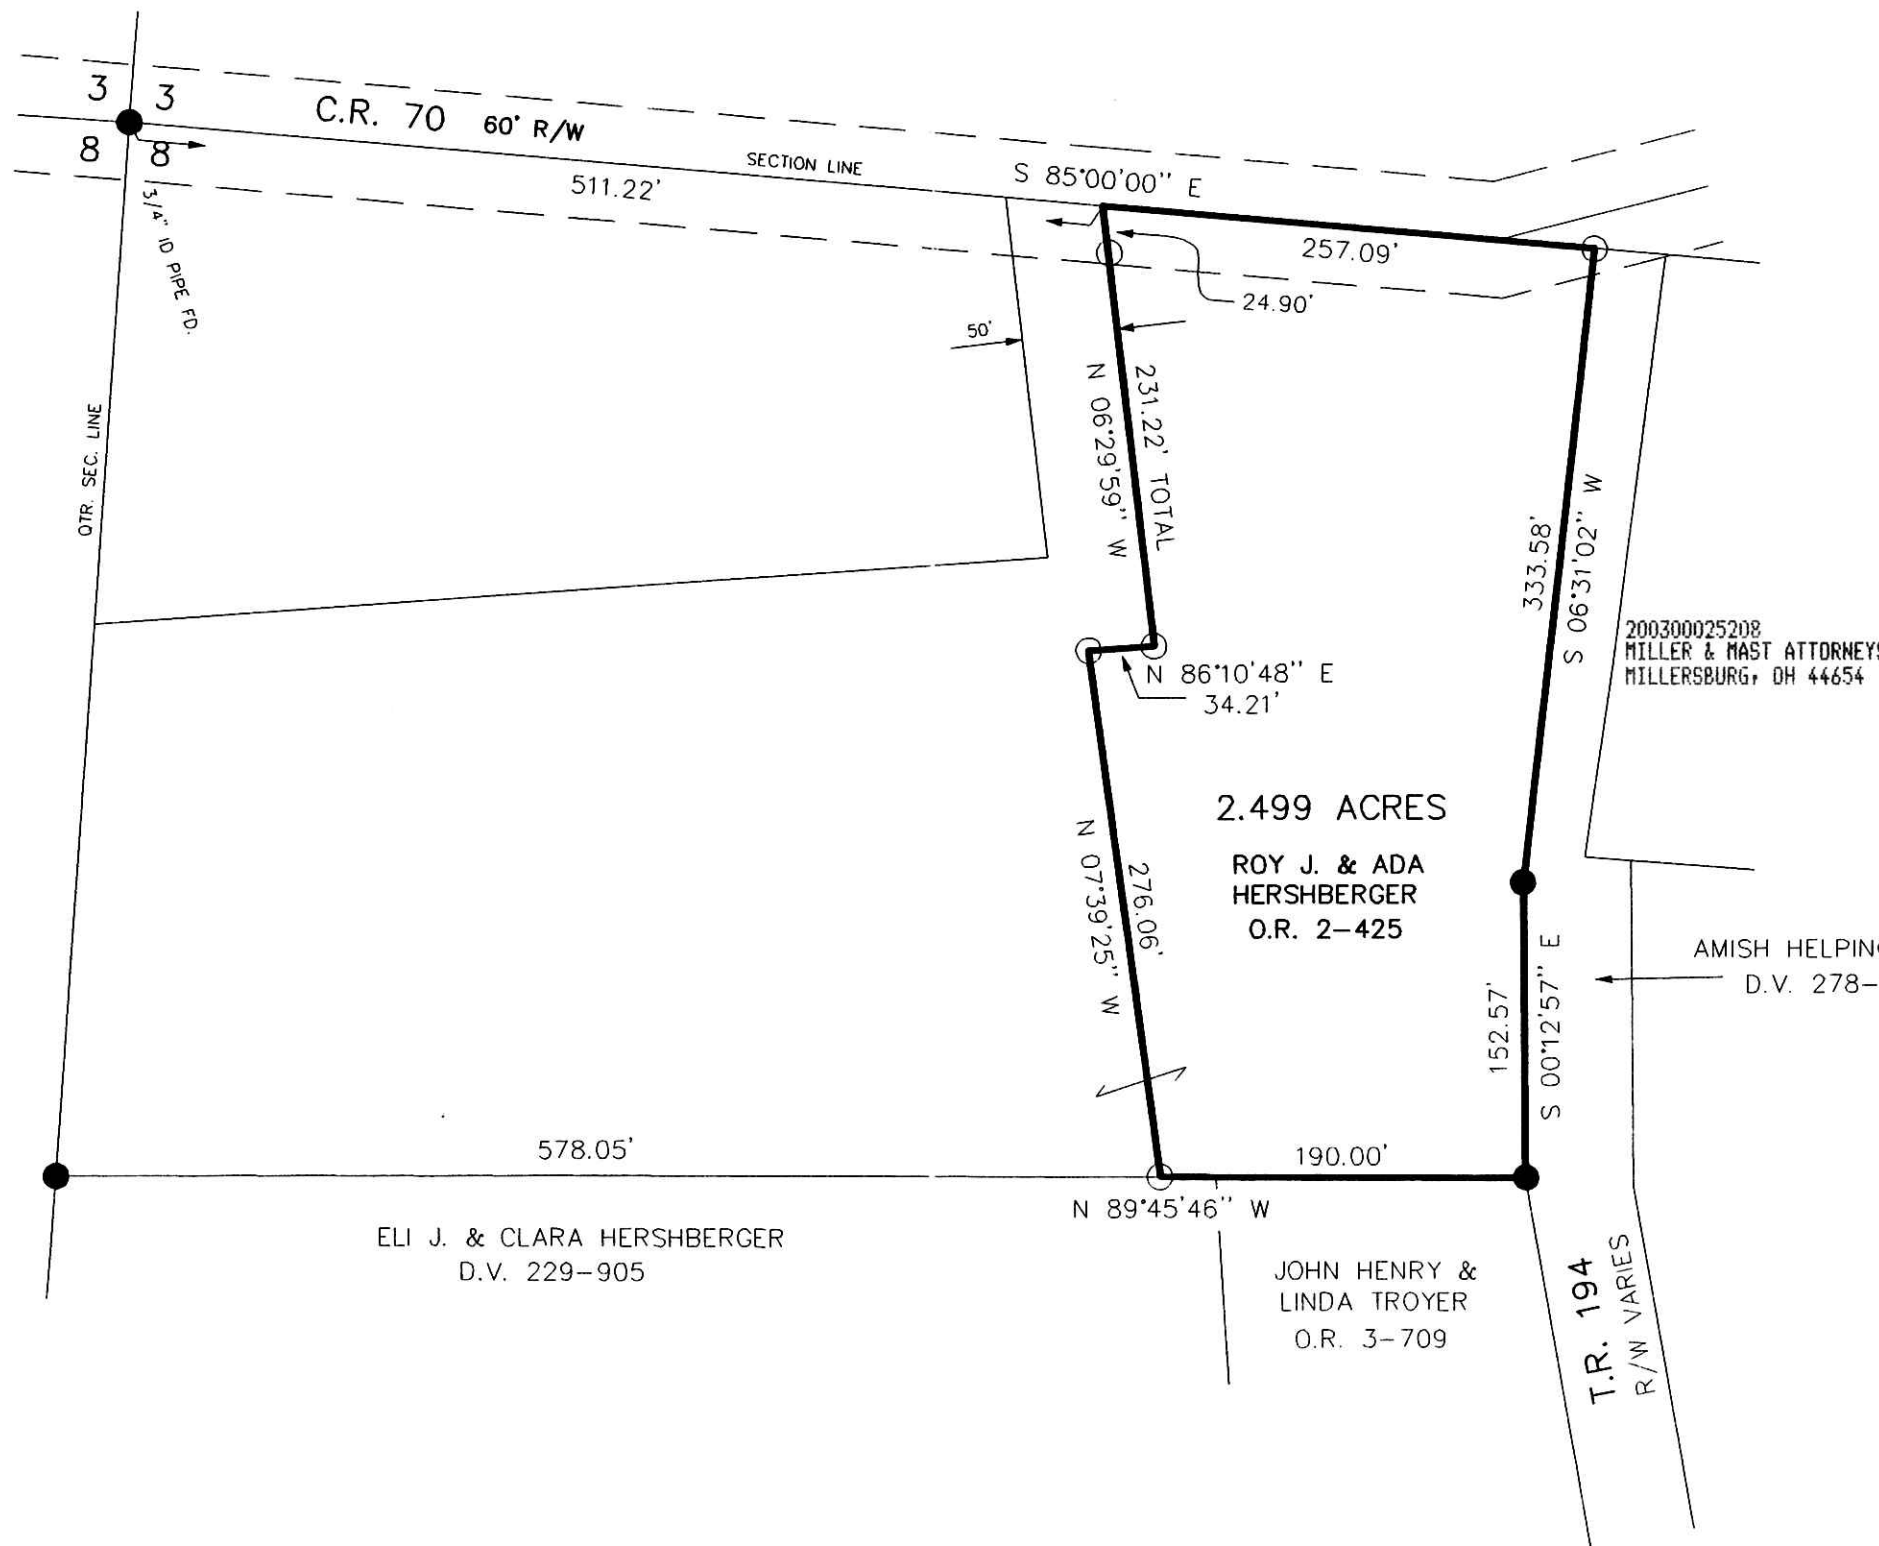

INDEXED

200300025208
 Filed for Record in
 HOLMES COUNTY, OH
 SALLY MILLER
 08-06-2003 At 12:47 pm.
 SMALL PLAT 40.00
 OR Book 18 Page 697 - 697
 of vol 159 pg 615



Scale 1" = 100'

- 1/2" ID PIPE FOUND UNLESS OTHERWISE NOTED
- 5/8" REBAR WITH I.D. CAP SET I.D. CAP MARKED "BAKER 6938"

PLAT APPROVED

8/5/2003



I CERTIFY THIS SURVEY TO BE CORRECT TO THE BEST OF MY KNOWLEDGE.

Jamie D. Darr
 JAMIE D. DARR P.S. 7755

CC\JDD DATE: JUNE 16, 2003
 File Name: C:\JOBS1\S-477-03\ERZ

DONALD C. BAKER SURVEYING
 138 N. CLAY ST.
 MILLERSBURG, OHIO 44654
 PH. 330-674-4788
 FAX 330-674-6027