

MECHANIC TOWNSHIP
3RD. QTR., LOT 2
T-8 N; R-6 W
HOLMES COUNTY, OHIO

SURVEYED FOR: DAVID NISLEY

REFERENCES:

- O.R. VOL. 58 PAGE 677
- O.R. VOL. 94 PAGE 750
- O.R. VOL. 129 PAGE 314
- O.R. VOL. 153 PAGE 643

- PLAT VOL. 9 PAGE 125
- PLAT VOL. 17 PAGE 598
- PLAT VOL. 18 PAGES 138 & 381

BEARINGS FROM PLAT VOL. 18 PAGE 138



I CERTIFY THIS SURVEY TO BE CORRECT TO THE BEST OF MY KNOWLEDGE.

JAMIE D. DARR P.S. 7755



DATE: AUGUST 8, 2003

FCC\JDD

File Name: C:\JOBS1\S-582-03\ERZ



DONALD C. BAKER SURVEYING
138 N. CLAY ST.
MILLERSBURG, OHIO 44654
PH. 330-674-4788
FAX 330-674-6027

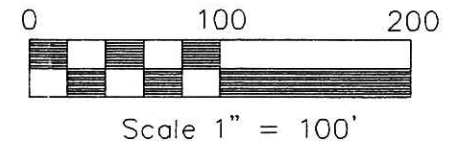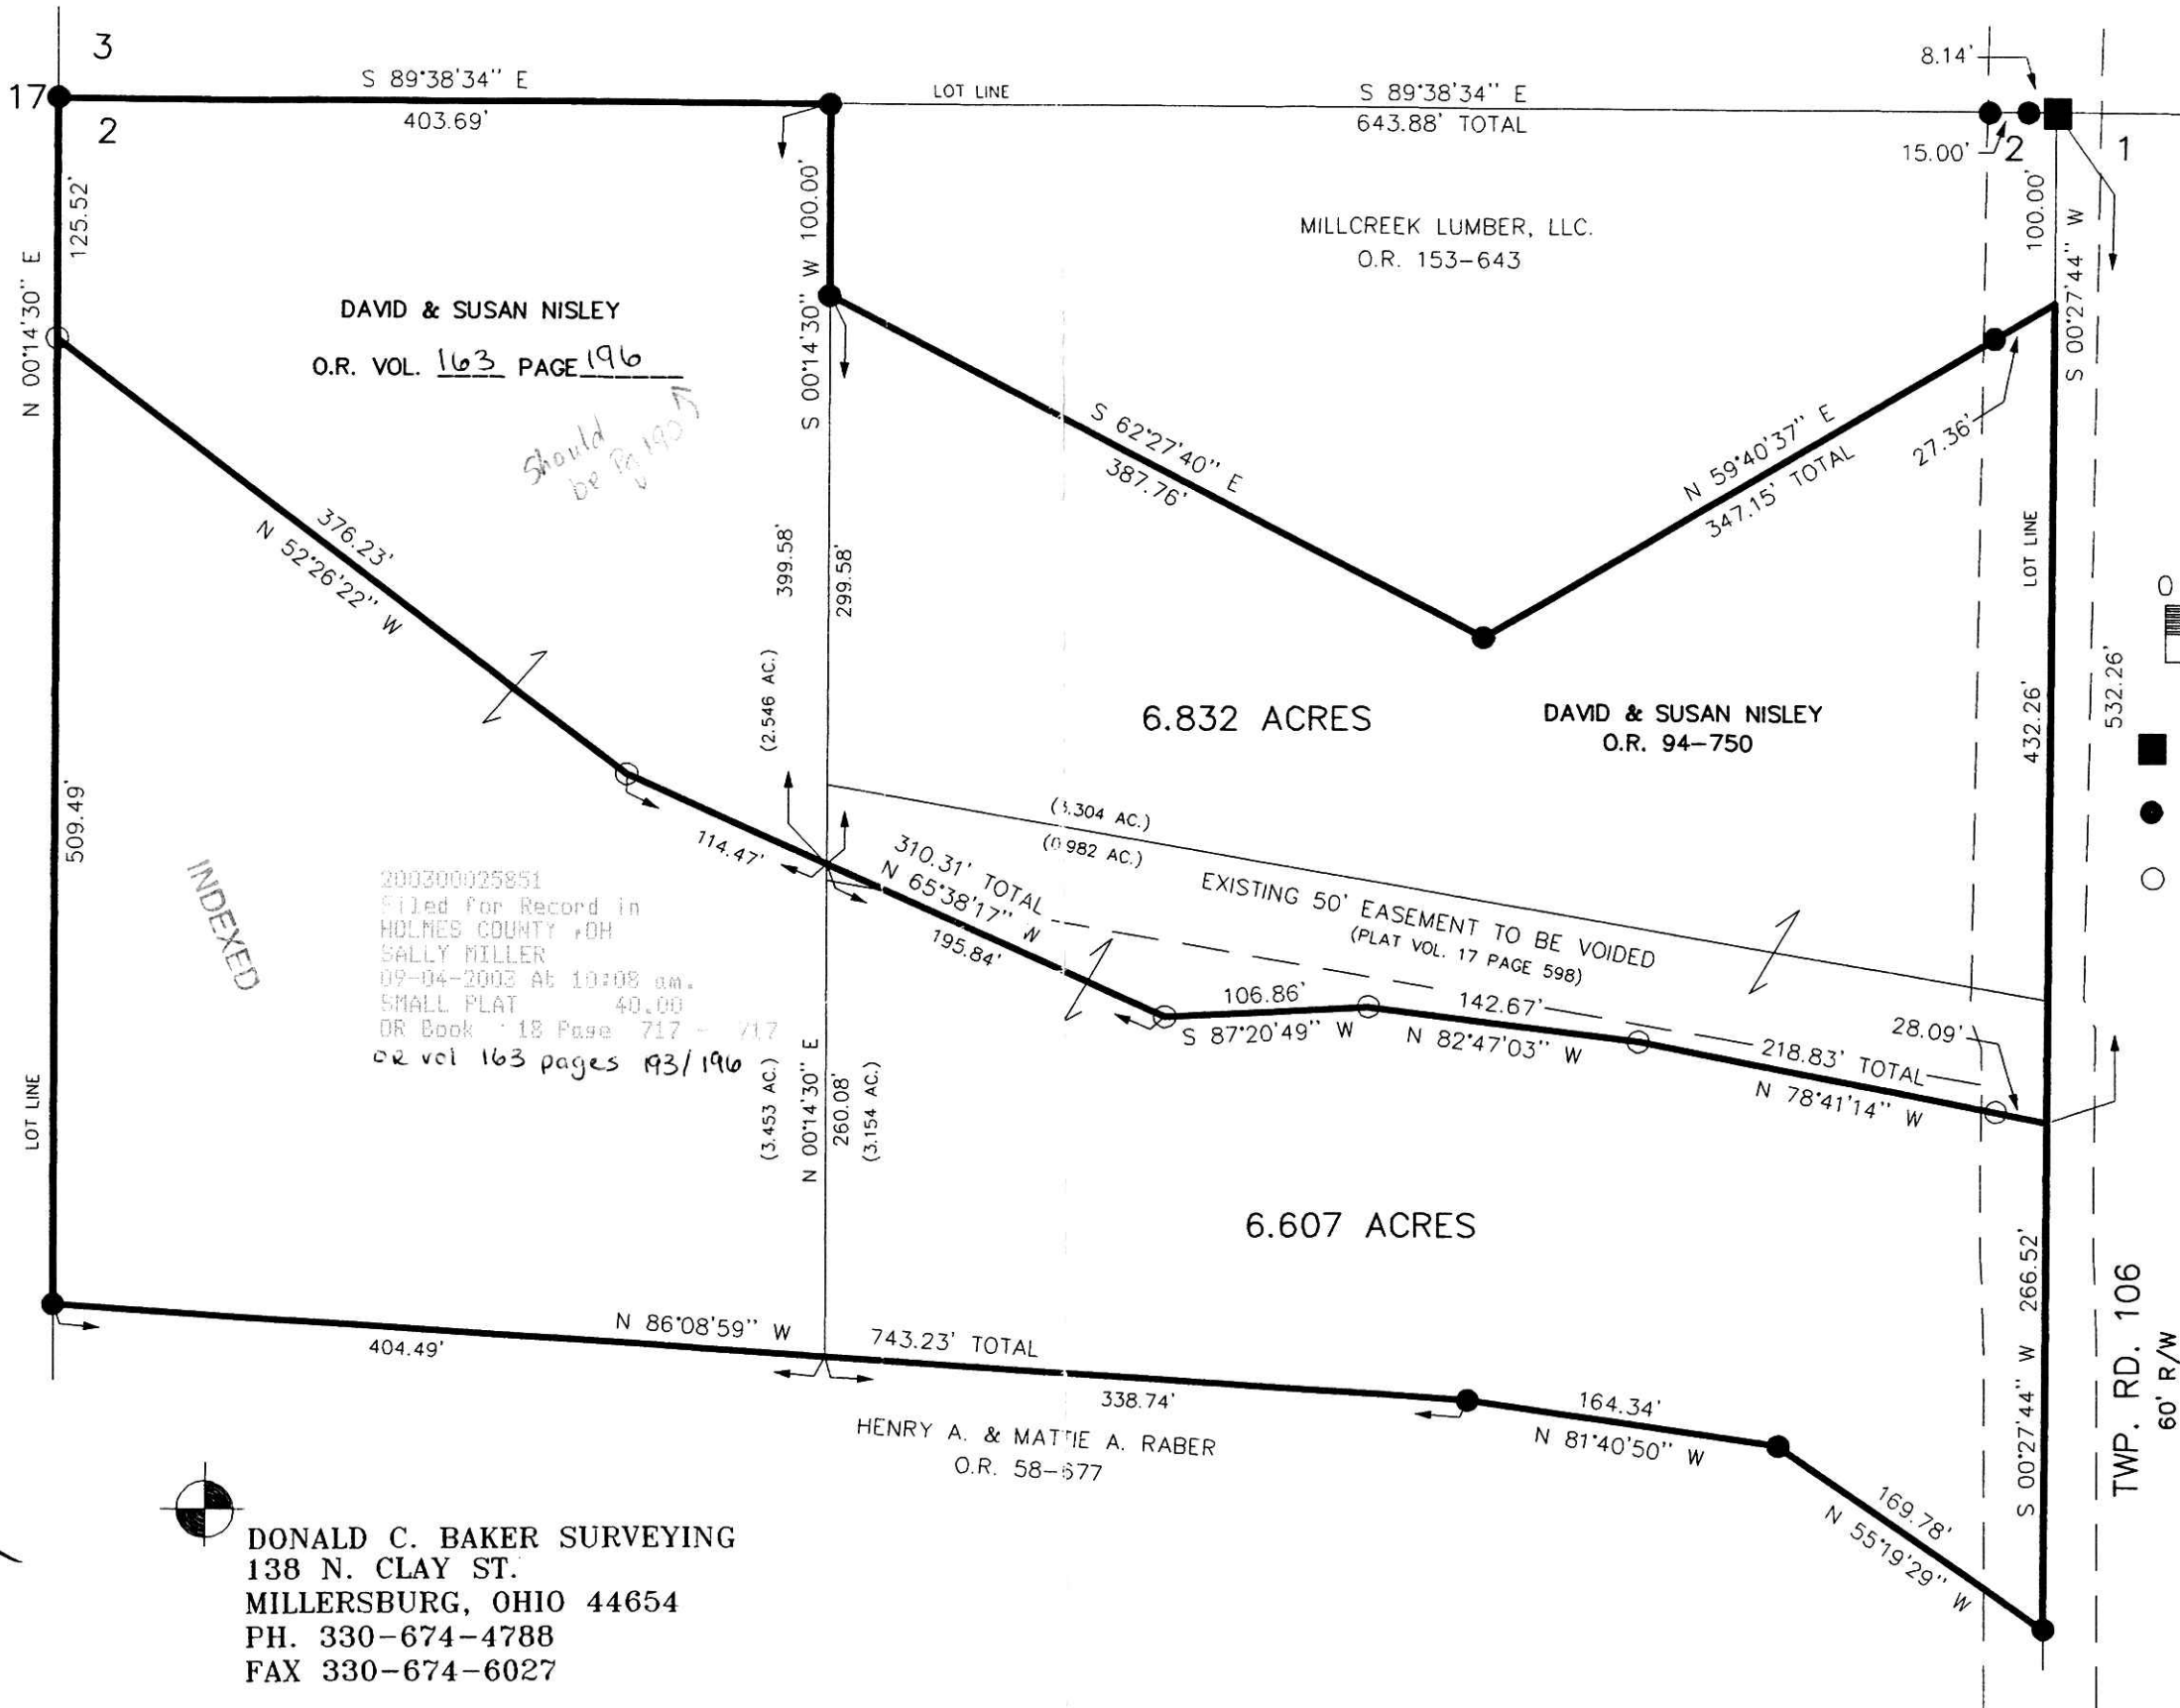

- STONE FOUND
- 5/8" REBAR FOUND UNLESS OTHERWISE NOTED
- 5/8" REBAR WITH I.D. CAP SET I.D. CAP MARKED "BAKER 6938"

Instrument Book Page
200300025851 OR 18 717

PLAT APPROVED
9/3/2003