

- P.K. NAIL FOUND
- 5/8" REBAR FOUND
UNLESS OTHERWISE NOTED



VILLAGE OF CHARM
CLARK TOWNSHIP
S.E. QTR. SECTION 5
T-8 N; R-5 W
HOLMES COUNTY, OHIO

SURVEYED FOR: ELI MILLER

REFERENCES:



- DEED VOL. 133 PAGE 361
- O.R. VOL. 59 PAGE 911
- O.R. VOL. 35 PAGE 140
- O.R. VOL. 35 PAGE 142
- PLAT VOL. 17 PAGE 177

BEARINGS FROM DEED VOL. 186 PAGE 763

200400032443
DAVID E MILLER
4533 SR 557
MILLERSBURG, OH 44654

200400032443
Filed for Record in
HOLMES COUNTY, OH
SALLY MILLER
08-24-2004 At 08:09 am.
SMALL PLAT 40.00
DR Book 19 Page 162 - 162

OR 174 pg 2320

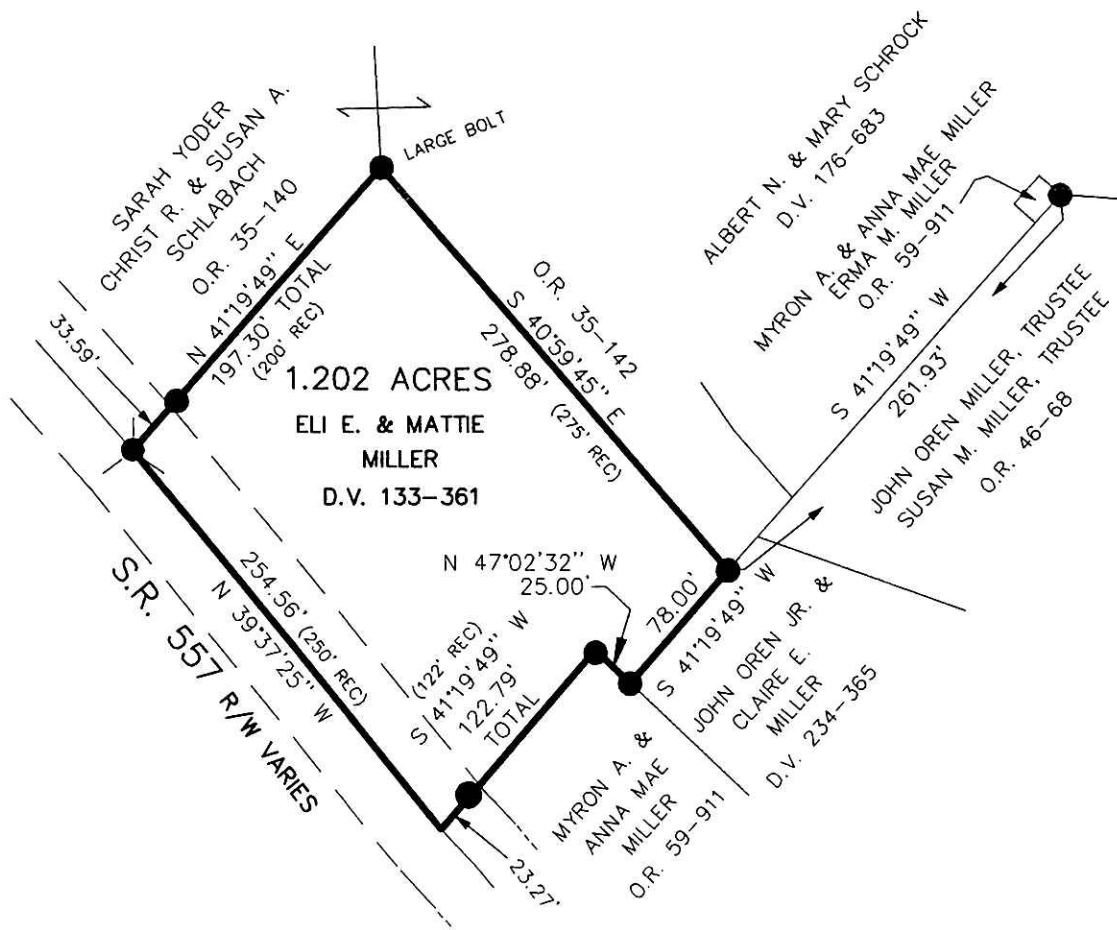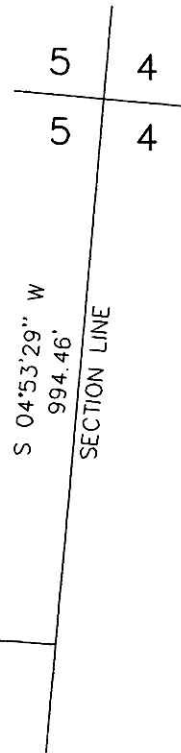

N 85°52'10" W
818.18' TOTAL

BE 4 KL, LTD
O.R. 22-866

O.R. 36-282



DONALD C. BAKER SURVEYING
138 N. CLAY ST.
MILLERSBURG, OHIO 44654
PH. 330-674-4788
FAX 330-674-6027

PLAT APPROVED

8/17/2004 DB

I CERTIFY THIS SURVEY TO BE CORRECT TO THE BEST OF MY KNOWLEDGE.

DONALD C. BAKER P.S. 6938

DATE: APRIL 12, 2004

File name: C:\JOBS1\S-226-04\MLD

Instrument
200400032443 OR
Book Page
19 162