

LOT SPLIT
APPROVED BY THE
VILLAGE OF MILLERSBURG
PLANNING COMMISSION

[Signature]
MILLERSBURG
PLANNING COMMISSION

DATE: 9-1-04

200400033160
Filed for Record in
HOLMES COUNTY, OH
SALLY MILLER
10-06-2004 At 02:54 pm.
SMALL PLAT 40.00
OR Book 19 Page 207 - 207
OR vol 175 page 1959

200400033160
MILLER &
MAST ATTYS
MILLERSBURG, OH

Merle
R. Mullet
O.R. 153
Pg. 689


South I.P.(F) 65.43' I.P.(S)
Line Lot 41 NB6°13'03"W
1st Qtr. T9N
R7W, Hardy Twp., Holmes County
Ohio, Village of Millersburg

James L. & Joyce J. Beachy
O.R. 44 Pg. 131
P.B. 14 Pg. 566

0.4011 Ac
part of O.R. 22 Pg. 748



O. Lot 20 to
the Village of
Millersburg.

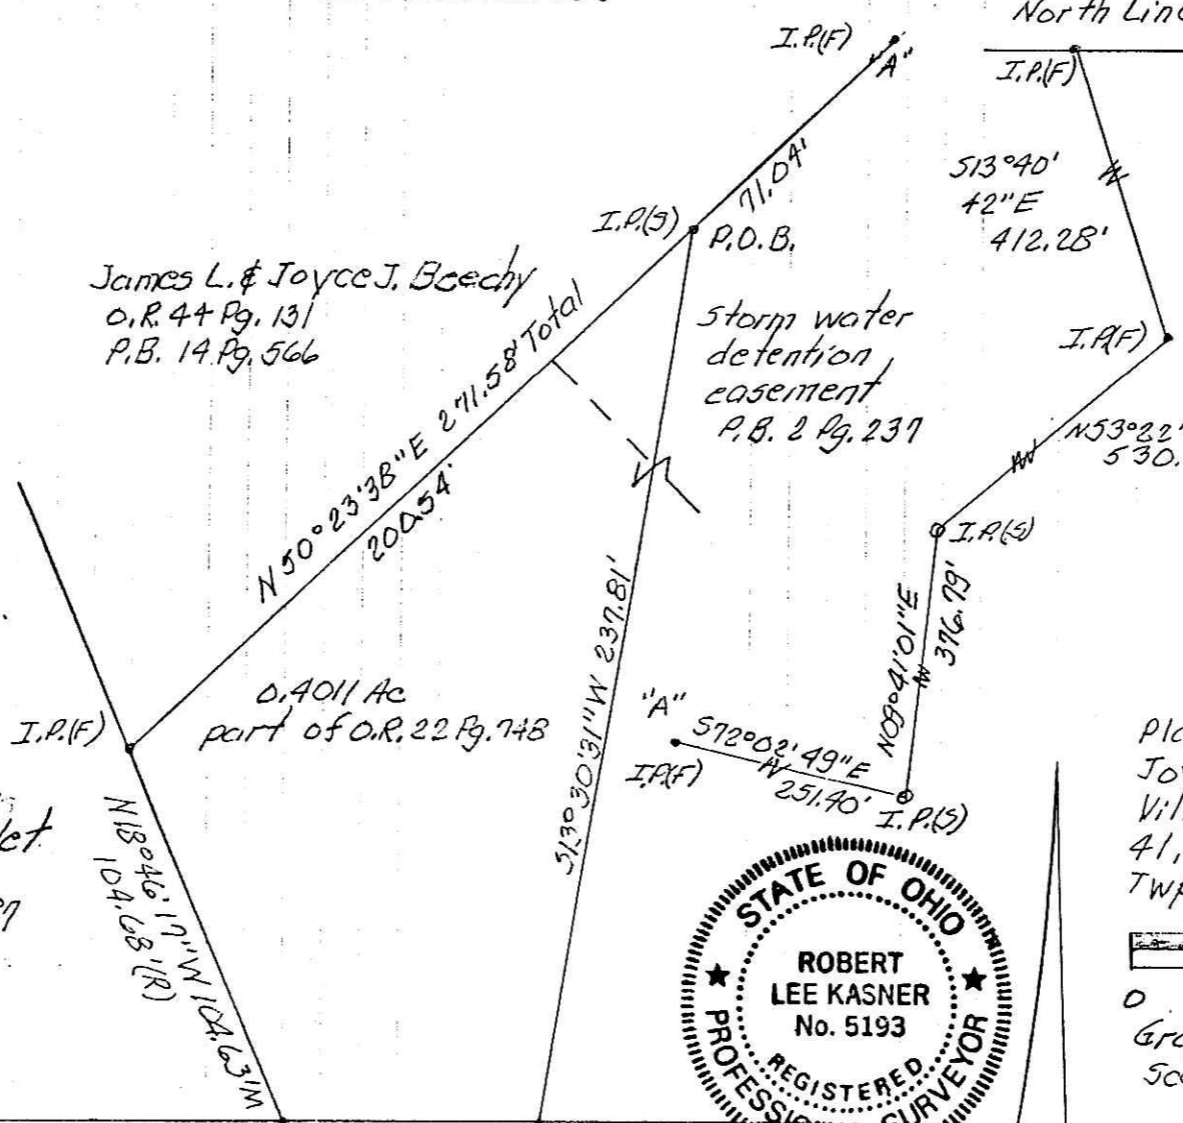


Stone found N.E. Crnr
Lot 41, 1st Qtr., T9N, R7W
Hardy Twp
Holmes Co.
Ohio
Village of
Millersburg

All lead ins to P.O.B
from P.B. 16 Pg. 201.

Schlabach Builders, Ltd.
O.R. 22 Pg. 748
P.B. 16 Pg. 201

Bearing basis P.B. 16 Pg. 201
All set I.P. are 3/8" x 30" rebar
Stamped R.L.K. 5193.

Plat of a survey for James L. &
Joyce J. Beachy located in the
Village of Millersburg in Lot
41, 1st. Qtr., T9N, R7W, of Hardy
Twp., Holmes Co., Ohio.

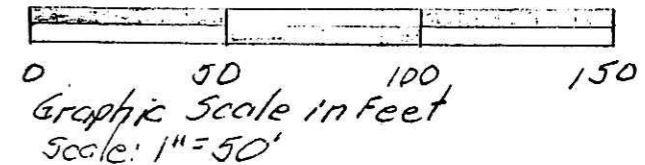

Robert L. Kasner P.E., P.S.
7007 S.R. 39
Millersburg, Ohio, 44654
330 6749146

Robert L. Kasner P.E., P.S.
7/01/04

PLAT APPROVED

Instrument Book Page
200400033160 OR 19 207

10/1/2004 b