

200500035740
 FRENCH RIDGE
 TITLE
 MILLERSBURG, OH

HARDY TOWNSHIP
 S.E. QTR. SECTION 11
 T-9 N; R-7 W
 HOLMES COUNTY, OHIO

SURVEYED FOR: AMERIGO HOLDINGS, LTD.

APPROVED FOR TRANSFER ONLY
 NO SUBDIVISION PLAT REQUIRED
 (O.R.C. 711.001 & 711.131)
 Lot(s) not for building unless
 approved by Board of Health.
 HOLMES CO. PLANNING COMM.

By Date 3/10/05

200500035740
 Filed for Record in
 HOLMES COUNTY, OH
 SALLY MILLER
 03-21-2005 At 10:32 am.
 SMALL PLAT 40.00
 DR Book 19 Page 337 - 337
 ORV 178 page 3072



SCALE: 1"=100'


- 5/8" REBAR FOUND
UNLESS OTHERWISE NOTED
- 5/8" REBAR WITH I.D. CAP SET
I.D. CAP MARKED "BAKER 6938"

REFERENCES

- DEED VOL. 234 PAGE 420
 - DEED VOL. 203 PAGE 182
 - O.R. VOL. 76 PAGE 210
 - O.R. VOL. 118 PAGE 891
 - O.R. VOL. 25 PAGE 216
 - PLAT VOL. 10 PAGE 701
 - PLAT VOL. 10 PAGE 776
 - PLAT VOL. 12 PAGE 293
- BEARINGS FROM PLAT VOL 12 PAGE 293



DONALD C. BAKER SURVEYING
 138 N. CLAY ST.
 MILLERSBURG, OHIO, 44654
 PH. 330-674-4788
 FAX. 330-674-6027

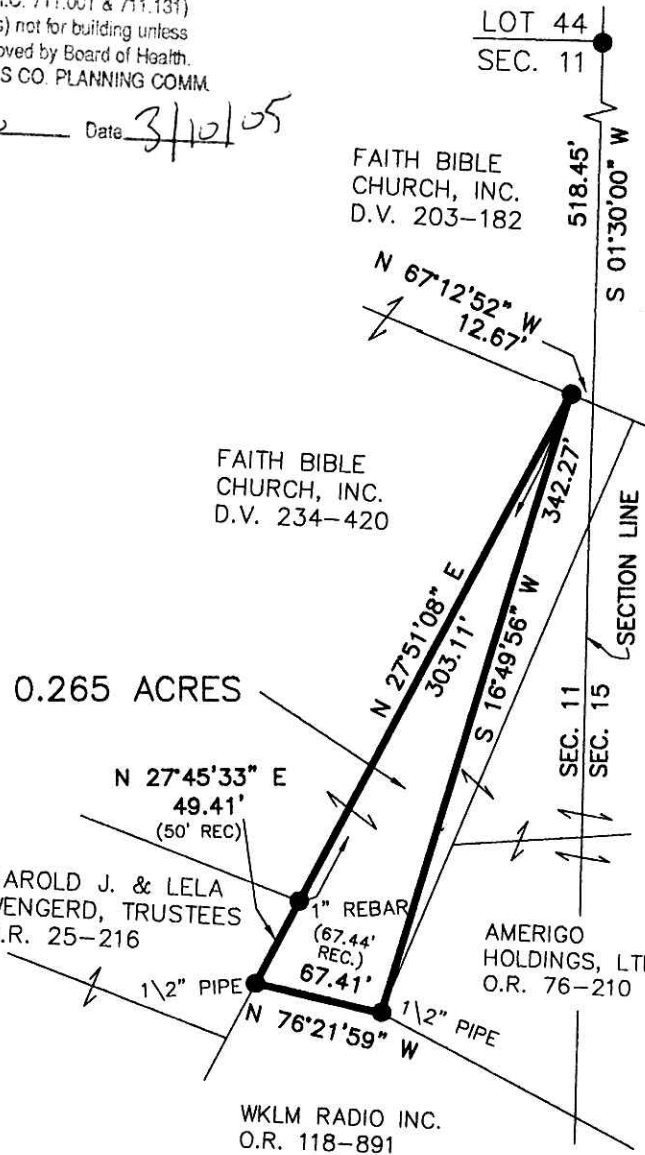

PLAT APPROVED

3/10/2005



I CERTIFY THIS SURVEY TO BE CORRECT TO THE BEST OF MY KNOWLEDGE.

Donald C. Baker
 DONALD C. BAKER P.S. 6938
 DATE: DEC. 2, 2004

FDB\AEG
 File Name: WORK2\S-853-04