

200500039218
KENNETH STITZLEIN
2627 CR 457
LOUDONVILLE, OH 44842

200500039218
Filed for Record in
HOLMES COUNTY, OH
SALLY MILLER
09-26-2005 At 01:03 PM.
FLAT MED 43.20
OR Book 19 Page 507 - 507
ORV 183 page 1760

RESURVEY OF DEED VOL. 226 PAGE 52

WASHINGTON TOWNSHIP
S.W. QTR. SECTION 30
N.W. QTR. SECTION 31
T-20 N; R-15 W
HOLMES COUNTY, OHIO

SURVEYED FOR: KEN STITZLEIN


REFERENCES:

- DEED VOL. 177 PAGE 251
- DEED VOL. 193 PAGE 338
- DEED VOL. 199 PAGE 516
- DEED VOL. 225 PAGE 313
- DEED VOL. 226 PAGE 52
- DEED VOL. 233 PAGES 446 & 448
- DEED VOL. 242 PAGE 426
- DEED VOL. 248 PAGE 173
- DEED VOL. 278 PAGE 527


- O.R. VOL. 5 PAGE 235
- O.R. VOL. 36 PAGE 429
- O.R. VOL. 118 PAGE 255
- O.R. VOL. 164 PAGE 716

- PLAT VOL. 2 PAGE 59
- PLAT VOL. 6 PAGE 148
- PLAT VOL. 7 PAGE 579
- PLAT VOL. 8 PAGE 537
- PLAT VOL. 14 PAGES 84 & 558
- PLAT VOL. 16 PAGE 693

BEARINGS FROM PLAT VOL. 14 PAGE 84

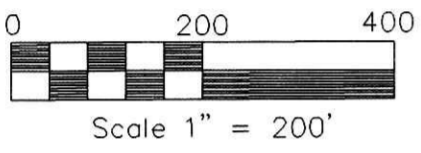

- ▲ R.R. SPIKE FOUND
- 5/8" REBAR FOUND UNLESS OTHERWISE NOTED
- △ R.R. SPIKE SET
- 5/8" REBAR WITH I.D. CAP SET I.D. CAP MARKED "BAKER 6938"

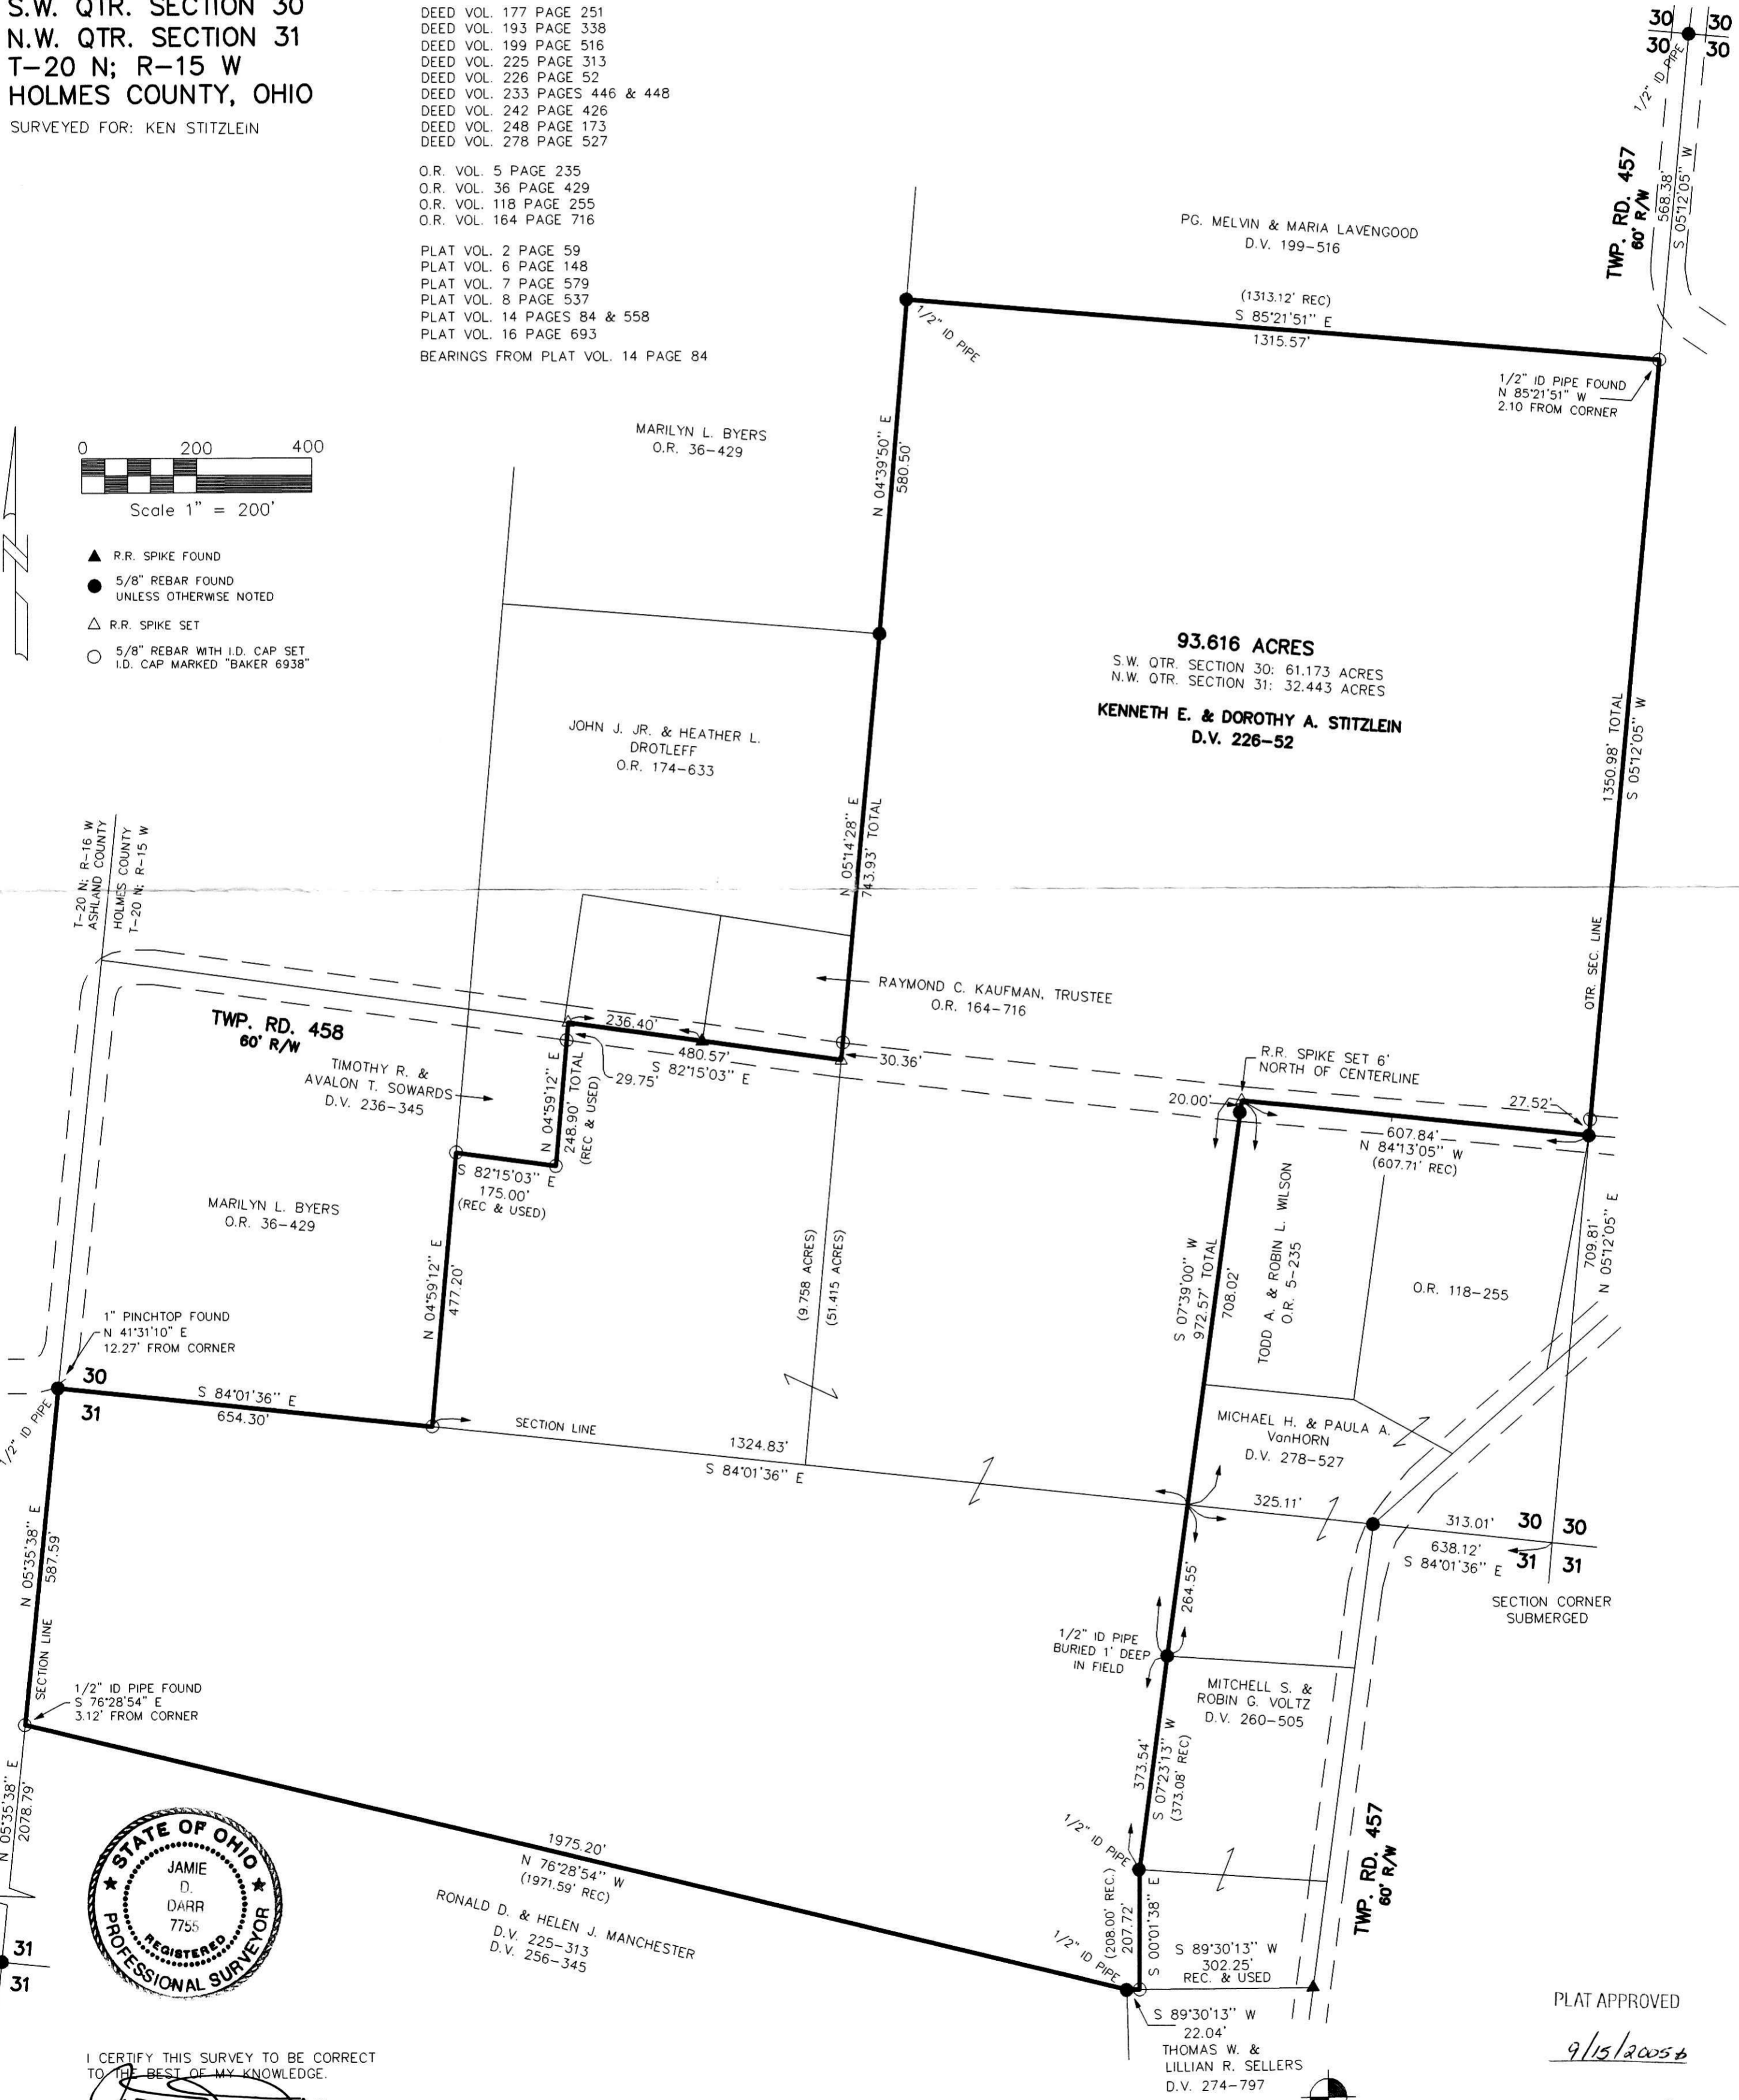

I CERTIFY THIS SURVEY TO BE CORRECT TO THE BEST OF MY KNOWLEDGE.
JAMIE D. DARR P.S. 7755
DATE: APRIL 1, 2005
JDD/ERZ-ALG
File name: C:\JOBS1\S-883-04\ERZ

PLAT APPROVED
9/15/2005

DONALD C. BAKER SURVEYING
138 N. CLAY ST.
MILLERSBURG, OHIO 44654
PH. 330-674-4788
FAX 330-674-6027