

HARDY TOWNSHIP
N.W. QTR. SECTION 7
T-9 N; R-6 W
HOLMES COUNTY, OHIO

SURVEYED FOR: JOE MAST


VOL 0019-602

Instrument Book Page
200600041228 DR 19 602

200600041228
HOLMES CTY
TITLE
MILLERSBURG, OH

REFERENCES


- DEED VOL. 261 PAGE 493
 - DEED VOL. 179 PAGE 797
 - O.R. VOL. 151 PAGE 224
 - PLAT VOL. 18 PAGE 632
 - PLAT VOL. 8 PAGE 878
 - PLAT VOL. 10 PAGE 55
 - PLAT VOL. 17 PAGE 23
- BEARINGS FROM PLAT VOL 18 PAGE 632

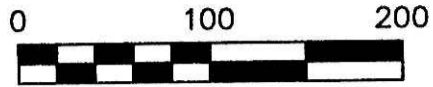

SCALE: 1"=100'

- 5/8" REBAR FOUND
UNLESS OTHERWISE NOTED
- ▲ R.R. SPIKE FOUND
- 5/8" REBAR WITH I.D. CAP SET
I.D. CAP MARKED "BAKER 6938"
- △ R.R. SPIKE SET

200600041228
Filed for Record in
HOLMES COUNTY, OH
SALLY MILLER
01-10-2006 At 10:50 am.
SMALL PLAT 40.00
OR Book 19 Page 602 - 602
ORV 186 page 117

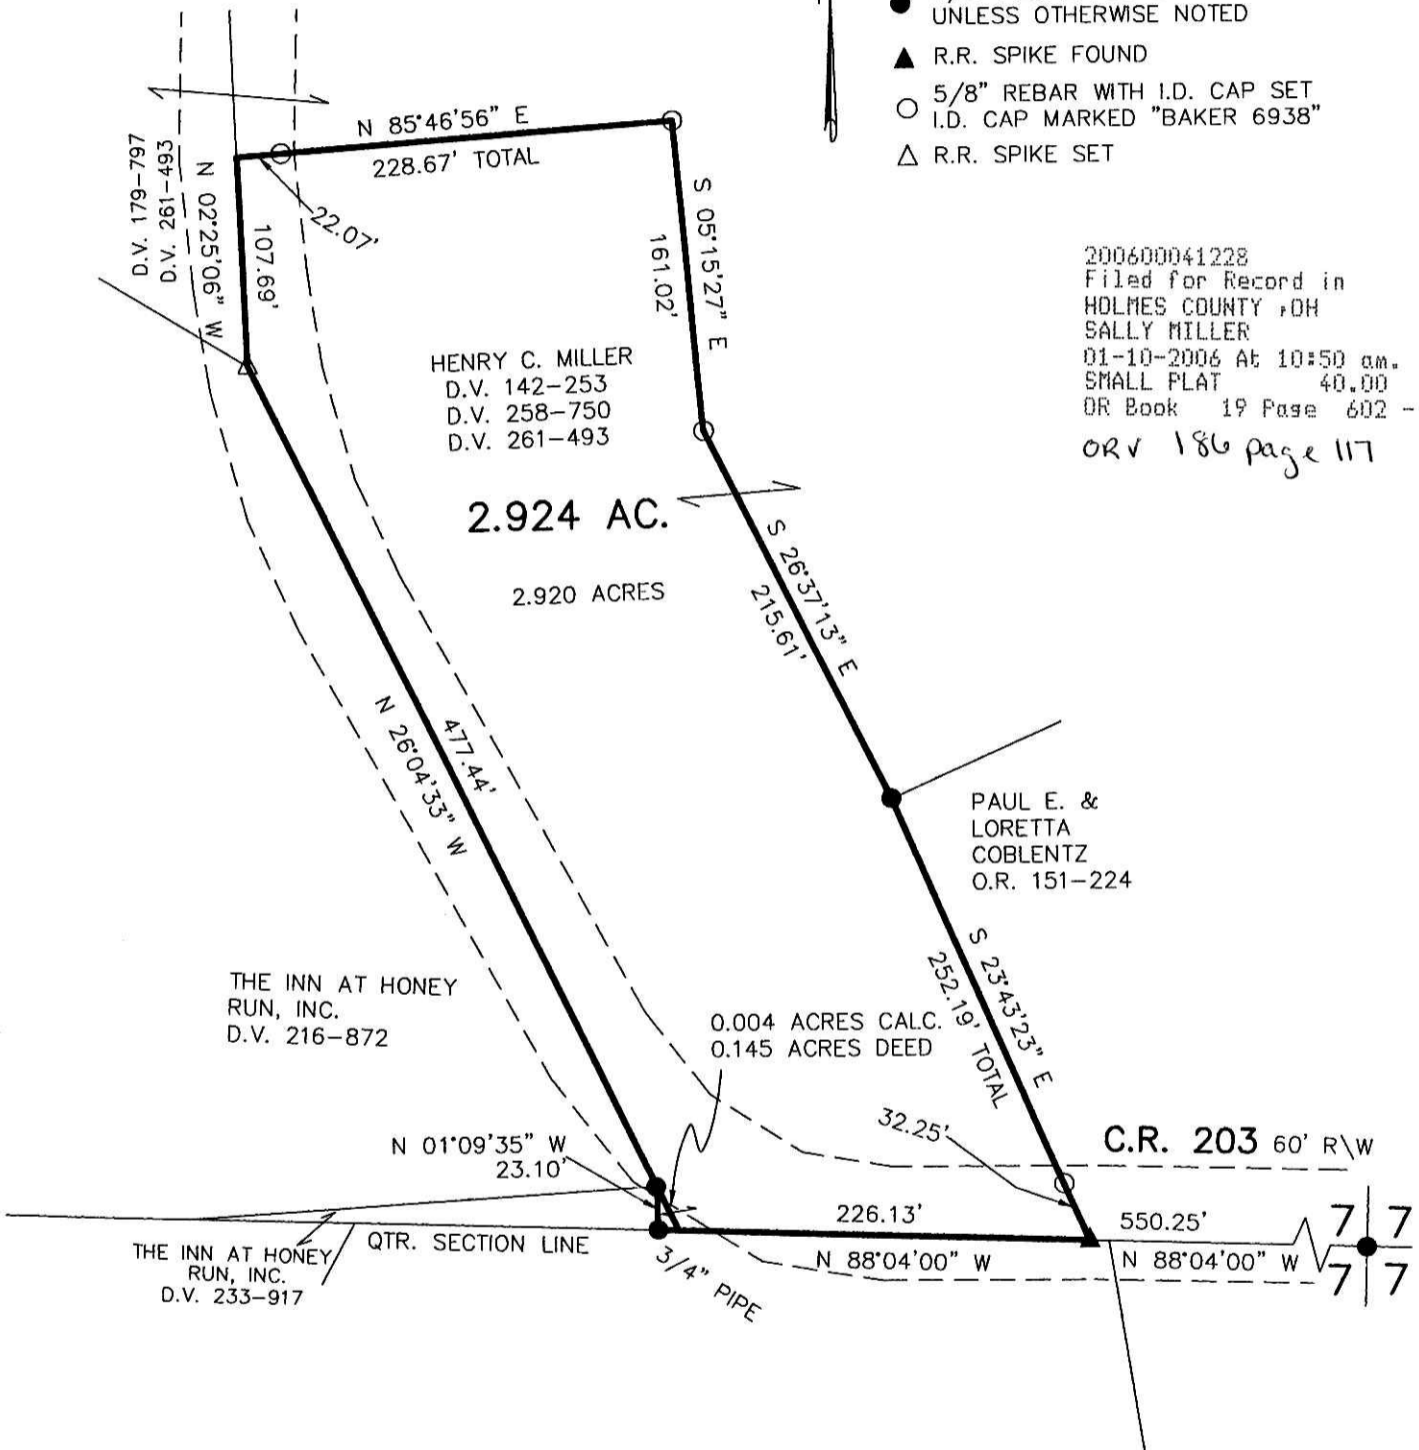


I CERTIFY THIS SURVEY TO BE CORRECT
TO THE BEST OF MY KNOWLEDGE.

JAMIE D. DARR P.S. 7755

DATE: SEPT. 23, 2005

JDD\KES
File Name: WORK2\S-620-05

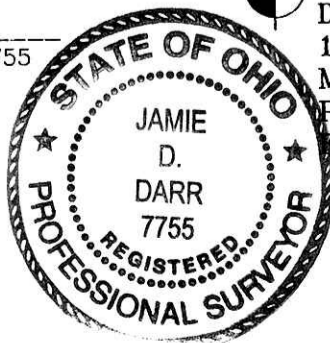

DONALD C. BAKER SURVEYING
138 N. CLAY ST.
MILLERSBURG, OHIO, 44654
PH. 330-674-4788
FAX. 330-674-6027

PLAT APPROVED:

10/17/2005