


200600041256
Filed for Record in
HOLMES COUNTY, OH
SALLY MILLER
01-10-2006 At 03:12 pm.
SMALL PLAT 40.00
OR Book 19 Page 604 - 604
ORV 186 pages 218+222

PLAT OF CORRECTION

THIS PLAT IS TO CORRECT THE BEGINNING
POINT OF O.R. 8 PG. 129 AT THE N.E. COR.
OF SECTION 3. SEE PLAT VOL. 19 PG. 135
SEE PLAT VOL. 19 PAGES 135 & 136



**MECHANIC TOWNSHIP
N.E. QTR. FRACTIONAL SECTION 3
T-8 N; R-6 W
HOLMES COUNTY, OHIO**

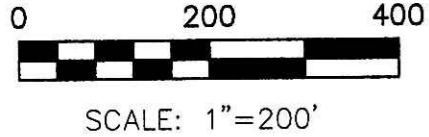

- 5/8" REBAR FOUND
UNLESS OTHERWISE NOTED
- ▲ R.R. SPIKE FOUND
- STONE FOUND

REFERENCES

- DEED VOL. 204 PAGE 655
- DEED VOL. 212 PAGE 938
- O.R. VOL. 8 PAGE 129
- PLAT VOL. 14 PAGE 704
- PLAT VOL. 17 PAGE 227
- PLAT VOL. 7 PAGE 294
- PLAT VOL. 19 PAGE 135
- PLAT VOL. 19 PAGE 136
- BEARINGS FROM PLAT VOL 19 PAGE 135

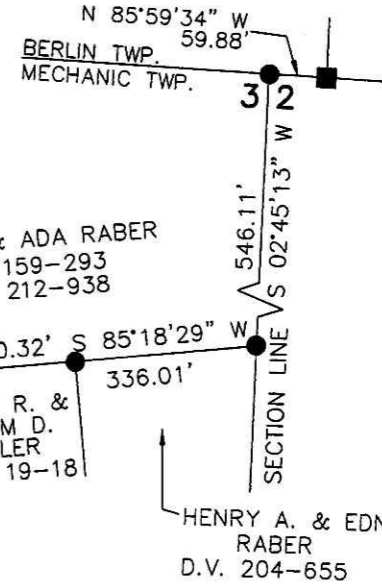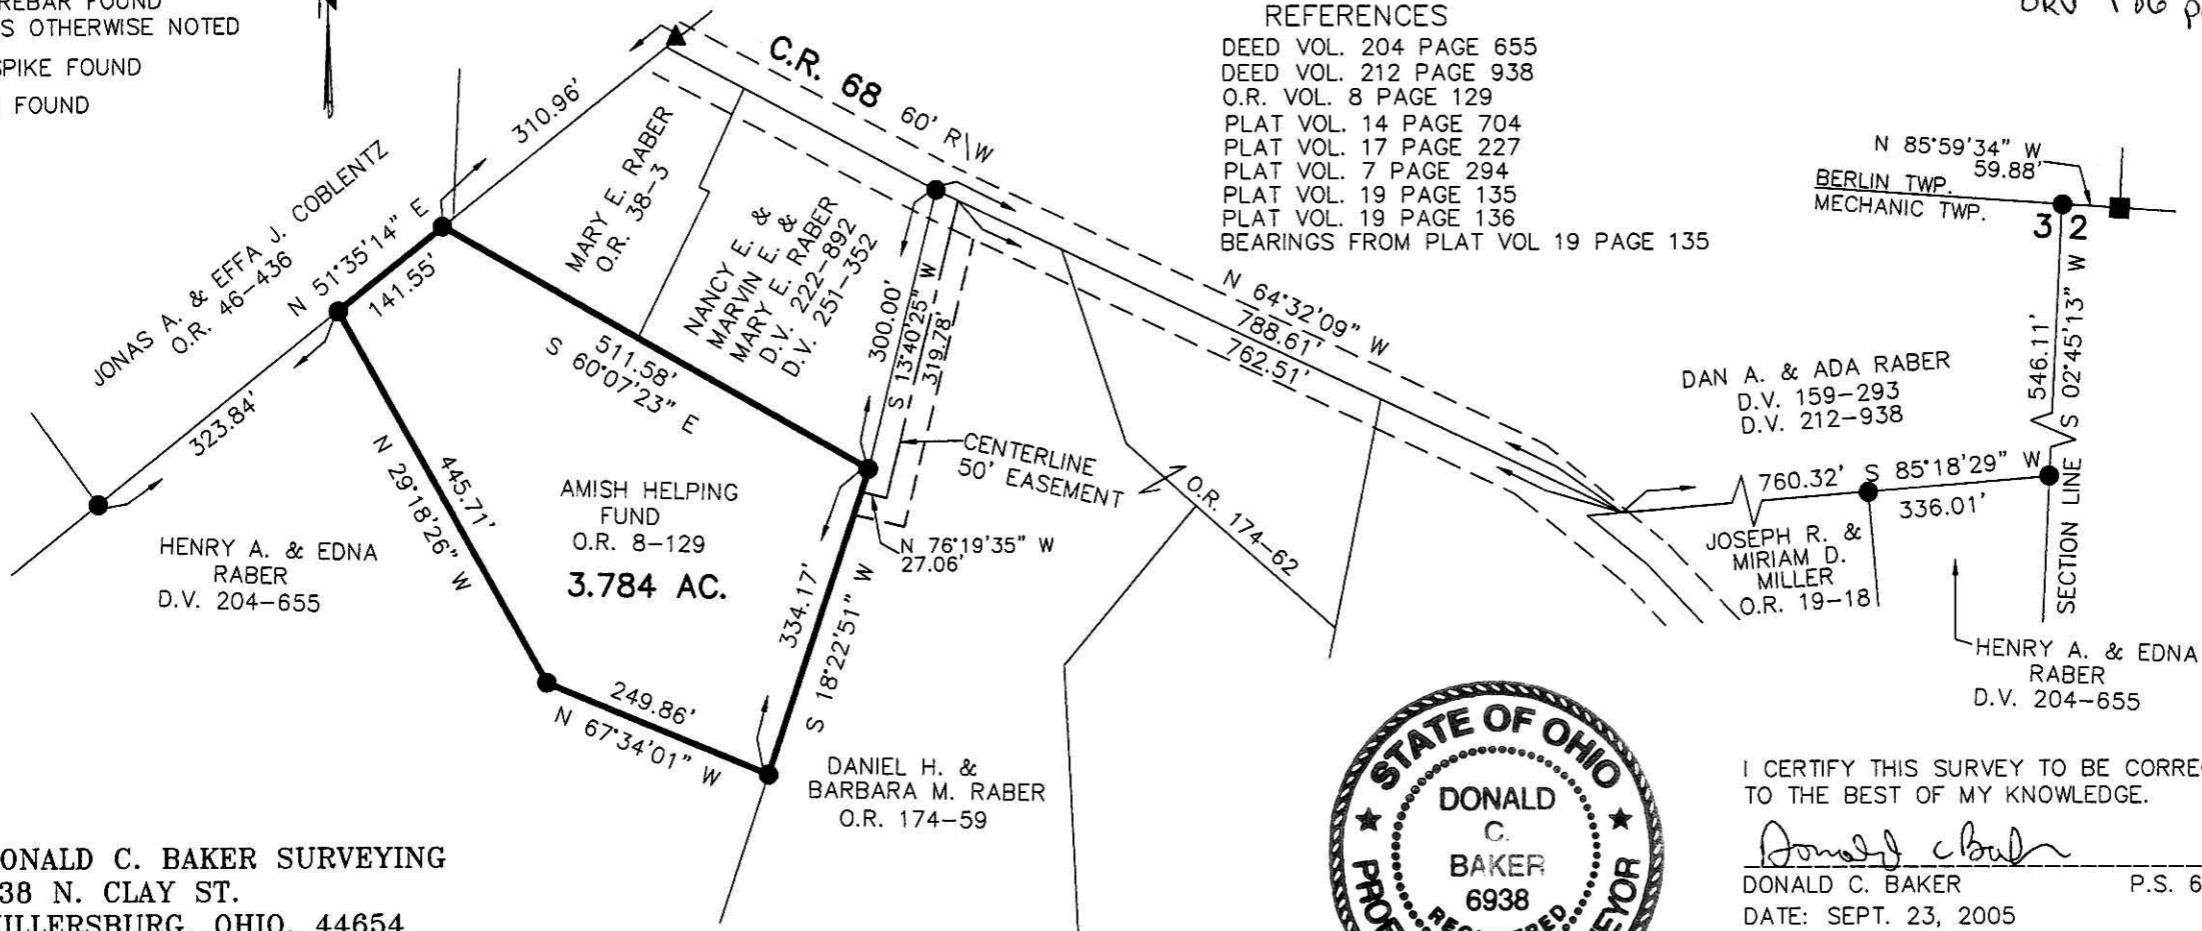

DONALD C. BAKER SURVEYING
138 N. CLAY ST.
MILLERSBURG, OHIO, 44654
PH. 330-674-4788
FAX. 330-674-6027



I CERTIFY THIS SURVEY TO BE CORRECT
TO THE BEST OF MY KNOWLEDGE.

Donald C. Baker
DONALD C. BAKER P.S. 6938
DATE: SEPT. 23, 2005
File Name: WORK2\S-652-05

PLAT APPROVED

12/12/2005

Instrument 200600041256 DR Book 19 Page 604