


REFERENCES:  
DEED VOL. 279 PAGE 633  
DEED VOL. 279 PAGE 556  
DEED VOL. 219 PAGE 273  
O.R. VOL. 36 PAGE 641  
PLAT VOL. 16 PAGE 515


BEARINGS FROM PLAT VOL. 14 PAGE 2

HARDY TOWNSHIP  
S.W. QTR. SECTION 12  
S.E. QTR. SECTION 13  
T-9 N; R-7 W  
HOLMES COUNTY, OHIO  
SURVEYED FOR: JOHN HIP

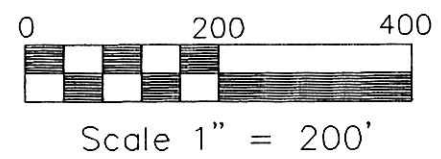

- STONE FOUND
- ▲ R.R. SPIKE FOUND
- 5/8" REBAR FOUND UNLESS OTHERWISE NOTED
- 5/8" REBAR WITH I.D. CAP SET I.D. CAP MARKED "BAKER 6938"
- △ R.R. SPIKE SET
- ⊙ MAG NAIL SET

200600041635  
Filed for Record in  
HOLMES COUNTY, OH  
SALLY MILLER  
02-03-2006 At 09:43 am.  
SMALL PLAT 40.00  
DR Book 19 Page 620 - 620  
CRV 186 page 1761+1763

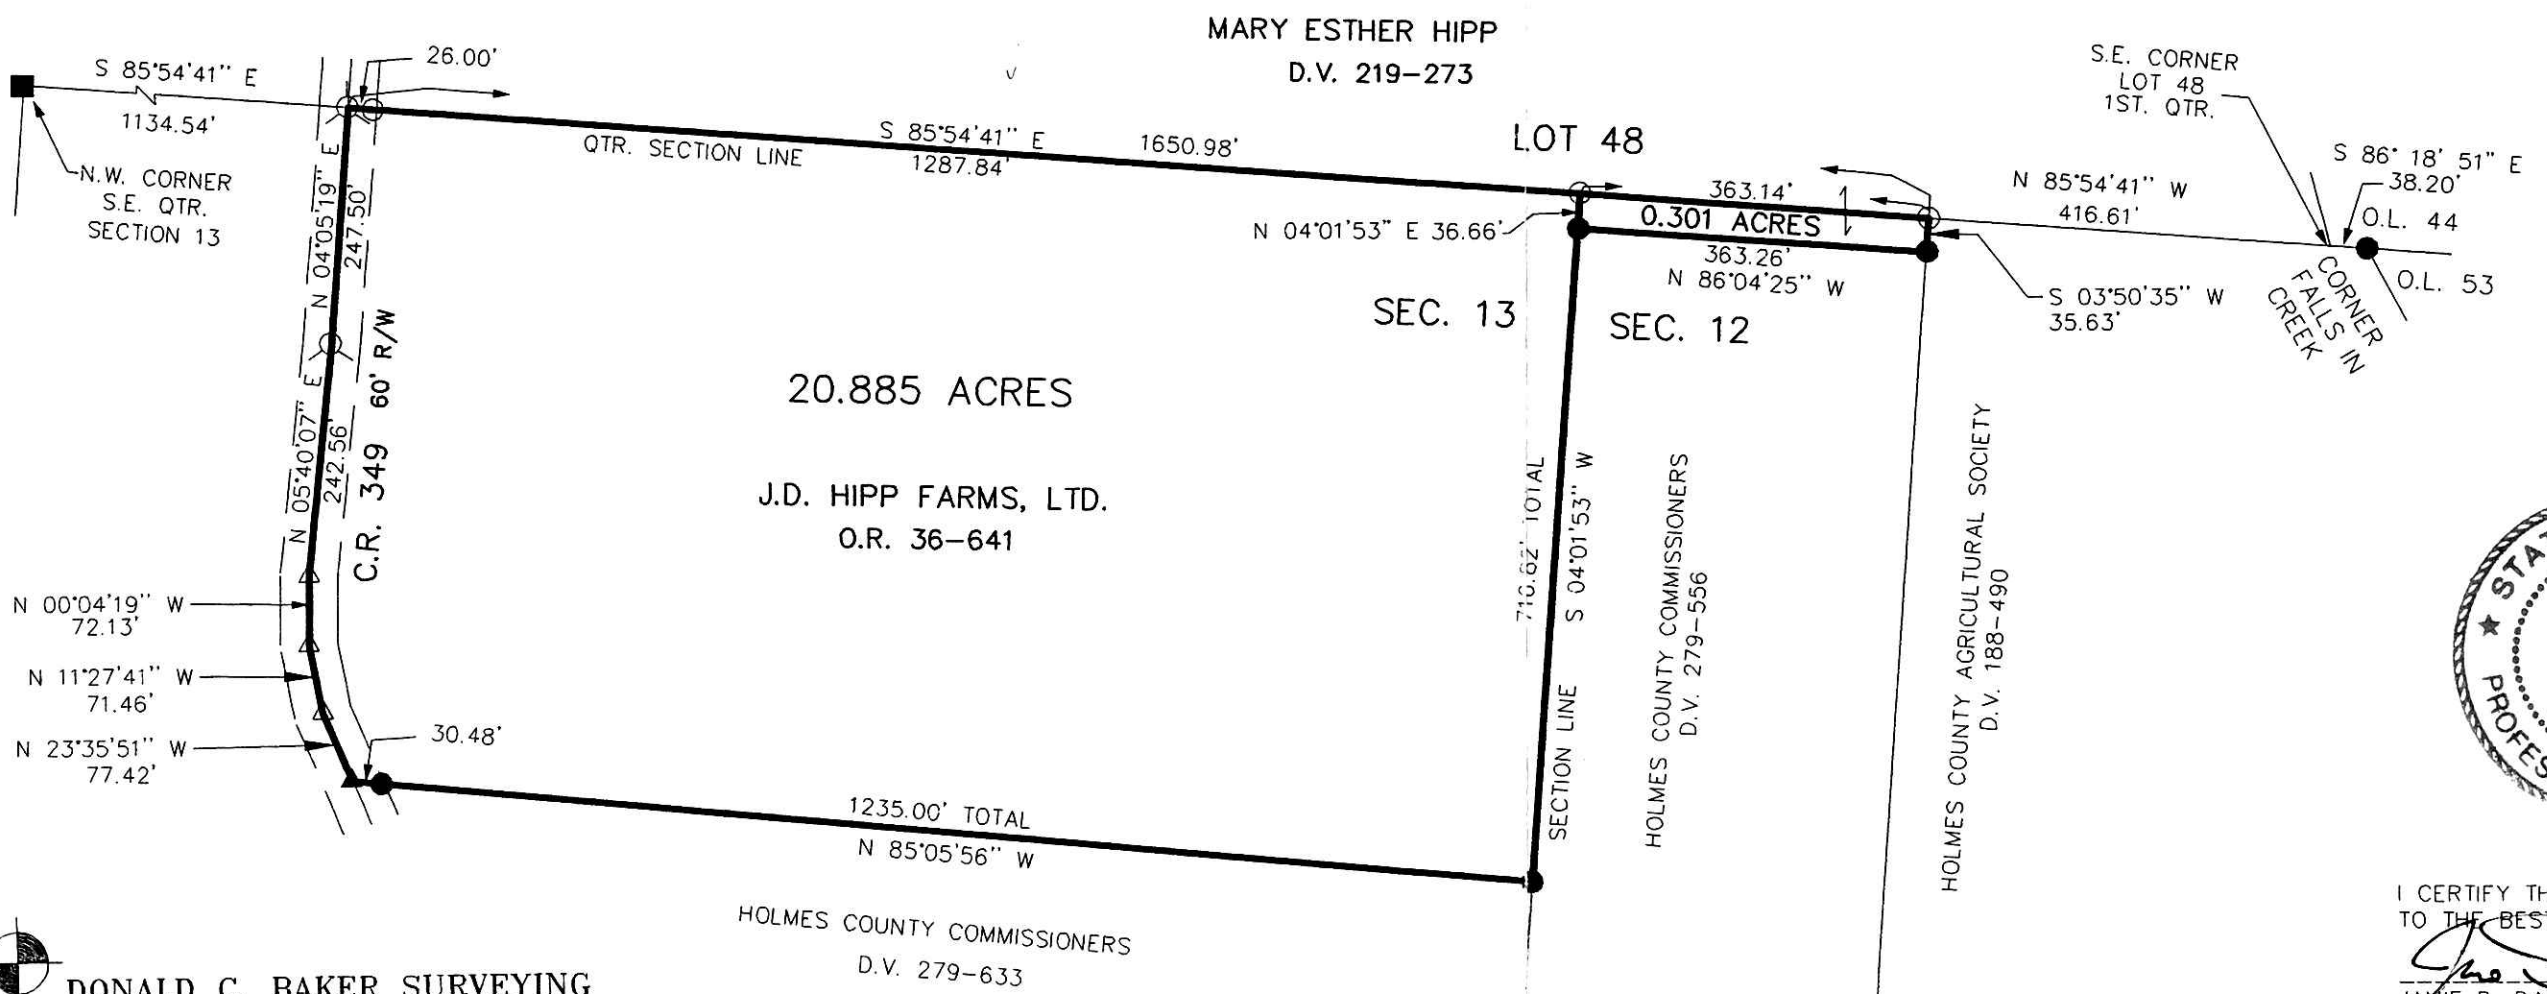

200600041635  
CRITCHFIELD...  
& JOHNSTON ATTYS  
MILLERSBURG, OH



Instrument Book Page  
200600041635 DR 19 620

I CERTIFY THIS SURVEY TO BE CORRECT TO THE BEST OF MY KNOWLEDGE.

*J. D. Darr*  
JAMIE D. DARR P.S. 7755  
DATE: SEPTEMBER 27, 2004

JDD/ERZ  
File name: C:\JOBS1\S-641-04\MLD

PLAT APPROVED

1/27/2006-4

DONALD C. BAKER SURVEYING  
138 N. CLAY ST.  
MILLERSBURG, OHIO 44654  
PH. 330-674-4788  
FAX 330-674-6027