

200600042387  
 Filed for Record in  
 HOLMES COUNTY, OH  
 SALLY MILLER  
 03-20-2006 At 03:26 pm.  
 SMALL PLAT 40.00  
 OR Book 19 Page 655 - 655  
 ORV 187 page 1553  
 RECORDERS SPACE

WAYNE COUNTY TITLE  
 141 E LIBERTY ST  
 WOOSTER, OH 44691

BEARINGS ESTABLISHED FROM PLAT 12/22  
 AND ARE TO DENOTE ANGULAR MEAS. ONLY.




Instrument Book Page  
 200600042387 OR 19 655

- LEGEND:
- = STONE FD.
  - = 5/8" RE-BAR FD. UNLESS NOTED
  - = POINT-OF-DEPARTURE
  - = 5/8" X 30" RE-BAR W/PLASTIC I.D. CAP SET
  - ⊗ = R/R SPIKE SET
  - △ = R/R SPIKE FD.

**HEARTLAND SURVEYING, INC**

Jim Shamp  
 5210 T.R. 257 MILLERSBURG, OH 44654  
 PH: 330-674-4698 FAX: 330-674-0897

SURVEY		STATE	
JOHN C. BUREN		OHIO	
COUNTY	TWP.	RNG.	TWP.
HOLMES	RIPLEY	14 W	17 N
S.E. QUARTER OF SECTION 15			JOB NO. 001114.CRD 001114B.PL LAY 44

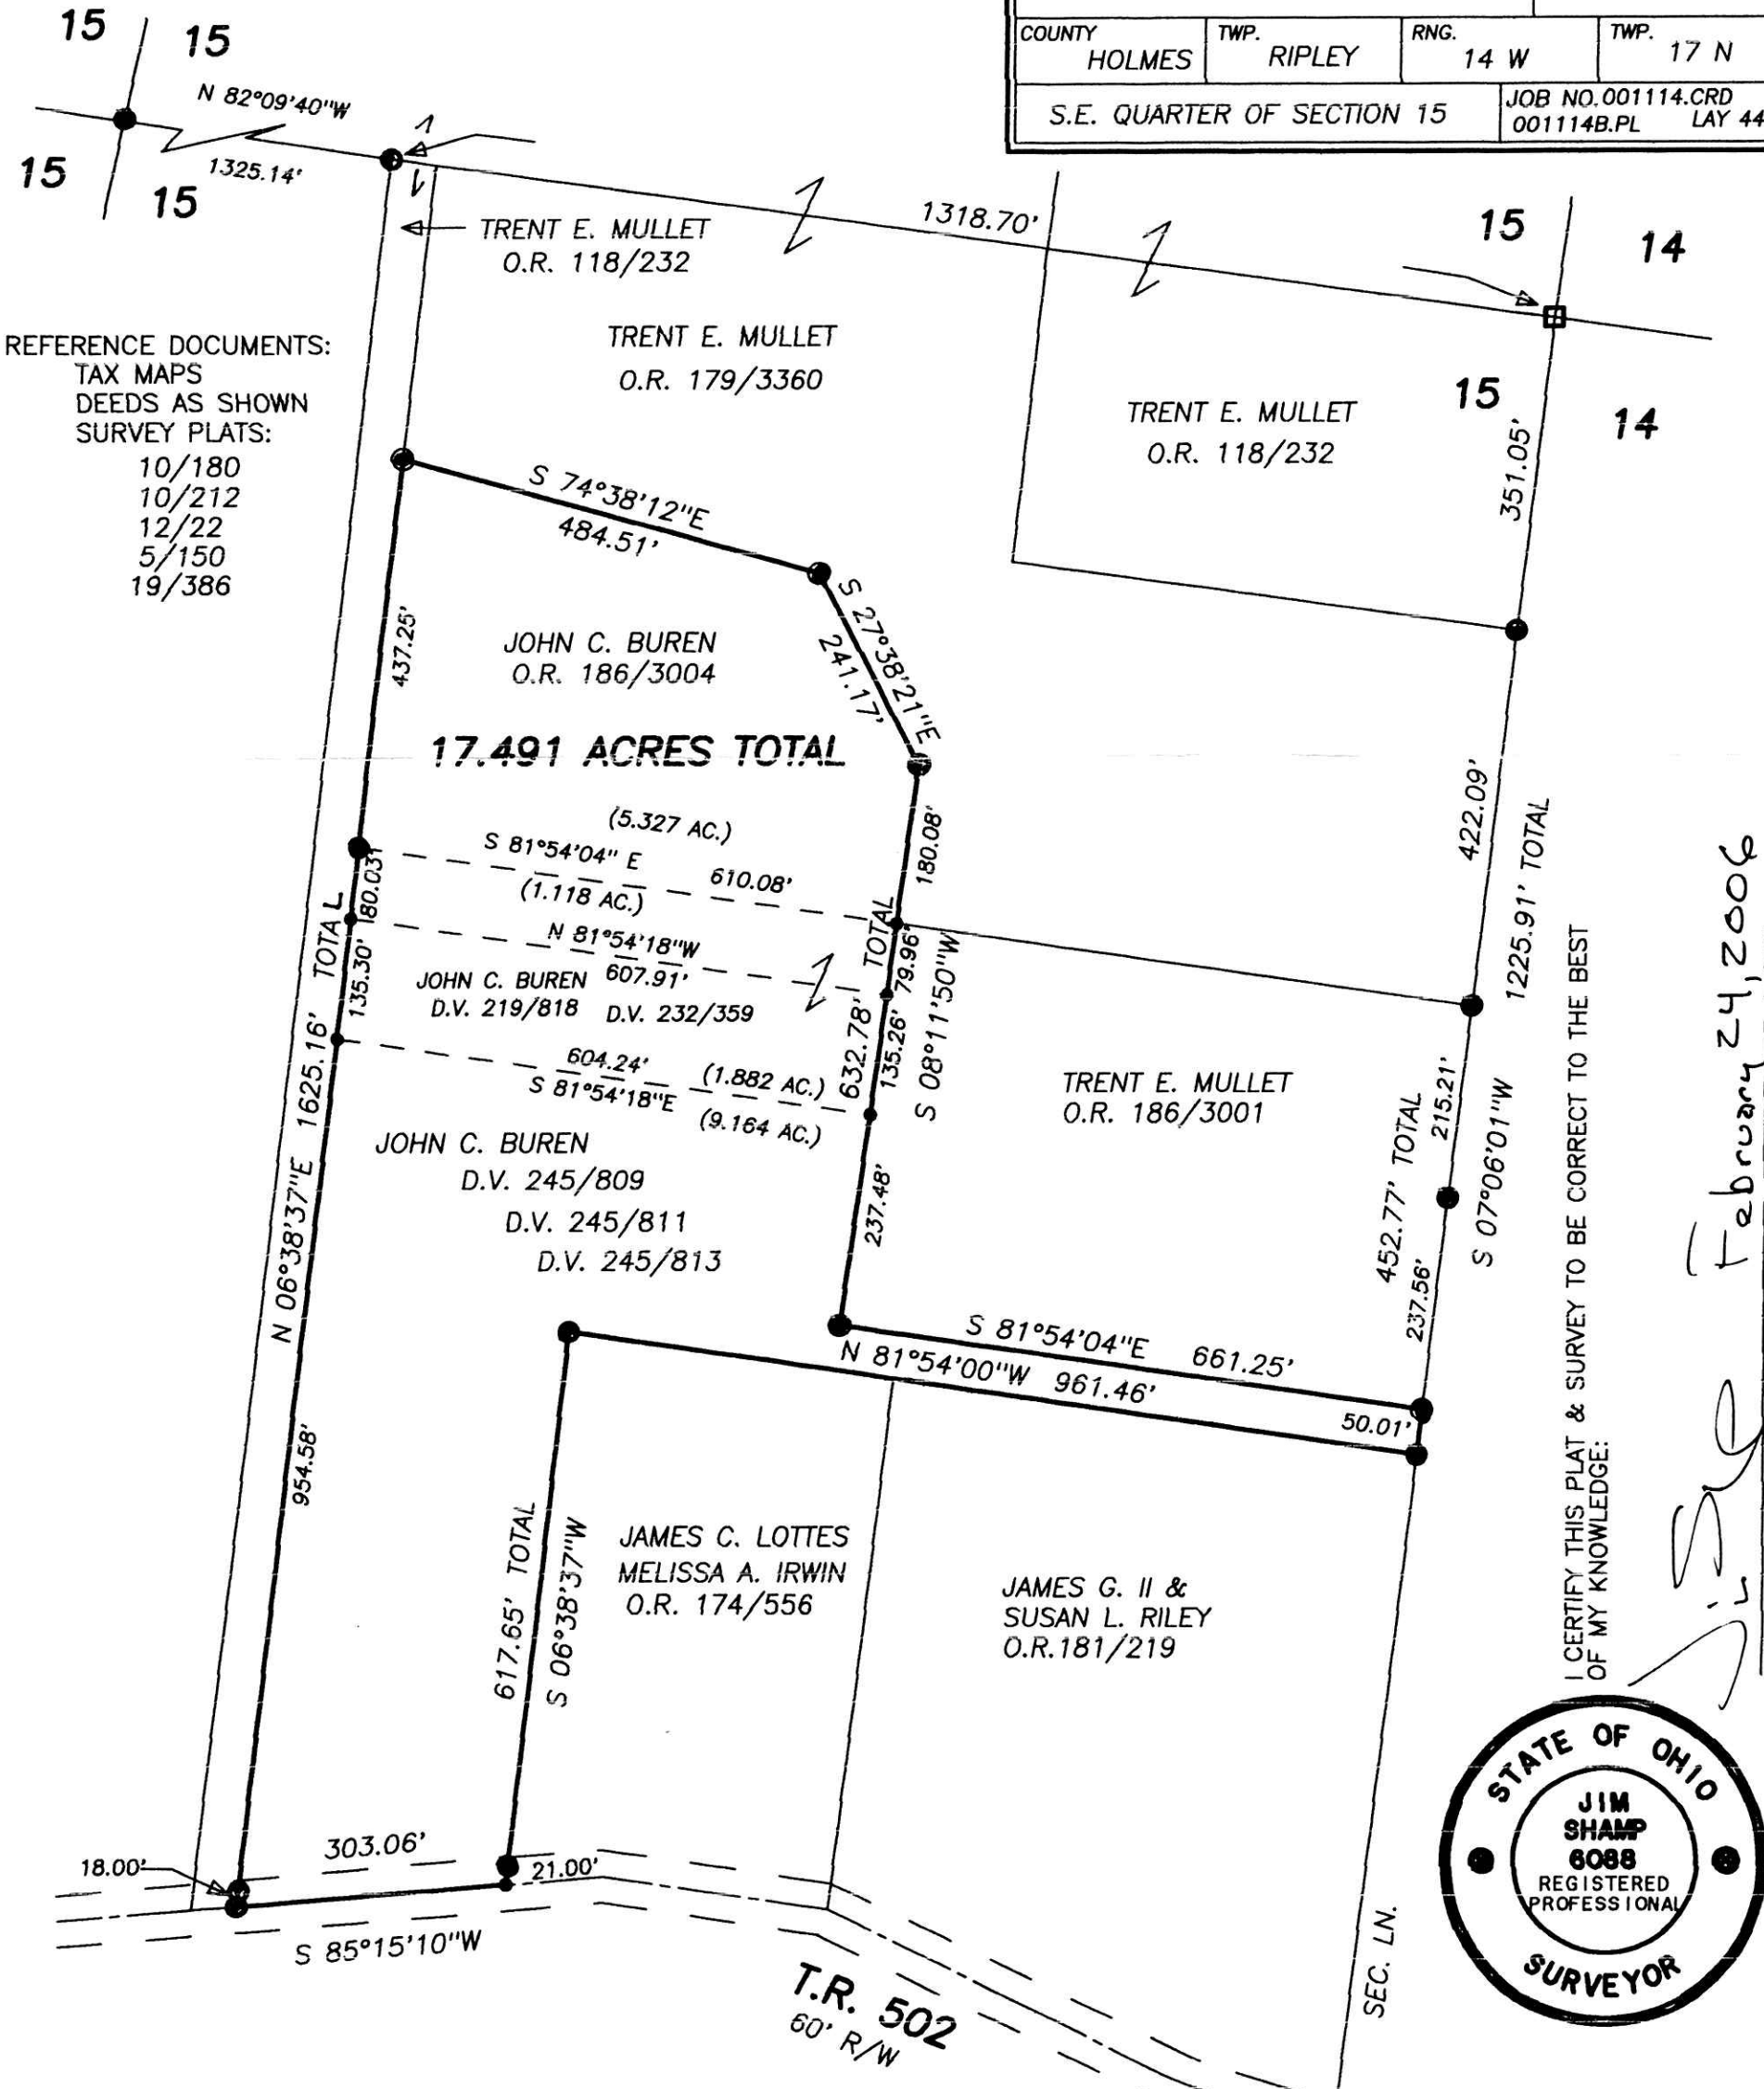

- REFERENCE DOCUMENTS:  
 TAX MAPS  
 DEEDS AS SHOWN  
 SURVEY PLATS:
- 10/180
  - 10/212
  - 12/22
  - 5/150
  - 19/386

I CERTIFY THIS PLAT & SURVEY TO BE CORRECT TO THE BEST OF MY KNOWLEDGE:

Jim Shamp February 24, 2006

JIM SHAMP, REG. SUR. NO. S-6088 DATE



PLAT APPROVED

3/2/2006