

200600042898
Filed for Record in
HOLMES COUNTY, OH
SALLY MILLER
04-17-2006 At 02:35 pm.
SMALL PLAT 40.00
OR Book 19 Page 677 - 677
orv 188 page 391

WASHINGTON TOWNSHIP
S.E. QTR. SECTION 26
T-20 N; R-15 W
HOLMES COUNTY OHIO

SURVEYED FOR: ROGER STITZLEIN

0 60 120



SCALE: 1"=60'


- P.K. NAIL FOUND
- ▲ R.R. SPIKE FOUND
- 5/8" REBAR FOUND UNLESS OTHERWISE NOTED
- 5/8" REBAR SET WITH I.D. CAP I.D. CAP MARKED "BAKER 6938"

REFERENCES

DEED VOL. 118 PAGE 367
DEED VOL. 226 PAGE 908
PLAT VOL. 11 PAGE 25
BEARINGS FROM PLAT VOL. 11 PAGE 367

NOTE: THIS 0.222 AC. TRACT OVERLAPS DEED VOL. 226 PAGE 908, HOWEVER, DEED VOL. 226 PAGE 908 WAS A RESURVEY OF DEED VOL. 181 PAGE 528 AND THIS DEED NEVER COVERED THIS AREA. SO DEED VOL 118 PAGE 367 HAS SENIOR RIGHTS.

Instrument Book Page
200600042898 OR 19 677

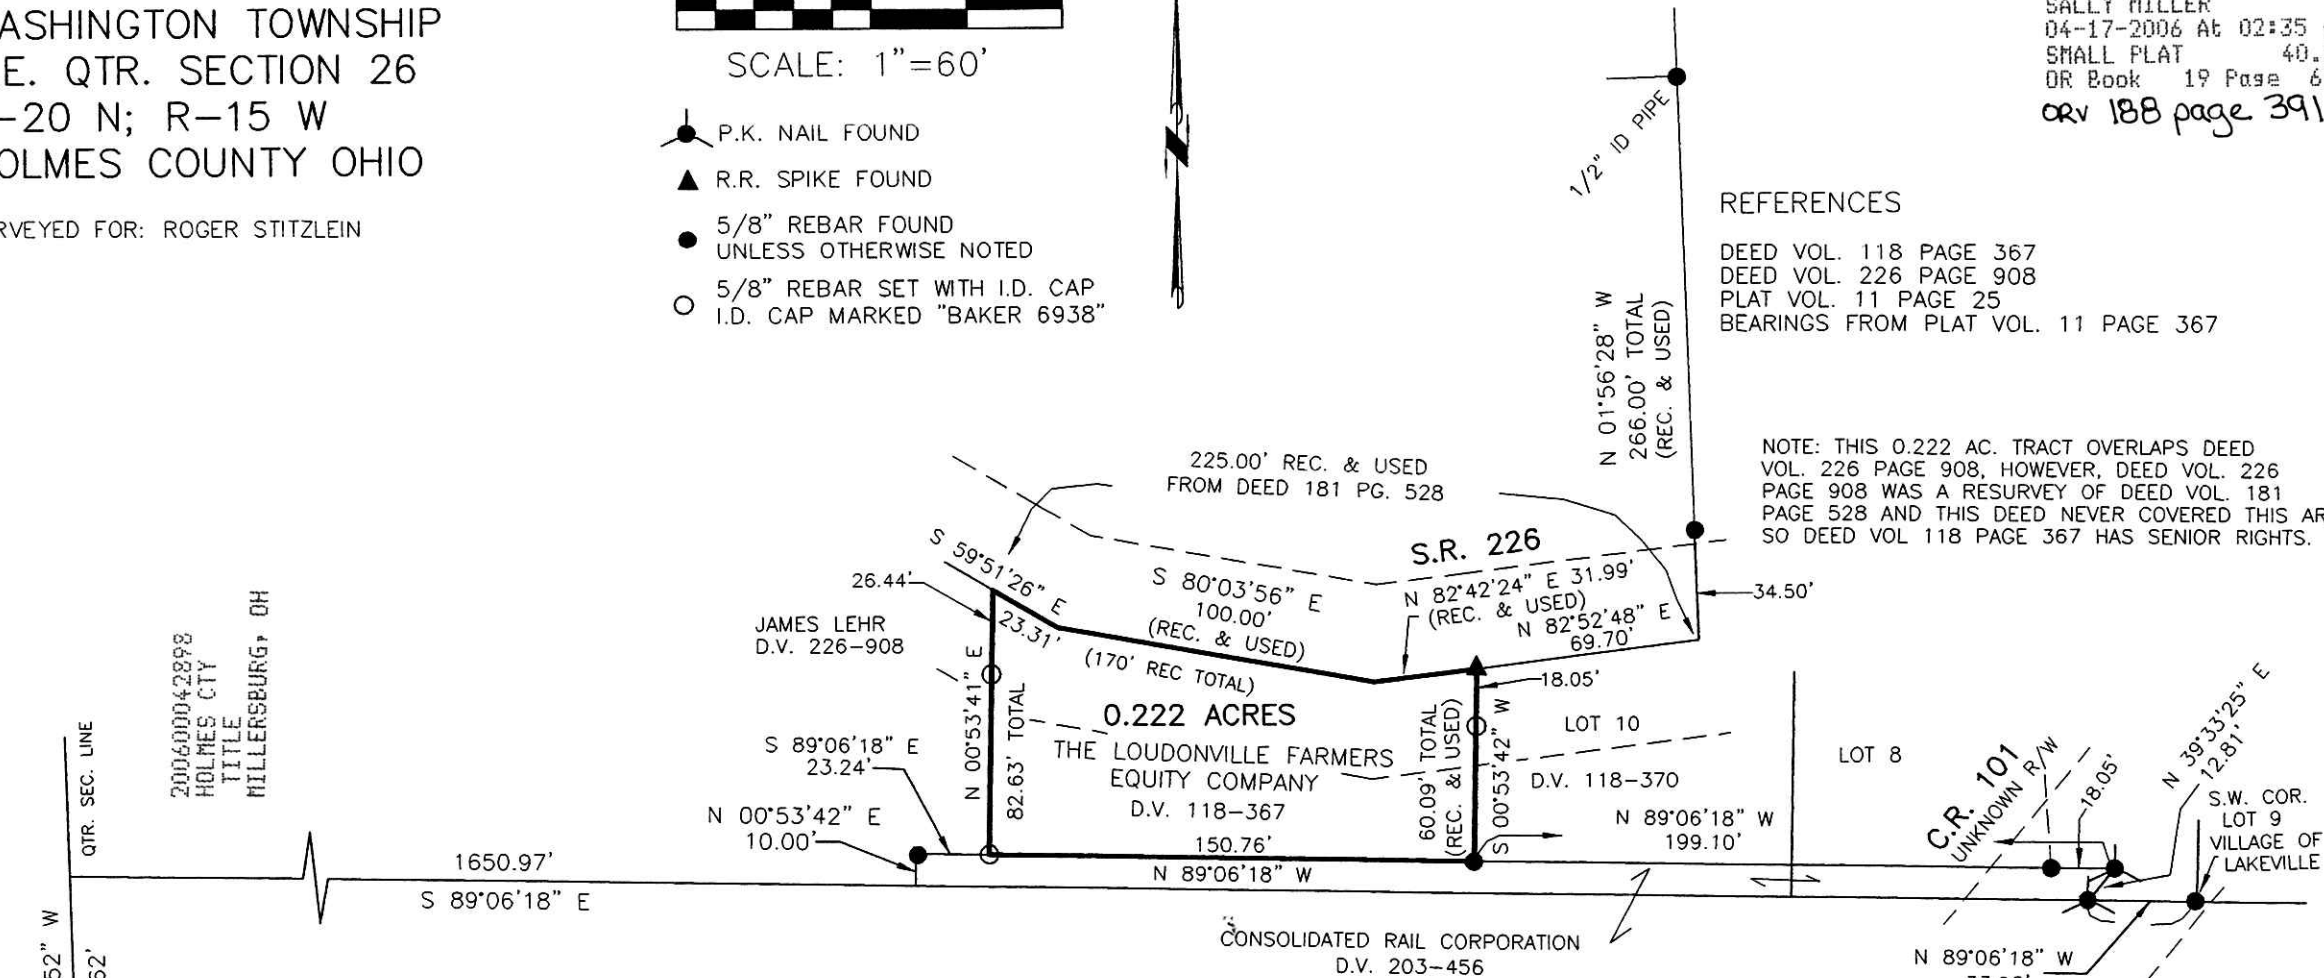

I CERTIFY THIS SURVEY TO BE CORRECT TO THE BEST OF MY KNOWLEDGE.

Jamie D. Darr
 JAMIE D. DARR P.S. 7755
 DATE: MARCH 9, 2006
 JDD\ERZ
 FILE NAME: WORK3\S-75-06\MLD



DONALD C. BAKER SURVEYING
138 N. CLAY STREET
MILLERSBURG, OHIO 44654
PH. 330-674-4788
FAX 330-674-6027

PLAT APPROVED

4/11/2006