

RETRACEMENT SURVEY OF D.V. 273-47
 WALNUT CREEK TOWNSHIP
 3RD. QTR., LOT 3
 T-9 N; R-5 W
 HOLMES COUNTY, OHIO


SURVEYED FOR: MARY RABER

REFERENCES:

- DEED VOL. 142 PAGES 472 & 475
- DEED VOL. 155 PAGE 1
- DEED VOL. 219 PAGE 576
- DEED VOL. 245 PAGE 949
- DEED VOL. 273 PAGE 47

- PLAT VOL. 11 PAGE 149
- PLAT VOL. 12 PAGES 305 & 306
- PLAT VOL. 14 PAGE 887
- PLAT VOL. 16 PAGE 625
- PLAT VOL. 17 PAGE 642


BEARINGS FROM PLAT VOL. 12 PAGE 306

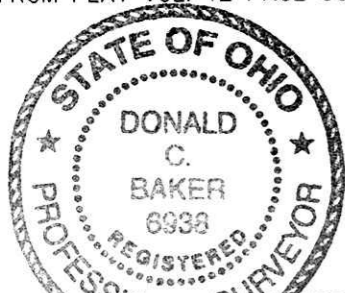

I CERTIFY THIS SURVEY TO BE CORRECT TO THE BEST OF MY KNOWLEDGE.

Donald C. Baker

DONALD C. BAKER PS 6938
 DATE: FEB. 1, 2006
 FDB\AEG
 File Name: WORK\S-1-06\ERZ

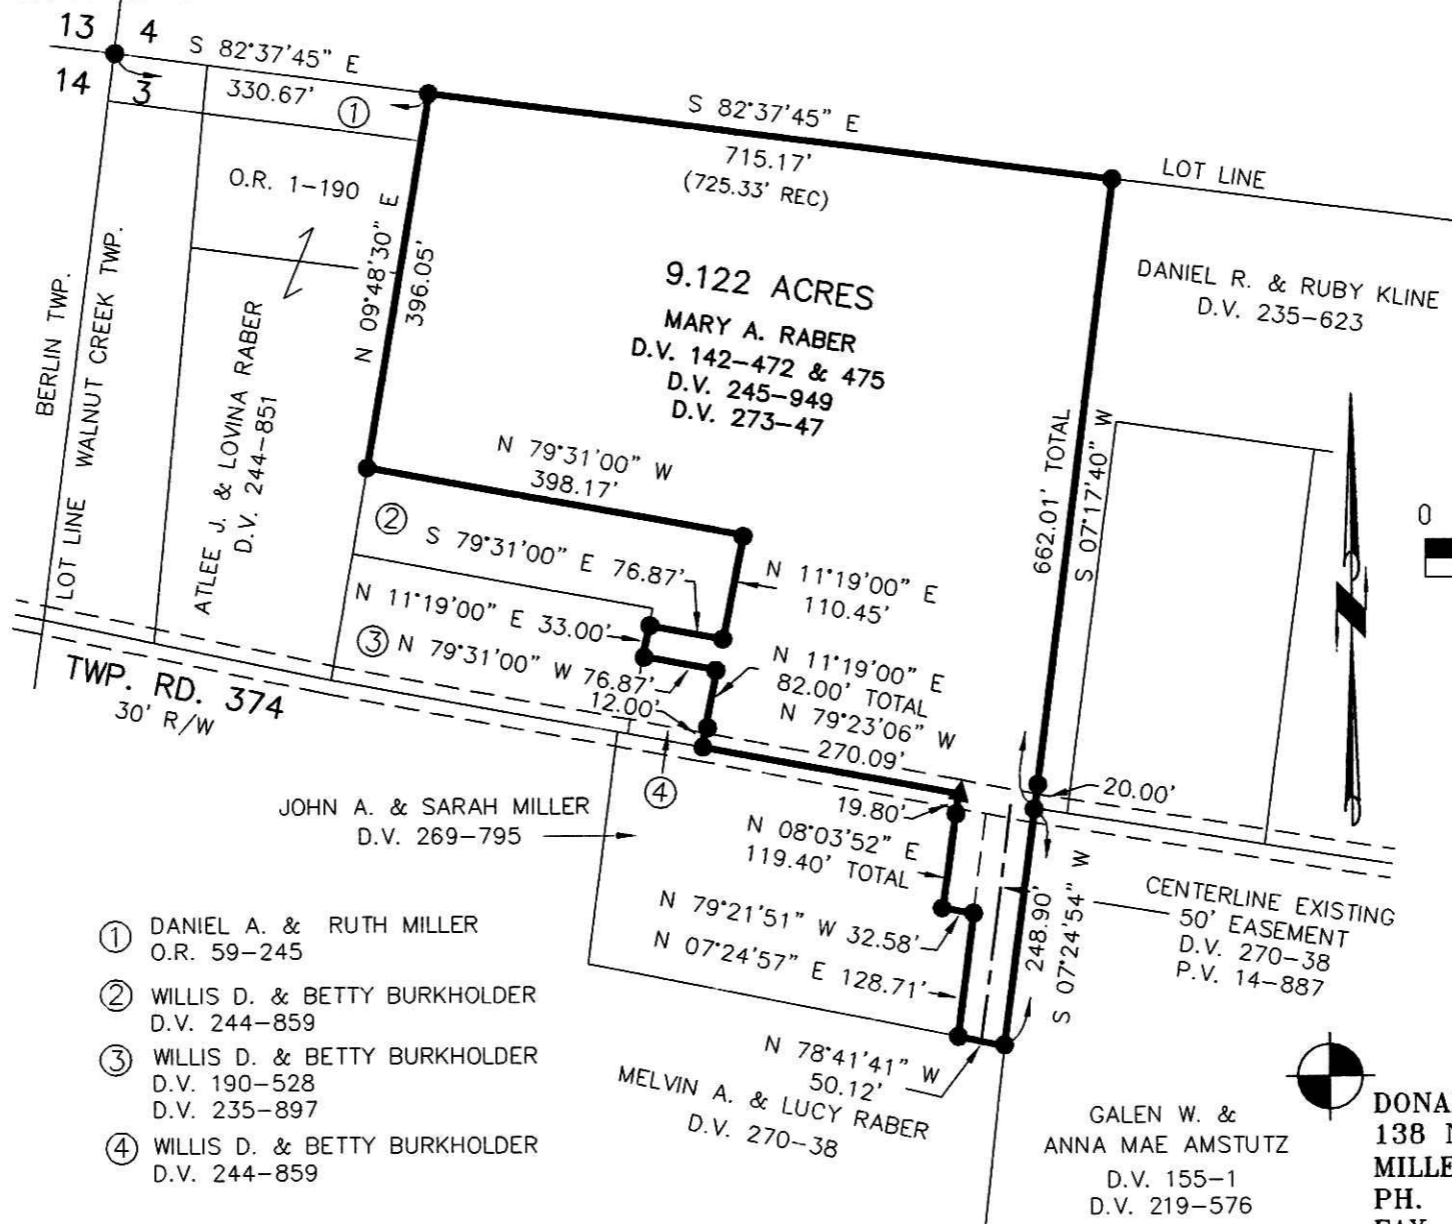

200600043023
 CRITCHFIELD...
 & JOHNSTON ATTYS
 MILLERSBURG, OH


200600043023
 Filed for Record in
 HOLMES COUNTY, OH
 SALLY MILLER
 04-24-2006 At 10:59 am.
 SMALL PLAT 40.00
 DR Book 19 Page 683 - 683

OR 188 p 856



SCALE: 1"=200'

- ▲ R.R. SPIKE FOUND
- 5/8" REBAR FOUND

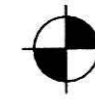

DONALD C. BAKER SURVEYING
 138 N. CLAY ST.
 MILLERSBURG, OH 44654
 PH. 330-674-4788
 FAX: 330-674-6027

PLAT APPROVED

4/11/2006