

PAINT TOWNSHIP
3RD. QTR., LOTS 33 & 34
T-10 N; R-4 W
HOLMES COUNTY, OHIO



SURVEYED FOR: AMANDA TROYER

REFERENCES

- DEED VOL. 193 PAGE 259
- DEED VOL. 266 PAGE 742
- O.R. VOL. 27 PAGE 719
- O.R. VOL. 142 PAGE 237
- PLAT VOL. 6 PAGE 35
- PLAT VOL. 15 PAGES 99 & 136
- PLAT VOL. 17 PAGES 99 & 739
- PLAT VOL. 18 PAGES 17, 168 & 776
- BEARINGS FROM PLAT VOL 15 PAGE 136

200600044550
Filed for Record in
HOLMES COUNTY, OH
SALLY MILLER
07-06-2006 At 08:54 am.
SMALL PLAT 40.00
OR Book 19 Page 752 - 752

OR 190 p 640

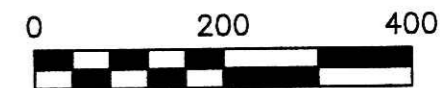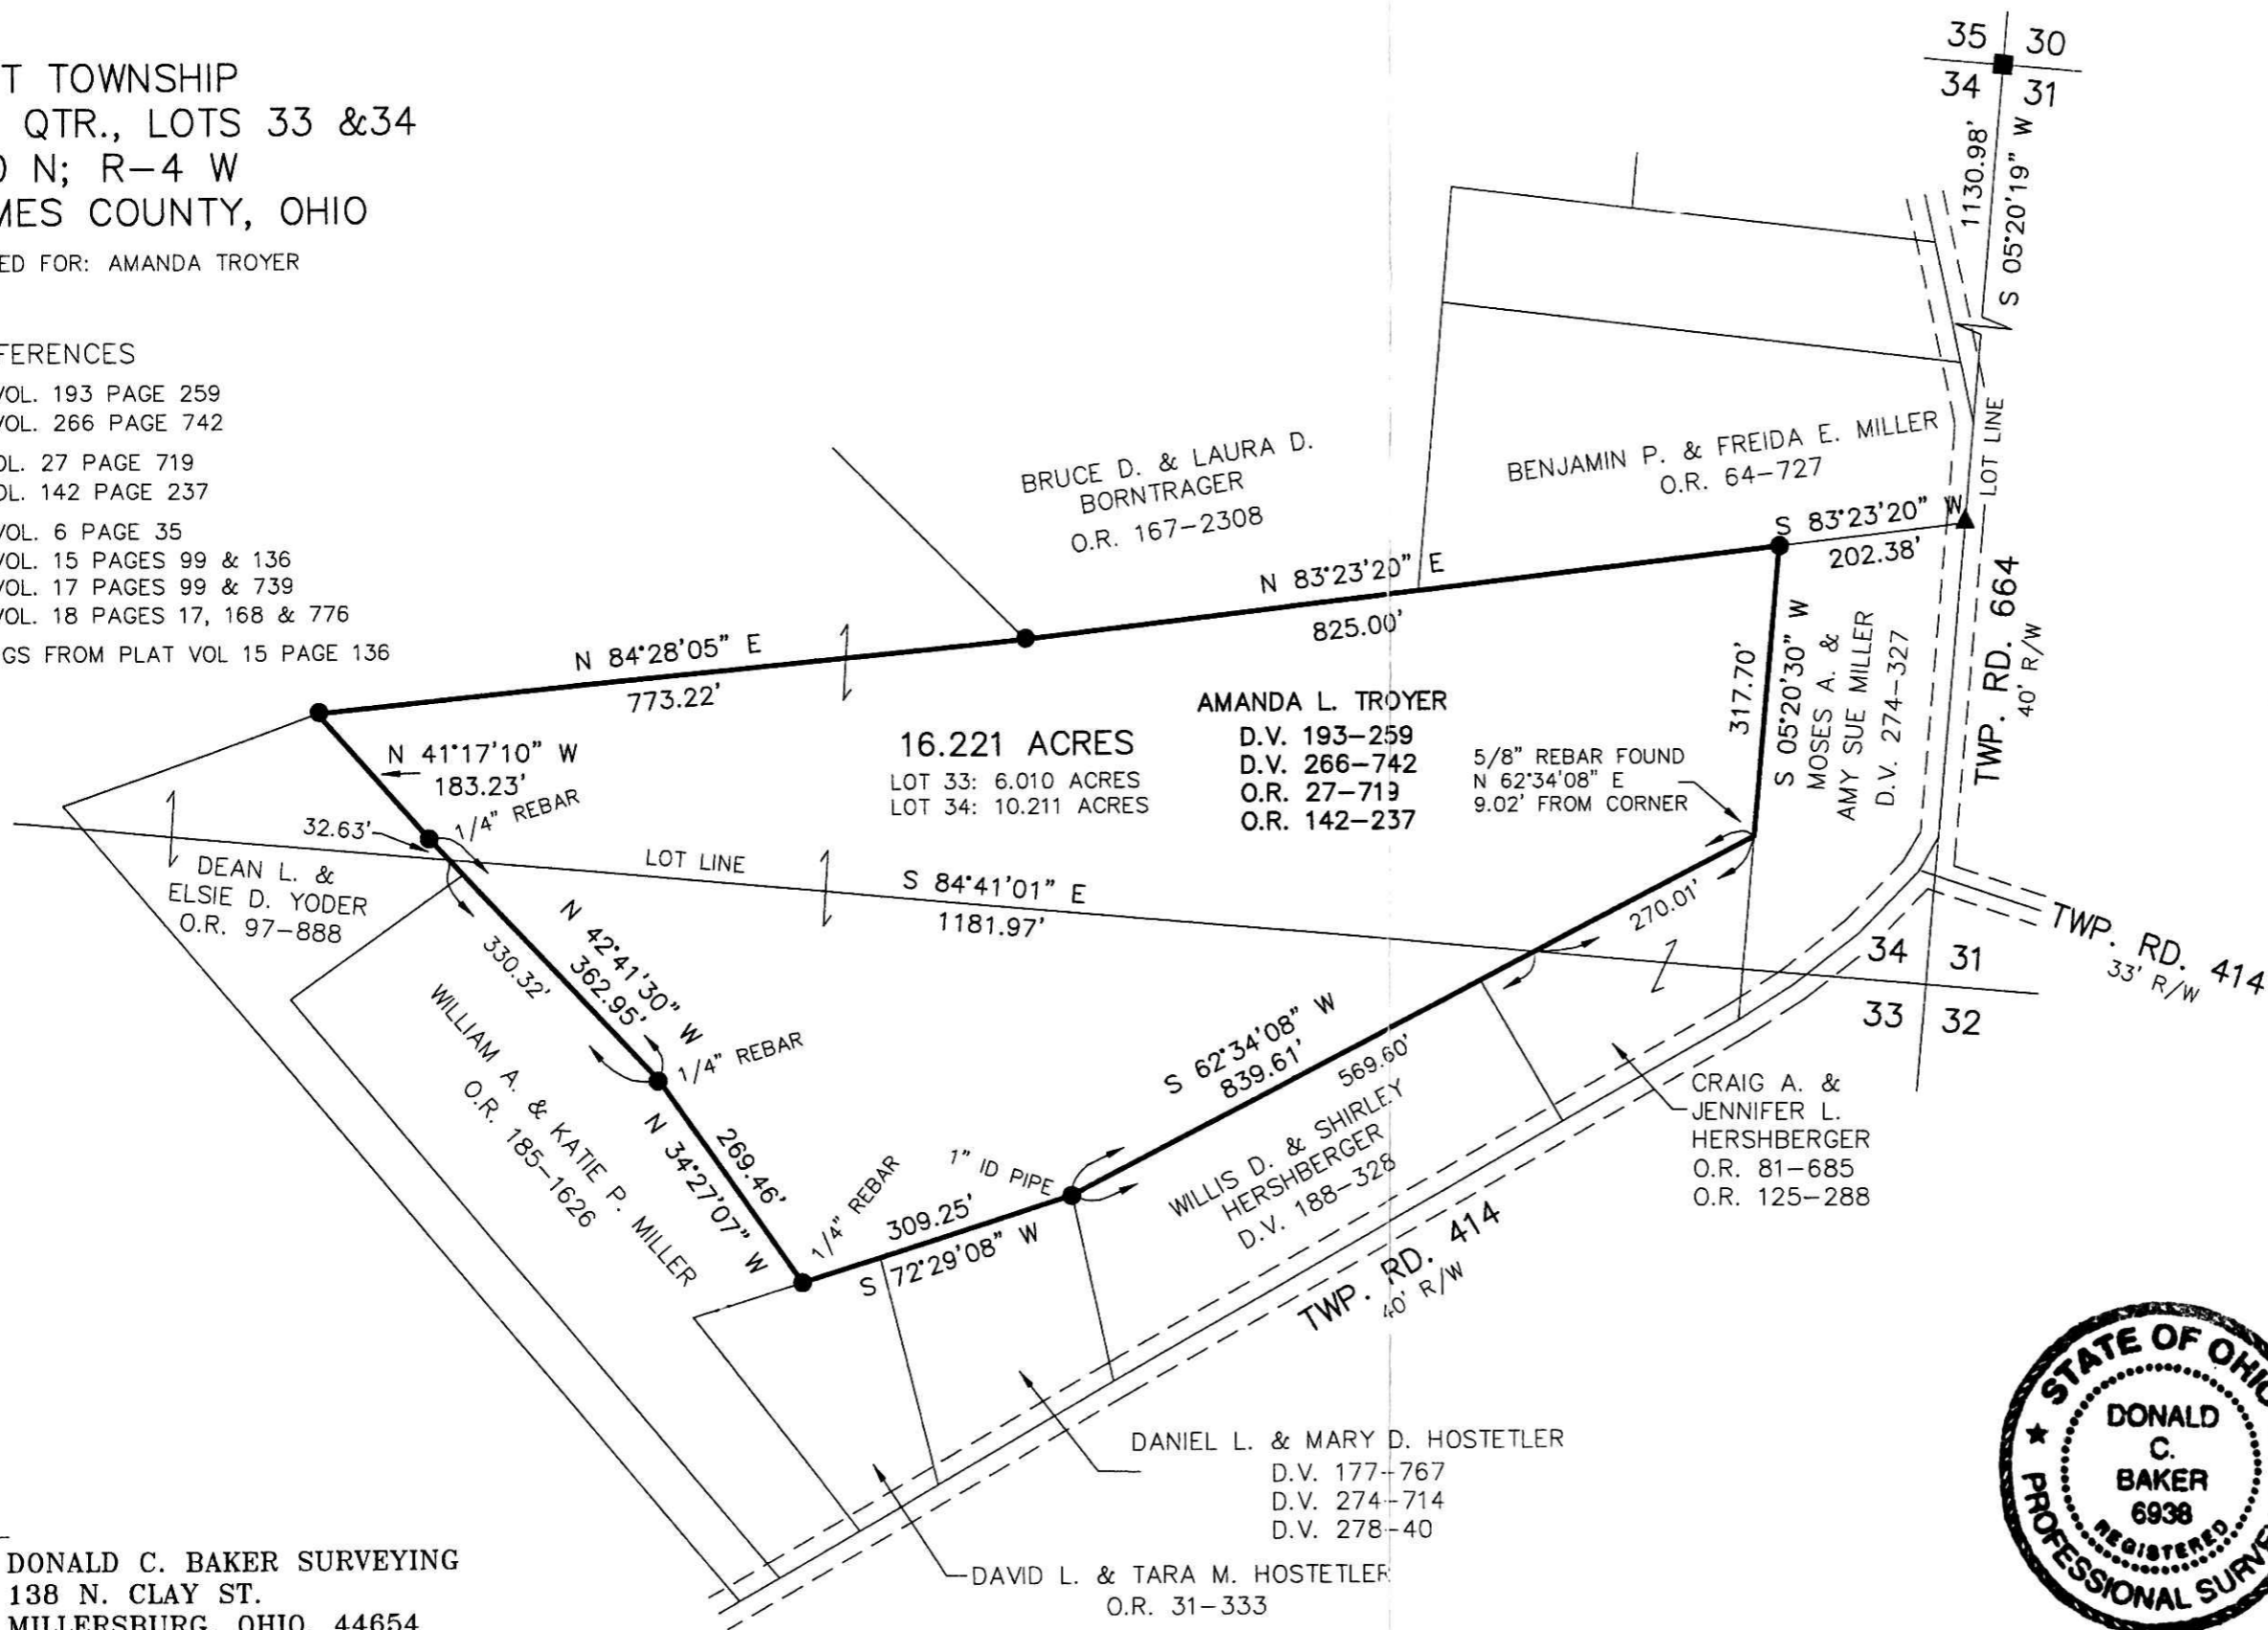

SCALE: 1"=200'

- STONE FOUND
- ▲ R.R. SPIKE FOUND
- 5/8" REBAR FOUND UNLESS OTHERWISE NOTED

200600044550
MILLER MAST
& MASON ATTYS
MILLERSBURG, OH

Instrument Book Page
200600044550 OR 19 752



DONALD C. BAKER SURVEYING
138 N. CLAY ST.
MILLERSBURG, OHIO, 44654
PH. 330-674-4788
FAX. 330-674-6027



I CERTIFY THIS SURVEY TO BE CORRECT TO THE BEST OF MY KNOWLEDGE.

Donald C. Baker
DONALD C. BAKER P.S. 6938
DATE: JUNE 7, 2006

FDB\AEG
File Name: WORK2\S-414-06\ERZ

PLAT APPROVED

6/26/2006