

RETRACEMENT SURVEY OF O.R. 192-2606

VILLAGE OF BENTON
 ABRAHAM MAST SUBDIVISION
 DEED VOL. 12 PAGE 323
 LOT 5 & PART OF LOT 6

SALT CREEK TOWNSHIP
 4TH. QTR., LOT 19
 T-10 N; R-6 W
 HOLMES COUNTY, OHIO

SURVEYED FOR: LOIS MENEZ

REFERENCES

- DEED VOL. 174 PAGE 286
- DEED VOL. 237 PAGE 799
- DEED VOL. 237 PAGE 799
- DEED VOL. 279 PAGE 535
- O.R. VOL. 157 PAGE 682
- O.R. VOL. 165 PAGES 417 & 430
- O.R. VOL. 176 PAGE 2612
- O.R. VOL. 181 PAGE 2465
- O.R. VOL. 192 PAGE 2606
- PLAT VOL. 11 PAGE 182
- PLAT VOL. 18 PAGES 740 & 741
- PLAT VOL. 12 PAGE 726
- BEARINGS FROM PLAT VOL 18 PAGE 741




I CERTIFY THIS SURVEY TO BE CORRECT TO THE BEST OF MY KNOWLEDGE.

Eric R. Zaugg
 ERIC R. ZAUGG P.S. 8309
 DATE: JAN 2, 2007

ERZ\FDB-KES
 File Name: WORK2\S-815-06\ERZ

DONALD C. BAKER SURVEYING
 138 N. CLAY ST.
 MILLERSBURG, OHIO, 44654
 PH. 330-674-4788
 FAX. 330-674-6027

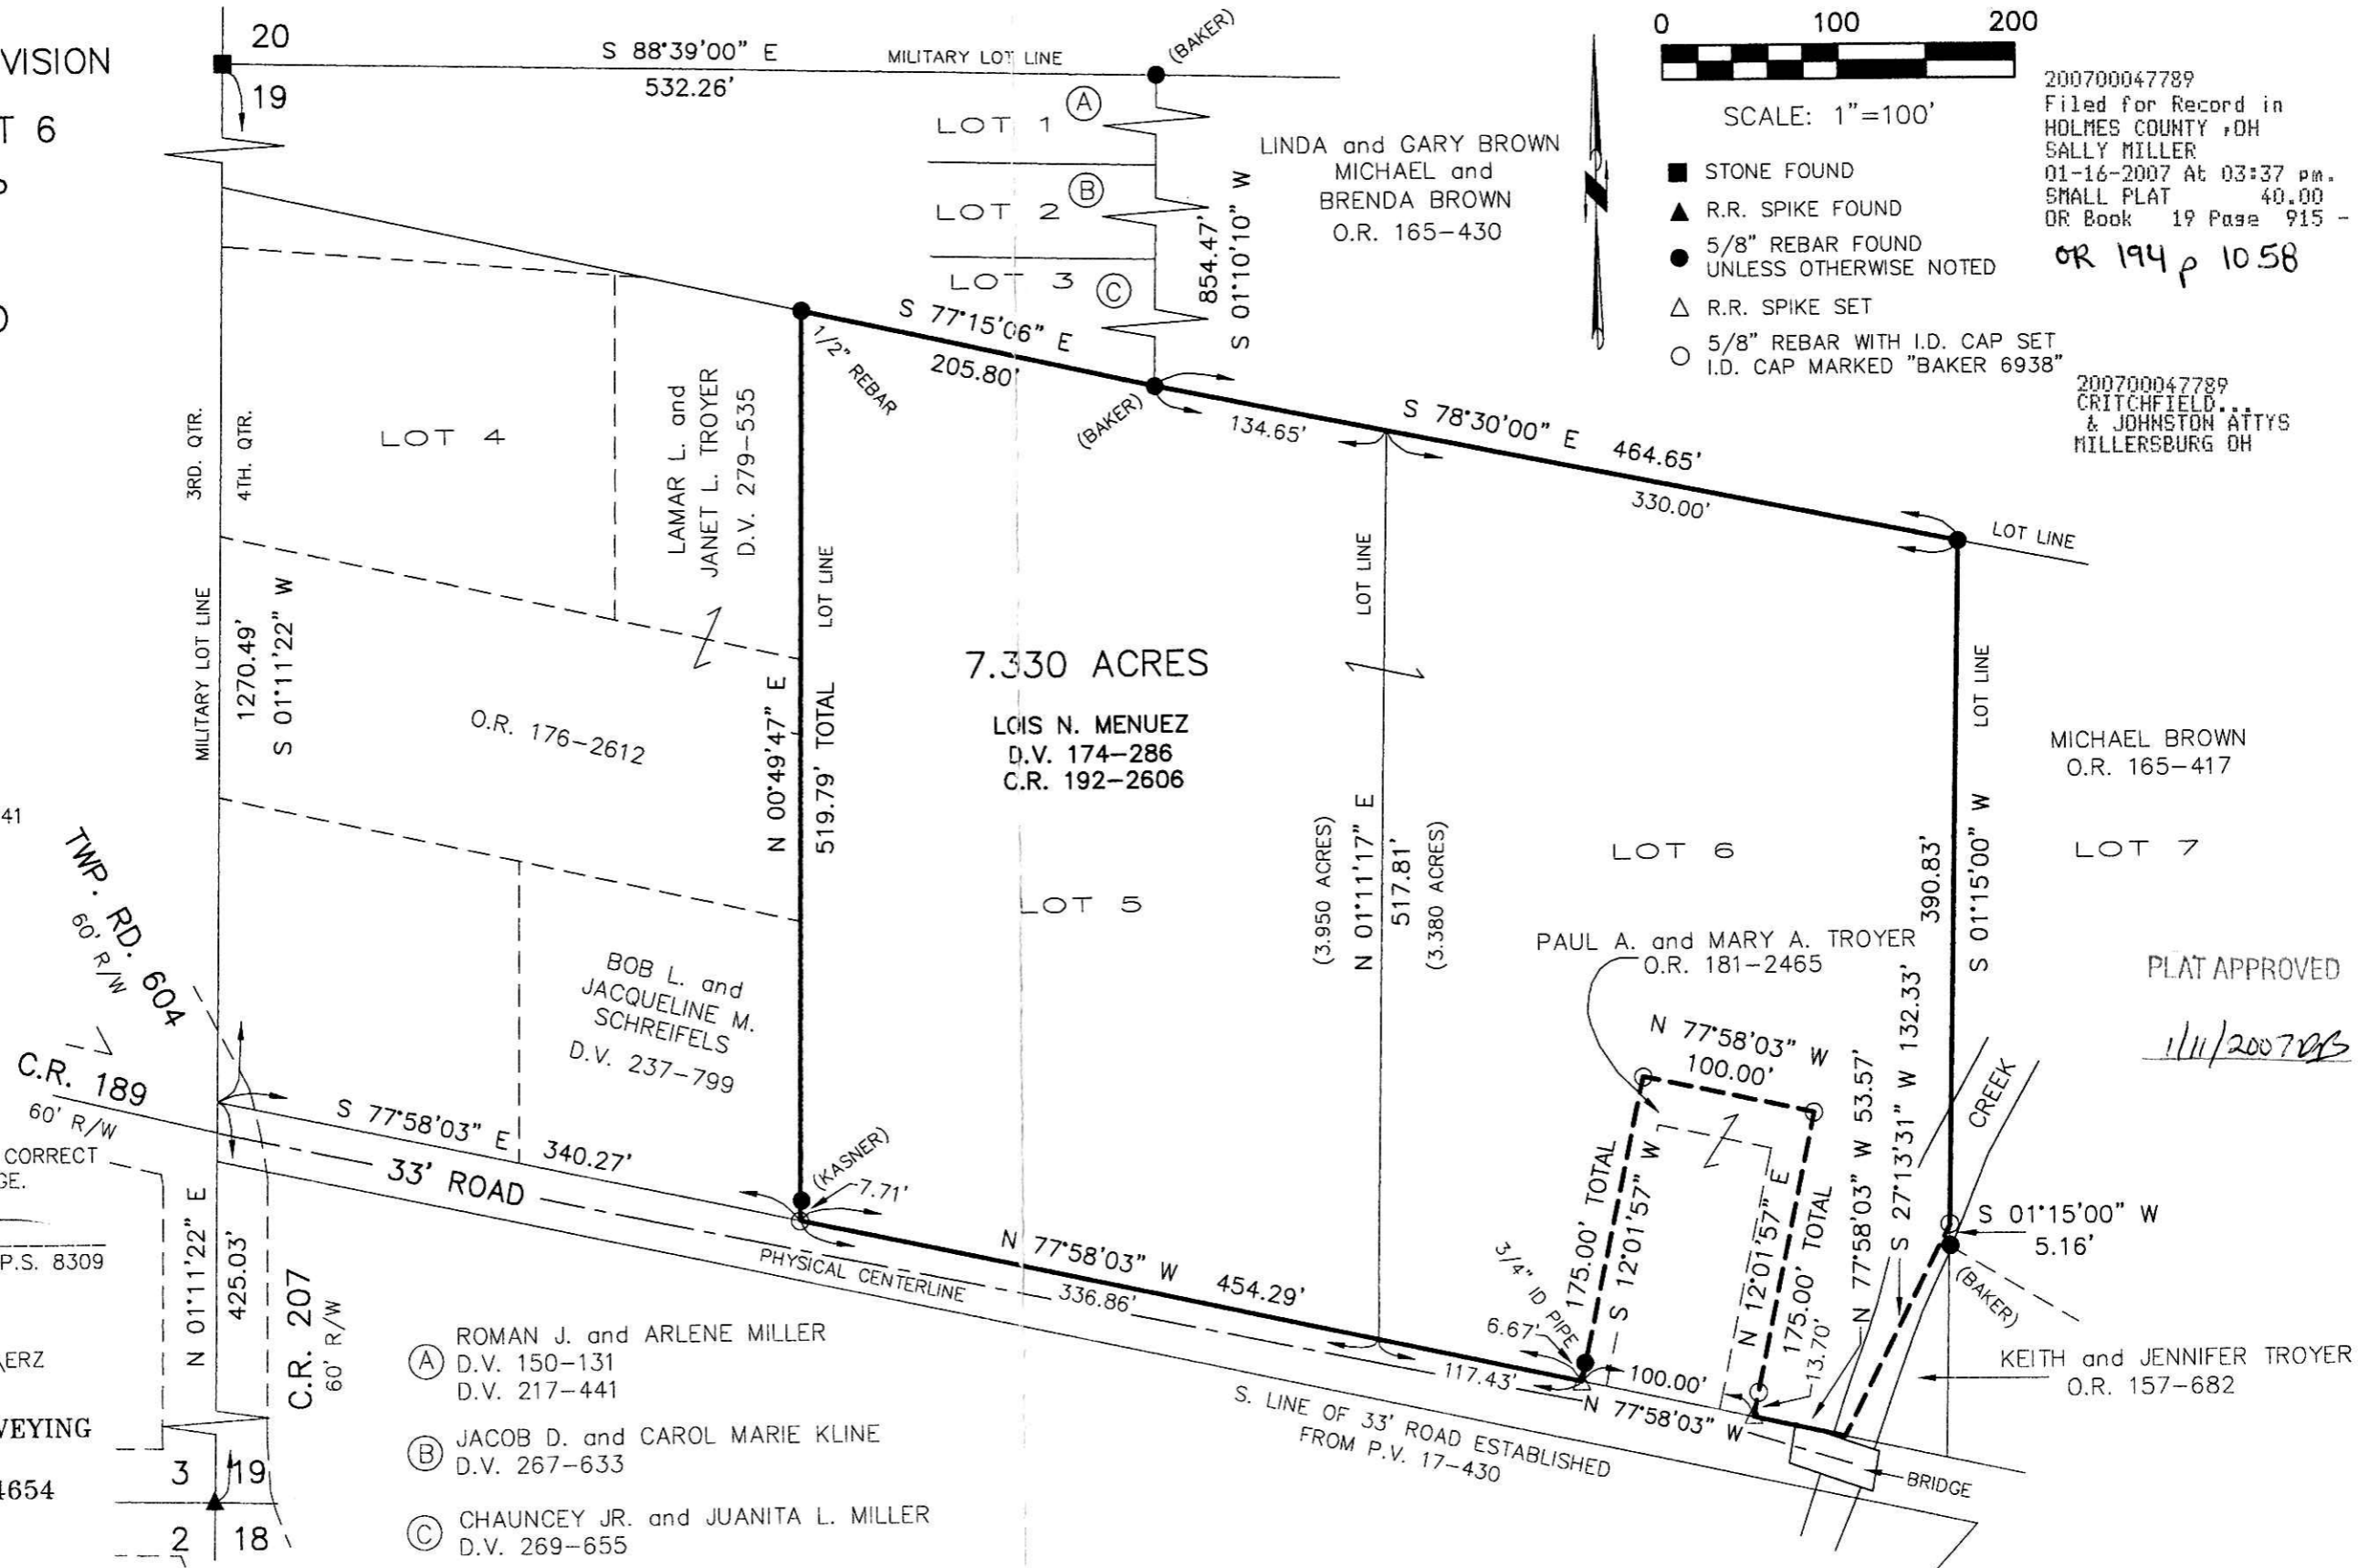

200700047789

Instrument 200700047789 OR Book Page 19 915