

RETRACEMENT SURVEY OF O.R. 187-2998  
SALT CREEK TOWNSHIP  
N.W. QTR. SECTION 29  
N.E. QTR. SECTION 30  
T-15 N; R-12 W  
HOLMES COUNTY, OHIO

200700047890  
WAYNE A  
ZACOUR ATTY  
WOOSTER OH

VOL 0019 PAGE 921



SURVEYED FOR: SUSAN A. MILLER

REFERENCES

- DEED VOL. 203 PAGES 125 & 128
- DEED VOL. 207 PAGE 677
- DEED VOL. 223 PAGE 844
- DEED VOL. 246 PAGE 403 & 406
- O.R. VOL. 135 PAGE 43
- O.R. VOL. 167 PAGE 1498
- O.R. VOL. 181 PAGE 3060
- O.R. VOL. 187 PAGE 2998

- PLAT VOL. 8 PAGE 26
- PLAT VOL. 18 PAGE 768
- BEARINGS FROM PLAT VOL. 8 PAGE 26

200700047890  
Filed for Record in  
HOLMES COUNTY OH  
SALLY MILLER  
01-22-2007 At 10:33 am.  
SMALL PLAT 40.00  
OR Book 19 Page 921 - 921  
CR 194 p 1387

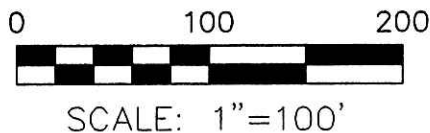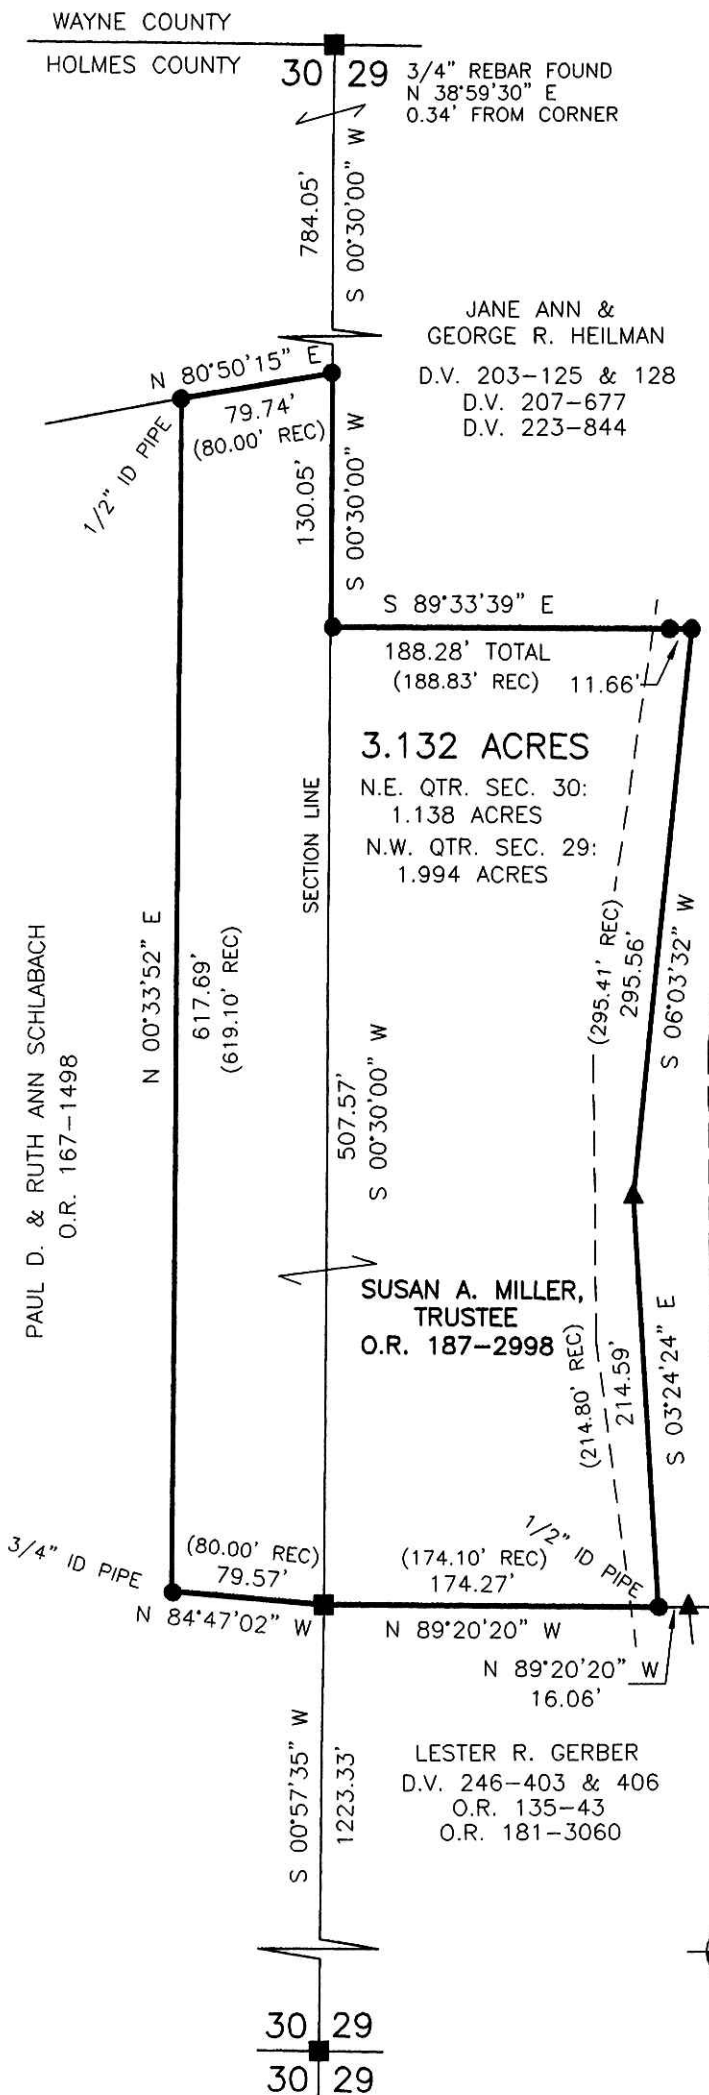

- STONE FOUND
- ▲ R.R. SPIKE FOUND
- 5/8" REBAR FOUND  
UNLESS OTHERWISE NOTED



I CERTIFY THIS SURVEY TO BE CORRECT  
TO THE BEST OF MY KNOWLEDGE.

JAMIE D. DARR P.S. 7755  
DATE: JAN. 2, 2007  
JDD/AEG  
FILE NAME: WORK3\S-904-06\ERZ

DONALD C. BAKER SURVEYING  
138 N. CLAY STREET  
MILLERSBURG, OHIO 44654  
PH. 330-674-4788  
FAX 330-674-6027

PLAT APPROVED

1/12/2007