VOL 0019 PAGE 925

Instrument 200700047964 OR | Book 19 | Page 925

RIPLEY TOWNSHIP
S.W. QTR. SECTION 16
T–17 N; R–14 W
HOLMES COUNTY, OHIO

SURVEYED FOR: DAVID SCHLAUCH

REFERENCES

DEED VOL. 219 PAGE 165
DEED VOL. 176 PAGE 25

O.R. VOL. 116 PAGE 694
O.R. VOL. 174 PAGE 2475

PLAT VOL. 6 PAGES 139 & 142
PLAT VOL. 8 PAGE 27
PLAT VOL. 14 PAGE 414
PLAT VOL. 19 PAGE 14

SURVEY RECORD 1 PAGES 71 & 85
SURVEY RECORD 3 PAGE 165
SURVEY RECORD 4 PAGES 83 & 100
SURVEY RECORD 5 PAGES 133 & 228
SURVEY RECORD 6 PAGE 38

121.238 AC. SURVEY BY WILLIAM H. LONG IN SECTION 17 DATED 4–17–1986

BEARINGS FROM PLAT VOL. 6 PAGE 142

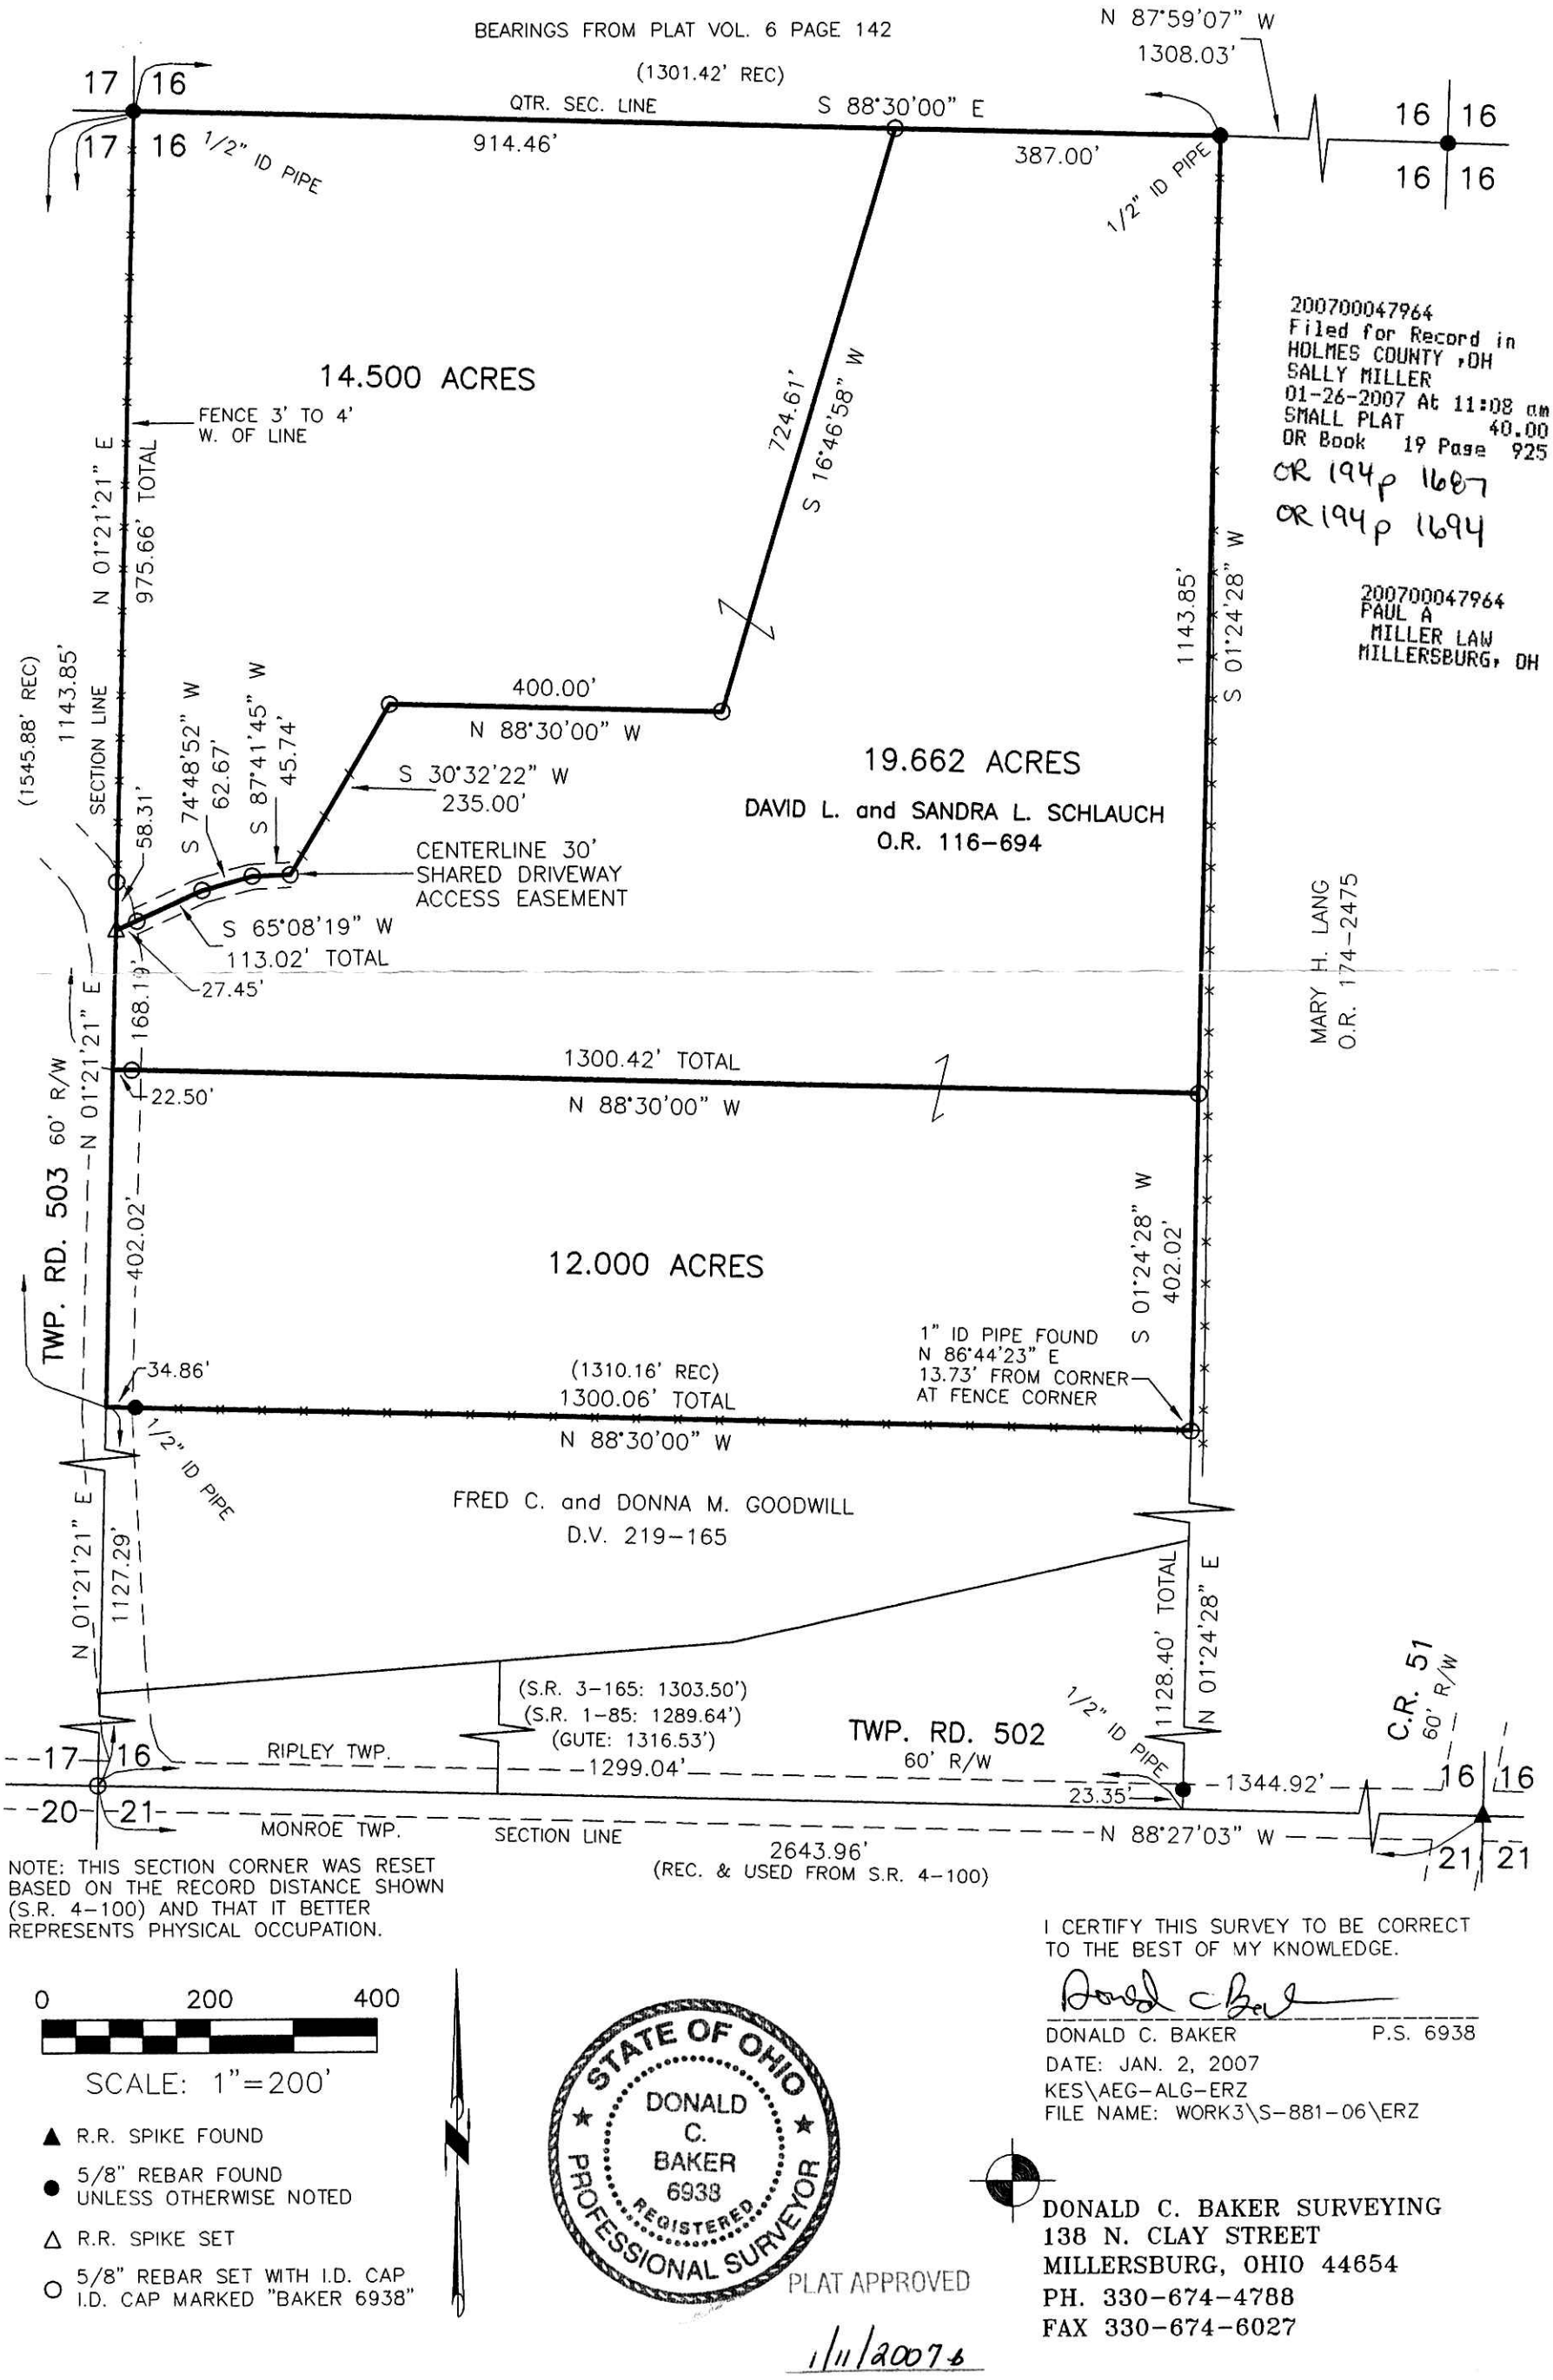

NOTE: THIS SECTION CORNER WAS RESET BASED ON THE RECORD DISTANCE SHOWN (S.R. 4–100) AND THAT IT BETTER REPRESENTS PHYSICAL OCCUPATION.

0 200 400

SCALE: 1"=200'

- ▲ R.R. SPIKE FOUND
- ● 5/8" REBAR FOUND UNLESS OTHERWISE NOTED
- △ R.R. SPIKE SET
- ○ 5/8" REBAR SET WITH I.D. CAP I.D. CAP MARKED "BAKER 6938"

STATE OF OHIO
DONALD C. BAKER 6938
REGISTERED PROFESSIONAL SURVEYOR

PLAT APPROVED

1/11/2007

I CERTIFY THIS SURVEY TO BE CORRECT TO THE BEST OF MY KNOWLEDGE.

DONALD C. BAKER P.S. 6938

DATE: JAN. 2, 2007

KES\AEG–ALG–ERZ

FILE NAME: WORK3\S–881–06\ERZ

DONALD C. BAKER SURVEYING
138 N. CLAY STREET
MILLERSBURG, OHIO 44654
PH. 330–674–4788
FAX 330–674–6027