


200700049922
PEAK
TITLE
LEWIS CENTER OH

200700049922
Filed for Record in
HOLMES COUNTY, OH
SALLY MILLER
05-11-2007 At 01:53 pm.
SMALL PLAT 40.00
OR Book 19 Page 1020 - 1020

VILLAGE OF MILLERSBURG
PART OF LOTS 253 & 254
PART OF OUTLOT 49
PART OF VACATED ALLEY
HARDY TWP., SECTION 12
T-9N; R-7W
HOLMES COUNTY, OHIO

OR 196 p 3141


SURVEYED FOR: RONNIE HADDOCK

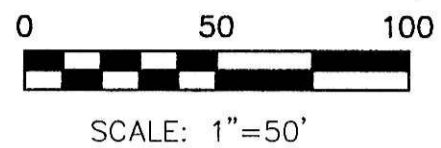

- 5/8" REBAR FOUND UNLESS OTHERWISE NOTED
- 5/8" REBAR WITH I.D. CAP SET I.D. CAP MARKED "BAKER 6938"

REFERENCES

DEED VOL. 278 PAGE 100
O.R. VOL. 50 PAGE 194
PLAT VOL. 16 PAGE 1
BEARINGS FROM PLAT VOL 16 PAGE 1

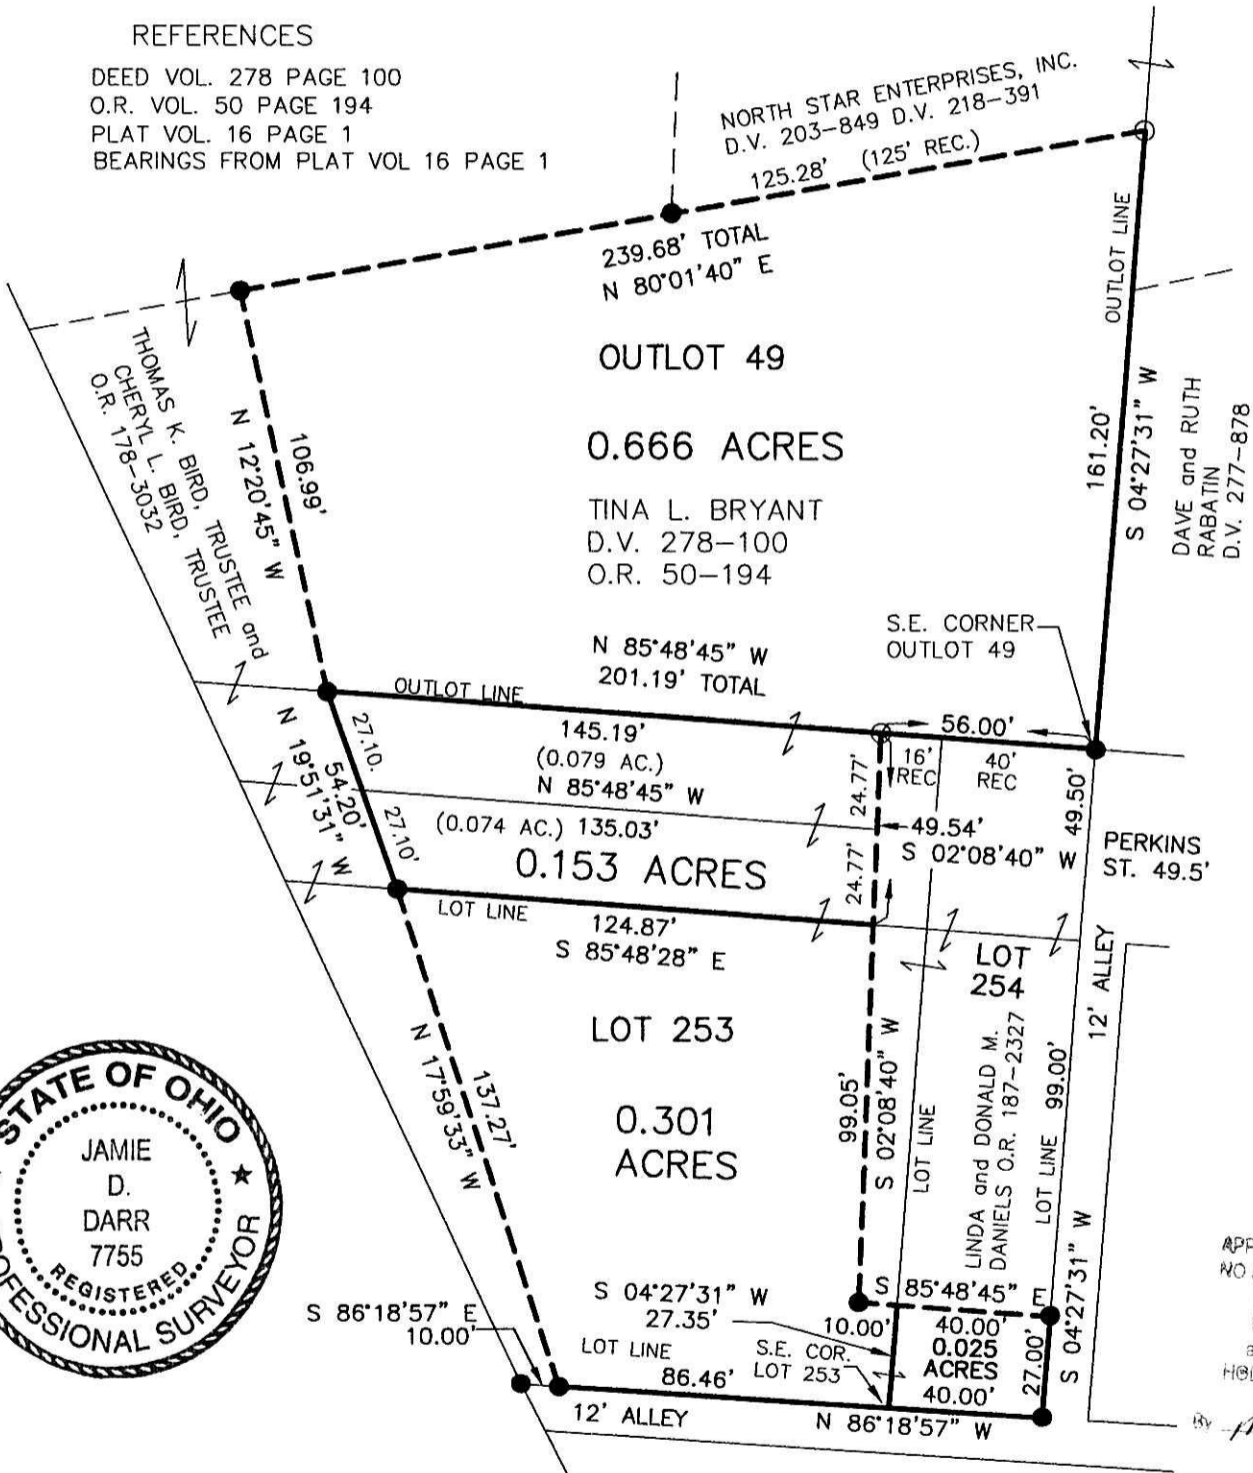

I CERTIFY THIS SURVEY TO BE CORRECT TO THE BEST OF MY KNOWLEDGE.

Jamie D. Darr
JAMIE D. DARR P.S. 7755
DATE: APRIL 12, 2007

JDD\ALG
File Name: WORK2\S-208-07\MLD



DONALD C. BAKER SURVEYING
138 N. CLAY ST.
MILLERSBURG, OHIO, 44654
PH. 330-674-4788
FAX. 330-674-6027

APPROVED FOR TRANSFER ONLY
NO SUBDIVISION PLAT REQUIRED
(O.R.C. 711.001 & 711.131)
Lot(s) not for building unless
approved by Board of Health
HOLMES CO PLANNING COMM.
By *MH* Date *5-9-07*

PLAT APPROVED

5/3/2007