

200700050605  
MILLER RAST  
& MASON ATTYS  
MILLERSBURG OH

200700050605  
Filed for Record in  
HOLMES COUNTY, OH  
SALLY MILLER  
06-14-2007 At 10:16 am.  
SMALL PLAT 40.00  
OR Book 19 Page 1051 - 1051

OR 197p2487


VILLAGE OF BERLIN  
PART OF OUT LOT 4

BERLIN TOWNSHIP  
N.W. QTR. SECTION 15  
T-9 N, R- 5 W  
HOLMES COUNTY, OHIO

SITE PLAN  
HARMONY MANOR CONDOMINIUMS

- REFERENCES
- DEED VOL. 221 PAGE 81
  - DEED VOL. 181 PAGE 249
  - O.R. VOL. 72 PAGE 123
  - O.R. VOL. 177 PAGE 917
  - O.R. VOL. 39 PAGE 218
  - O.R. VOL. 28 PAGE 501
  - PLAT VOL. 2 PAGE 74
  - PLAT VOL. 3 PAGE 66B
  - PLAT VOL. 2 PAGE 44A
  - PLAT VOL. 4 PAGE 142
  - PLAT VOL. 2 PAGE 56
  - BEARINGS FROM PLAT VOL. 2 PAGE 74

SURVEYED FOR:  
HOLMES COUNTY INVESTMENTS, LTD.

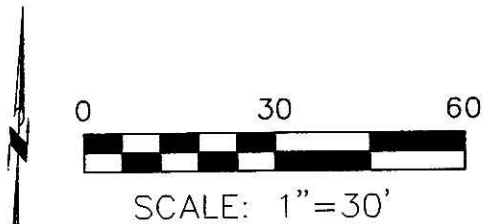


- 5/8" REBAR SET WITH I.D. CAP  
I.D. CAP MARKED "BAKER 6938"
- 1/2" ID PIPE FOUND  
UNLESS OTHERWISE NOTED




I CERTIFY THAT THE BUILDINGS ARE LOCATED  
ON THE TRACT OF LAND AS INDICATED AND  
THE BUILDINGS ARE CONSTRUCTED AS  
SHOWN ON THIS PLAT

JAMIE D. DARR P.S. 7755  
DATE: MAY 11, 2007  
JDD/AEG  
FILE NAME: WORK3\S-23-07

C.R. 120  
MARKET ST. 66'

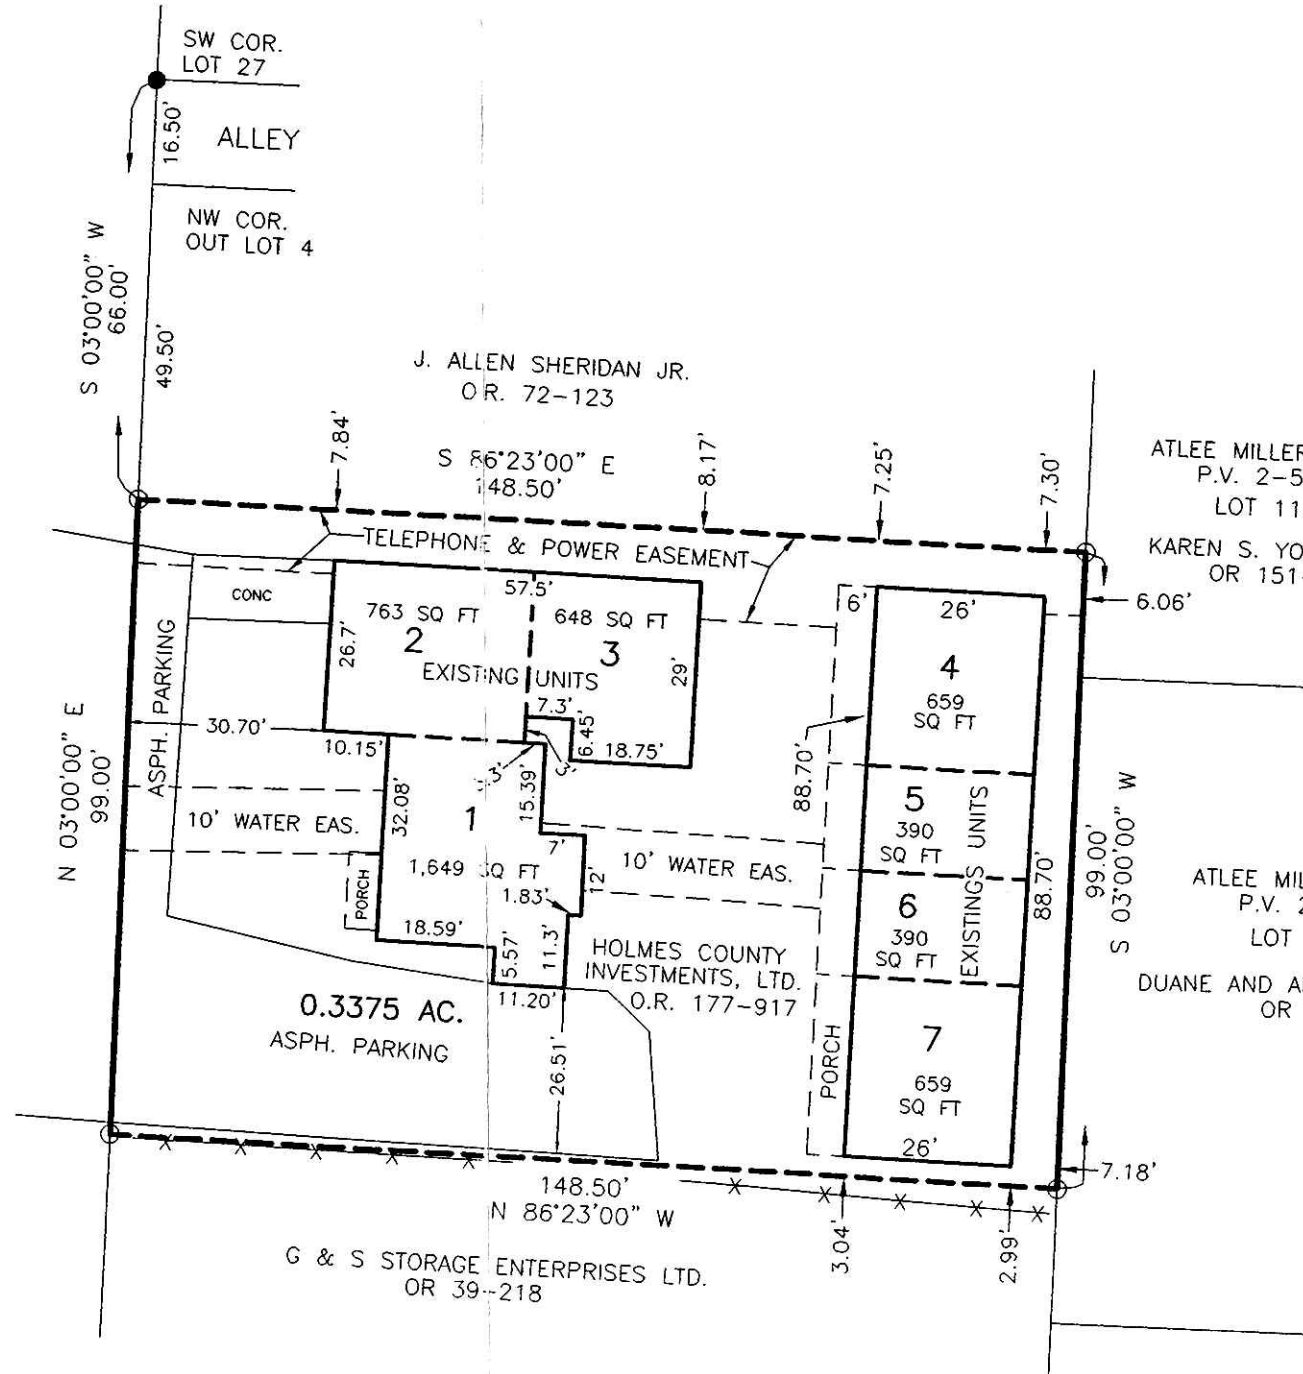

UNIT 1  
FIRST FLOOR: 812 FT. SQ.  
BASEMENT & STAIRWELL:  
837 FT. SQ.

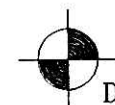

DONALD C. BAKER SURVEYING  
138 N. CLAY STREET  
MILLERSBURG, OHIO 44654  
PH. 330-674-4788  
FAX 330-674-6027

PLAT APPROVED

6/18/07 Ag

Instrument Book Page  
200700050605 OR 19 1051