

BERLIN TOWNSHIP
 4TH. QTR., LOTS 13 & 14
 T-9 N; R-6 W
 HOLMES COUNTY, OHIO

SURVEYED FOR: DAVE KAUFMAN REALTY

200700050821
 Filed for Record in
 HOLMES COUNTY, OH
 SALLY MILLER
 06-26-2007 At 12:33 pm.
 SMALL PLAT 40.00
 OR Book 19 Page 1063 - 1063
 ORV 197 pg 3435

Instrument Book Page
 200700050821 OR 19 1063



REFERENCES

DEED VOL. 226 PAGE 513
 DEED VOL. 266 PAGE 445
 PLAT VOL. 10 PAGE 707
 PLAT VOL. 12 PAGE 709
 BEARINGS FROM PLAT VOL. 12 PAGE 709

LYNN and FREDA E. HOCHSTETLER
 D.V. 226-513

HOMER J. and DOROTHY M. KANDEL, TRUSTEES
 D.V. 266-445

1.776 ACRES
 LOT 13: 0.976 ACRES
 LOT 14: 0.800 ACRES

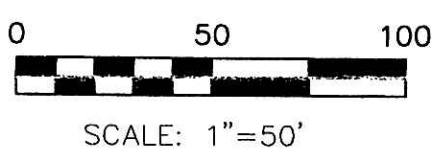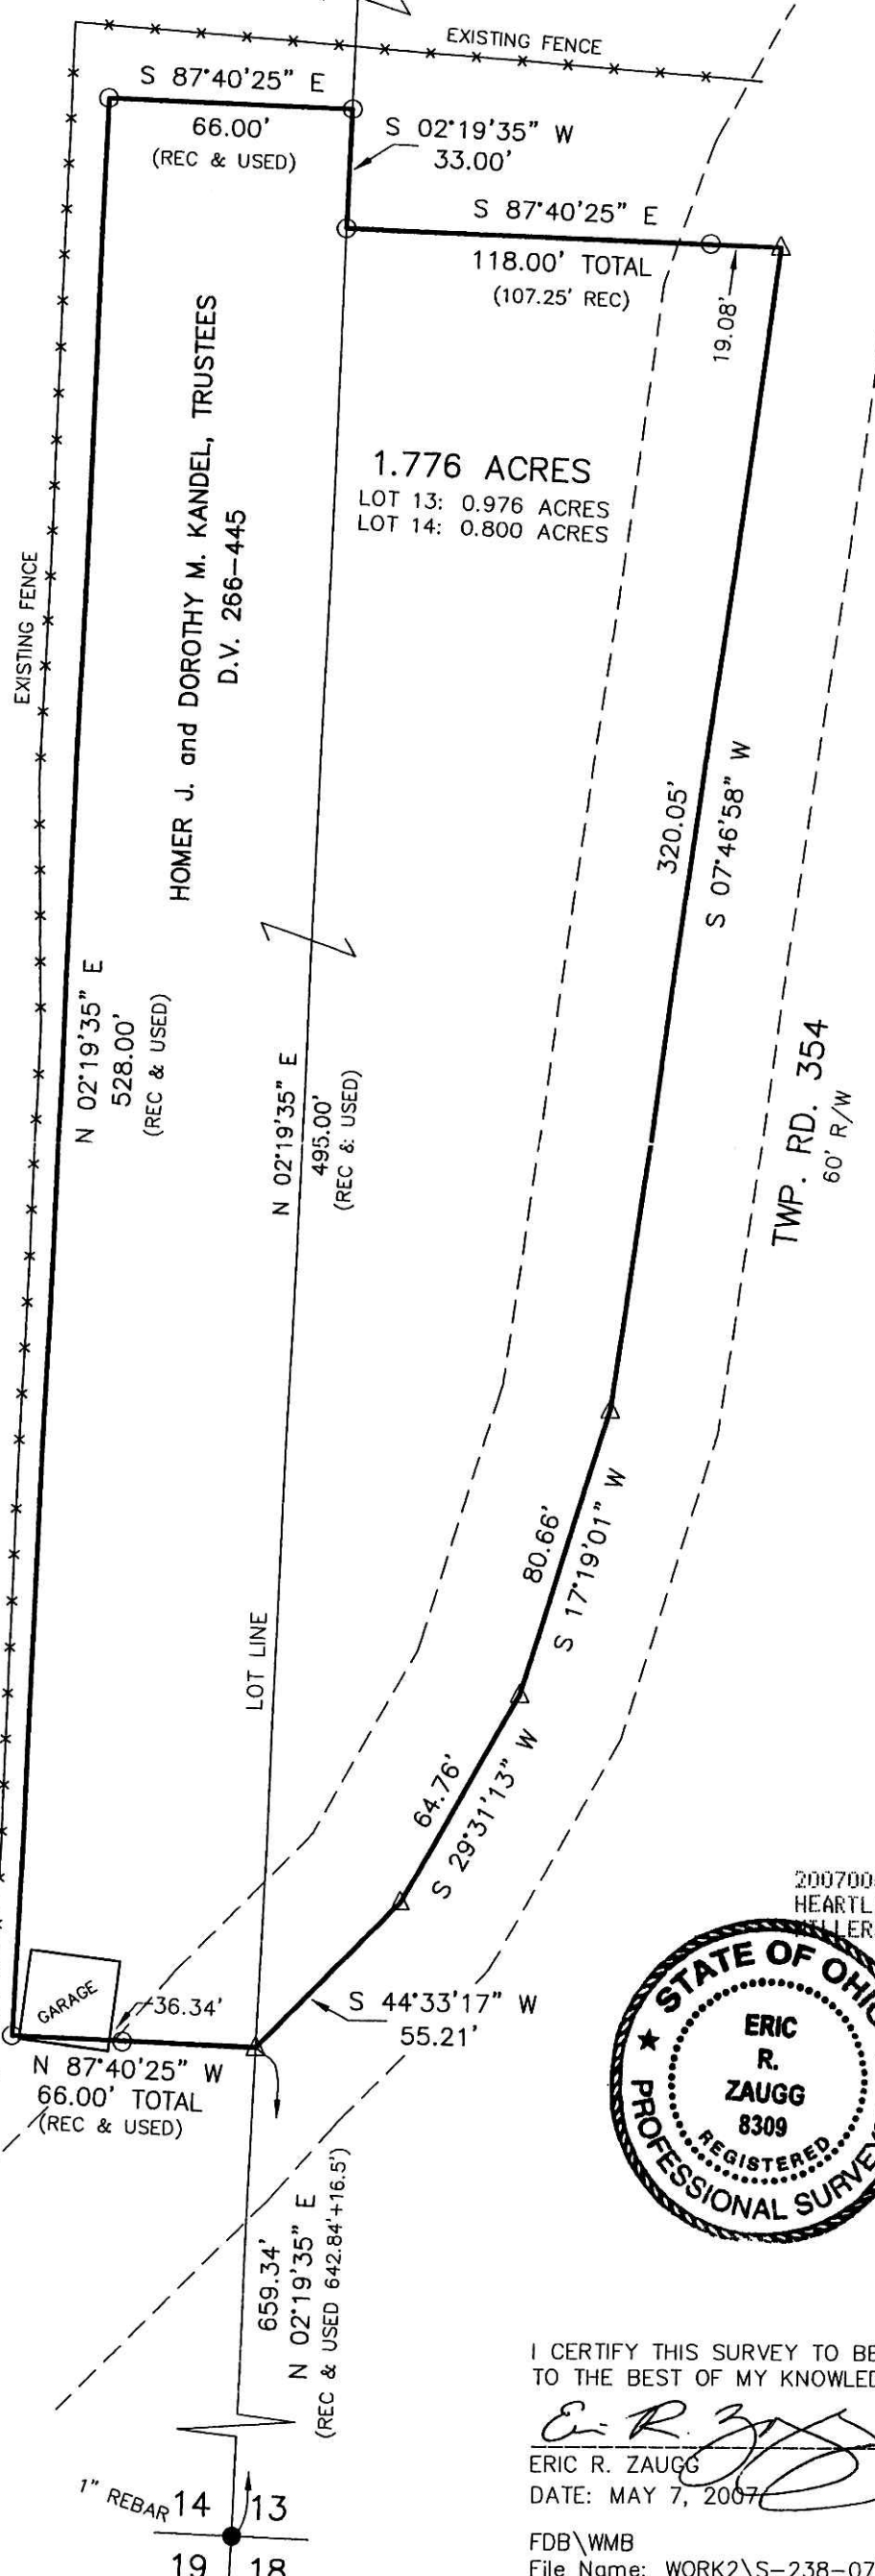

- 5/8" REBAR FOUND UNLESS OTHERWISE NOTED
- △ R.R. SPIKE SET
- 5/8" REBAR WITH I.D. CAP SET I.D. CAP MARKED "BAKER 6938"



I CERTIFY THIS SURVEY TO BE CORRECT TO THE BEST OF MY KNOWLEDGE.

Eric R. Zaugg
 ERIC R. ZAUGG P.S. 8309
 DATE: MAY 7, 2007

FDB\WMB
 File Name: WORK2\S-238-07\ERZ

PLAT APPROVED

6/13/2007

DONALD C. BAKER SURVEYING
 138 N. CLAY ST.
 MILLERSBURG, OHIO, 44654
 PH. 330-674-4788
 FAX. 330-674-6027