


HARDY TOWNSHIP
3RD. QTR. LOT 12
TWP-9N RANGE-7W
HOLMES COUNTY, OHIO

RESURVEY OF 1 ACRE PARCEL
AS DESCRIBED BY DEED
VOL. 238 PAGE 531 & O.R.
VOL. 194 PAGE 1268

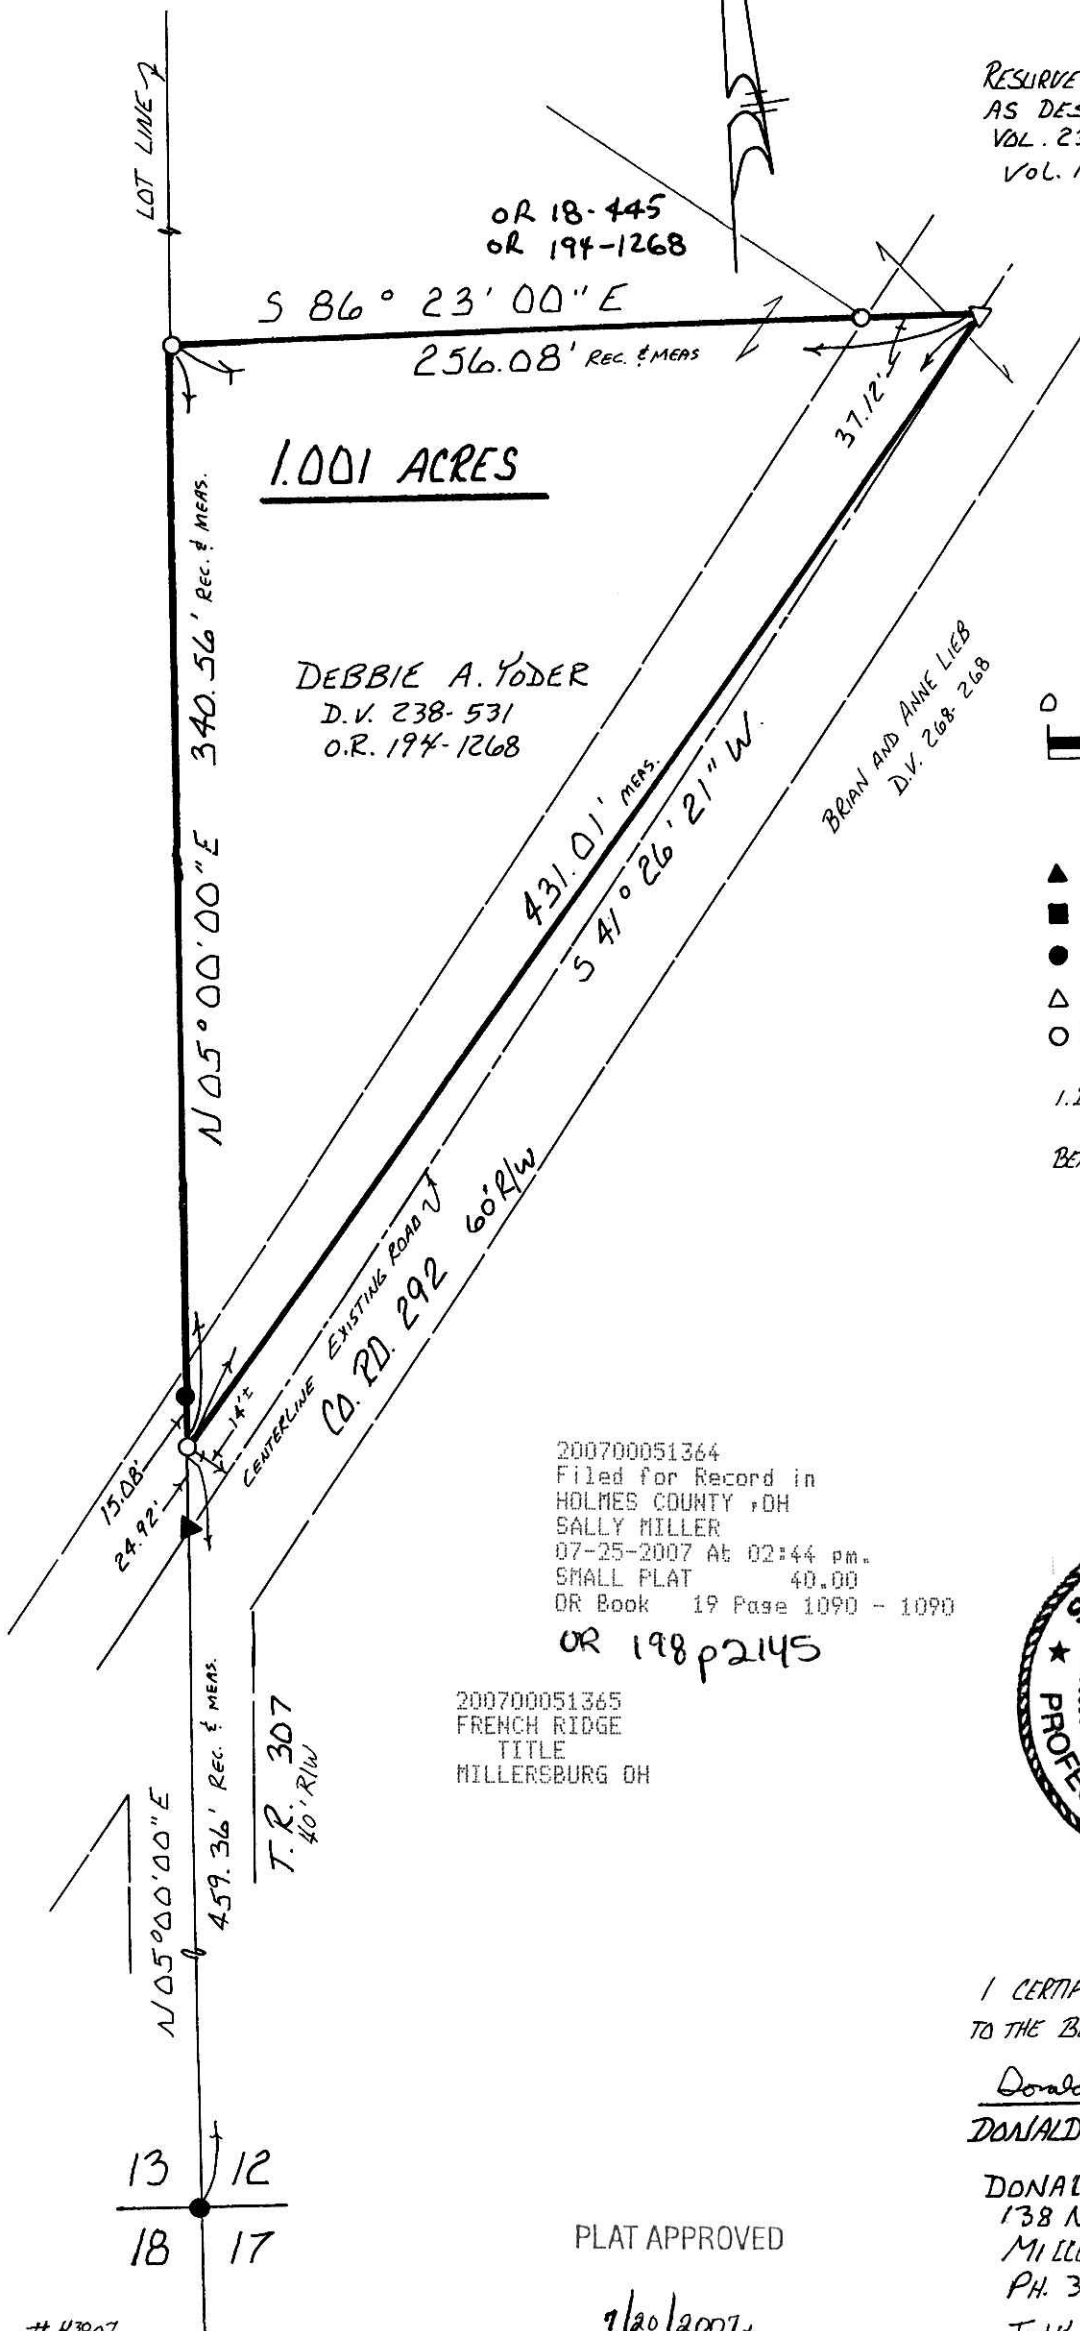

1.001 ACRES


DEBBIE A. YODER
D.V. 238-531
O.R. 194-1268

BRAN AND ANNE LIEB
D.V. 268-268

200700051364
Filed for Record in
HOLMES COUNTY, OH
SALLY MILLER
07-25-2007 At 02:44 pm.
SMALL PLAT 40.00
OR Book 19 Page 1090 - 1090

OR 198 p 2145

200700051365
FRENCH RIDGE
TITLE
MILLERSBURG OH

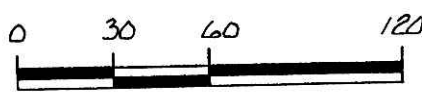

SCALE: 1" = 60'

- ▲ R.R. SPIKE FOUND
 - STONE FOUND
 - IRON PIN FOUND
 - △ R.R. SPIKE SET
 - 5/8" REBAR WITH I.D. CAP SET
- I.D. CAP MARKED "BAKER 6938"

BEARINGS ASSUMED

REFERENCES:
PLAT VOL. 7 PAGE 545
DEED VOL. 238 PAGE 531



I CERTIFY THIS SURVEY TO BE CORRECT
TO THE BEST OF MY KNOWLEDGE.

Donald C. Baker
DONALD C. BAKER P.S. 6938

DONALD C. BAKER SURVEYING
138 N. CLAY ST.
MILLERSBURG OH 44654
PH. 330-674-4788

JULY 6, 2007 (REVISED FROM NOV. 13, 1989)

PLAT APPROVED

7/6/2007