

RETRACEMENT SURVEY OF O.R. 176-2802  
 HARDY TOWNSHIP  
 3RD. QTR., LOTS 1 & 2  
 T-9 N; R-7 W  
 HOLMES COUNTY, OHIO

SURVEYED FOR: THOMAS & JOSEF SKEMP

Instrument Book Page  
 200700051729 OR 19 1104

200700051729  
 Filed for Record in  
 HOLMES COUNTY, OH  
 SALLY MILLER  
 08-17-2007 At 11:13 am.  
 SMALL PLAT 40.00  
 OR Book 19 Page 1104 - 1104

OR 199 p 227


200700051729  
 FRENCH RIDGE  
 TITLE  
 MILLERSBURG OH

REFERENCES

- DEED VOL. 267 PAGE 460
- O.R. VOL. 38 PAGE 549
- O.R. VOL. 176 PAGE 2802
- PLAT VOL. 3 PAGE 37
- PLAT VOL. 6 PAGE 144
- PLAT VOL. 17 PAGE 763
- BEARINGS FROM PLAT VOL. 17 PAGE 763

0.865 ACRES  
 LOT 1: 0.593 ACRES  
 LOT 2: 0.272 ACRES

BEVERLY GIANNONE  
 O.R. 38-549

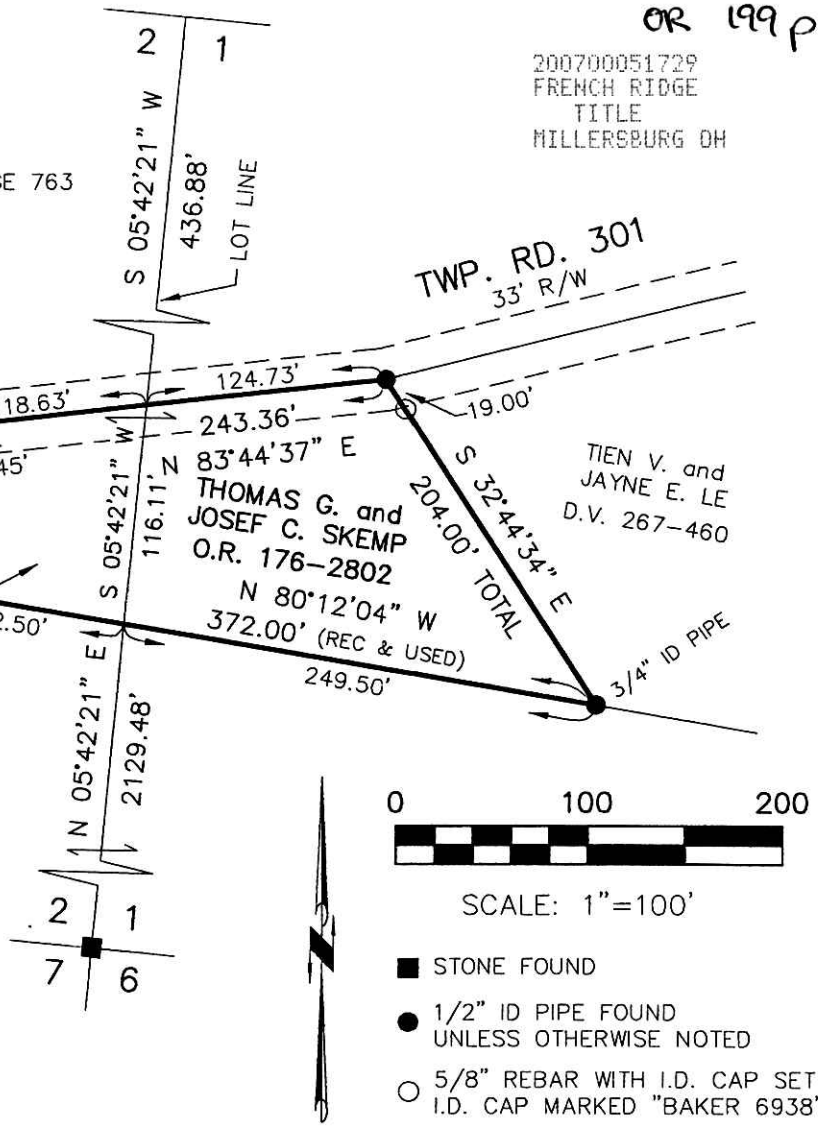

I CERTIFY THIS SURVEY TO BE CORRECT  
 TO THE BEST OF MY KNOWLEDGE.


*Donald C. Baker*

DONALD C. BAKER P.S. 6938

DATE: AUG. 1, 2007

KES\DB

File Name: WORK2\S-466-07\ERZ

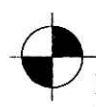

DONALD C. BAKER SURVEYING  
 138 N. CLAY ST.  
 MILLERSBURG, OHIO, 44654  
 PH. 330-674-4788  
 FAX. 330-674-6027

PLAT APPROVED

8/15/2007