


200700051830  
 Filed for Record in  
 HOLMES COUNTY, OH  
 SALLY MILLER  
 08-22-2007 At 08:48 am.  
 SMALL PLAT 40.00  
 OR Book 19 Page 1114 - 1114  
 OR 199 p 580


CLARK TOWNSHIP  
 N.W. QTR. SECTION 5  
 T-8 N; R-5 W  
 HOLMES COUNTY, OHIO

SURVEYED FOR: BEN MILLER

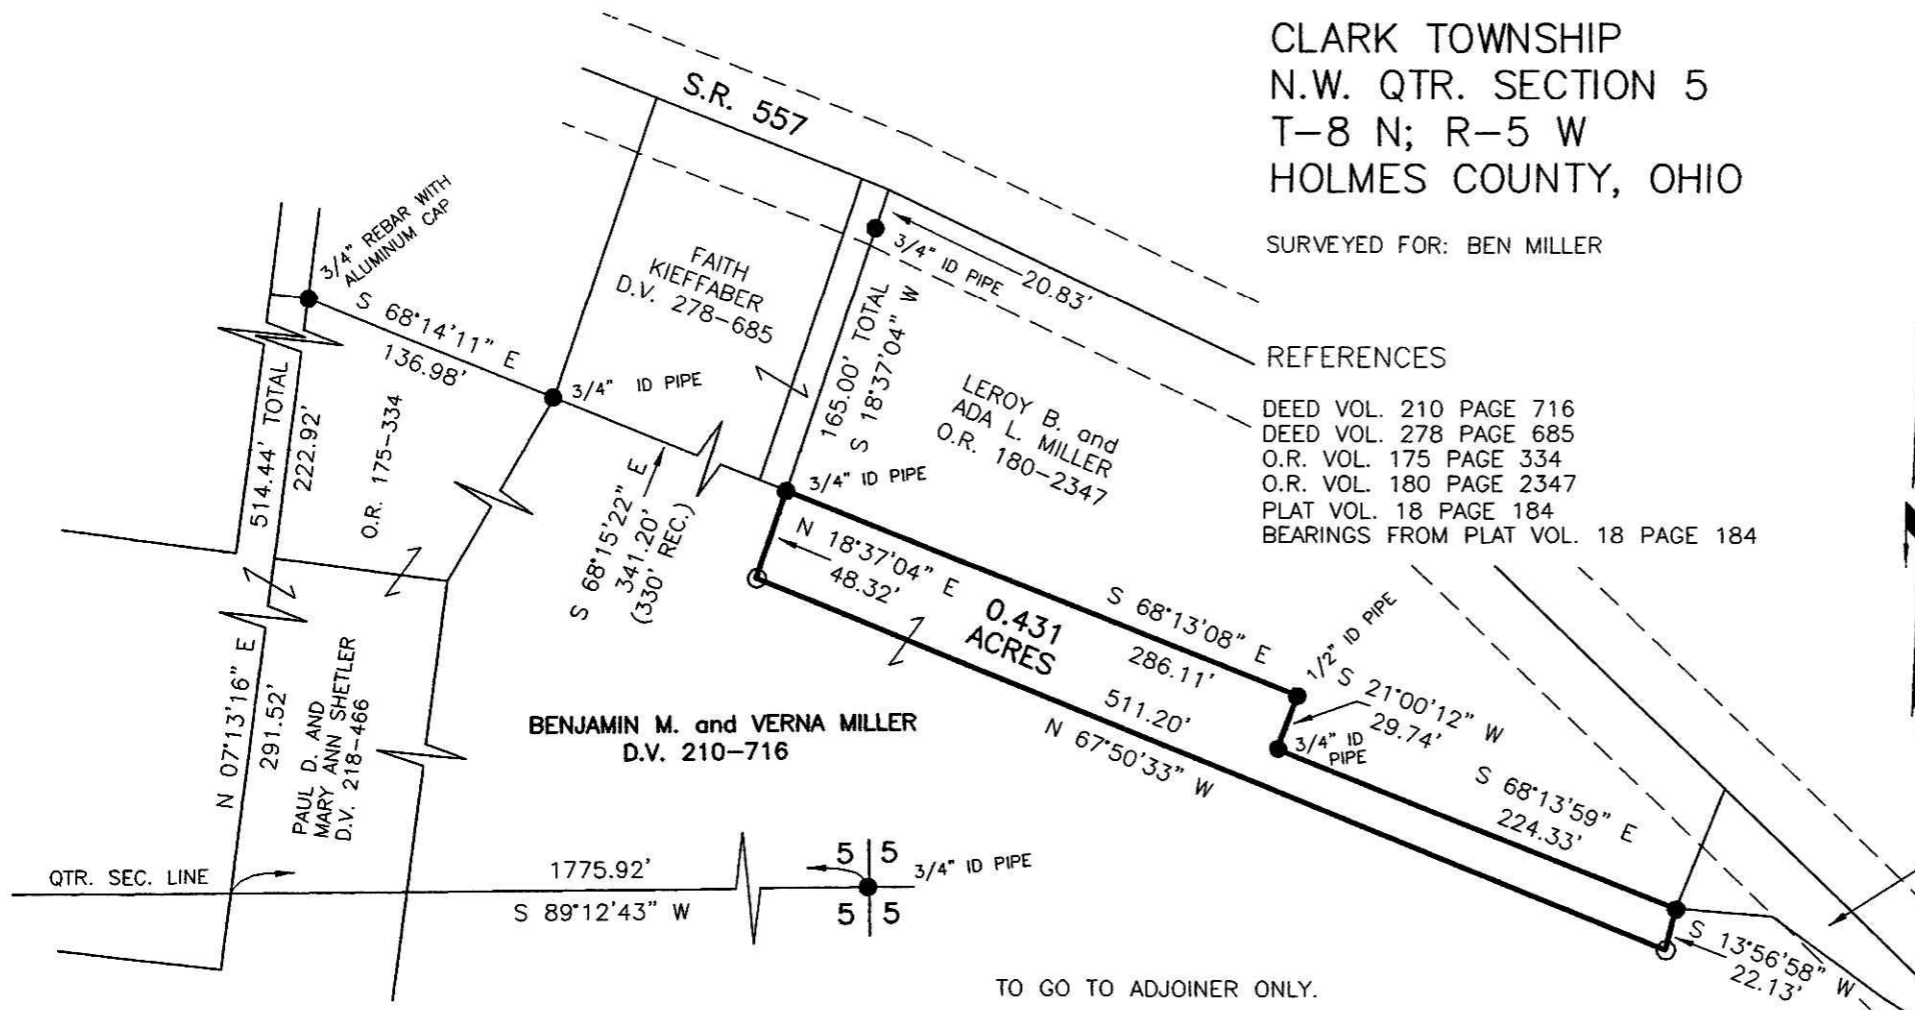

REFERENCES

DEED VOL. 210 PAGE 716  
 DEED VOL. 278 PAGE 685  
 O.R. VOL. 175 PAGE 334  
 O.R. VOL. 180 PAGE 2347  
 PLAT VOL. 18 PAGE 184  
 BEARINGS FROM PLAT VOL. 18 PAGE 184

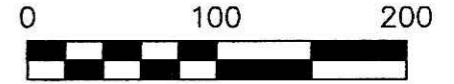

SCALE: 1"=100'

- 5/8" REBAR FOUND  
UNLESS OTHERWISE NOTED
- 5/8" REBAR SET WITH I.D. CAP  
I.D. CAP MARKED "BAKER 6938"

I CERTIFY THIS SURVEY TO BE CORRECT  
 TO THE BEST OF MY KNOWLEDGE.

*[Signature]*  
 JAMIE D. DARR P.S. 7755

DATE: FEB. 20, 2007  
 UDD\AEG  
 FILE NAME: WORK3\S-68-07\ERZ



TO GO TO ADJOINER ONLY.

200700051830  
 MILLER MAST  
 & MASON ATTYS  
 MILLERSBURG OH

DONALD C. BAKER SURVEYING  
 138 N. CLAY STREET  
 MILLERSBURG, OHIO 44654  
 PH. 330-674-4788  
 FAX 330-674-6027

PLAT APPROVED

*6/20/2007*

Instrument 200700051830 OR Book Page 19 1114