


RETRACEMENT SURVEY OF D.V. 169-114  
 PAINT TOWNSHIP  
 N.E. & N.W. QTRS. SECTION 5  
 T-14 N; R-11 W  
 HOLMES COUNTY, OHIO

SURVEYED FOR: IVAN MILLER

REFERENCES

- DEED VOL. 229 PAGE 764
  - DEED VOL. 230 PAGE 277
  - DEED VOL. 265 PAGE 256
  - O.R. VOL. 134 PAGE 94
  - PLAT VOL. 10 PAGE 285
  - PLAT VOL. 12 PAGE 462
  - PLAT VOL. 14 PAGE 981
  - PLAT VOL. 18 PAGE 91
- BEARINGS FROM PLAT VOL. 18 PAGE 91

200700053314  
 Filed for Record in  
 HOLMES COUNTY, OH  
 SALLY MILLER  
 11-14-2007 At 03:44 pm.  
 SMALL PLAT 40.00  
 OR Book 19 Page 1187 - 1187  
 OR 200 p 3389

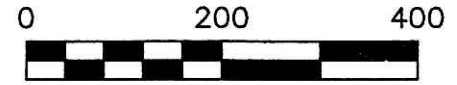



SCALE: 1"=200'

- ▲ R.R. SPIKE FOUND
- 5/8" REBAR FOUND UNLESS OTHERWISE NOTED
- 5/8" REBAR WITH I.D. CAP SET I.D. CAP MARKED "BAKER 6938"

200700053314  
 SAMUEL M  
 STEIMEL ATTY  
 MILLERSBURG OH

JOHN M. and TENA MILLER  
 D.V. 158-163  
 D.V. 230-277

Instrument Book Page  
 200700053314 OR 19 1187

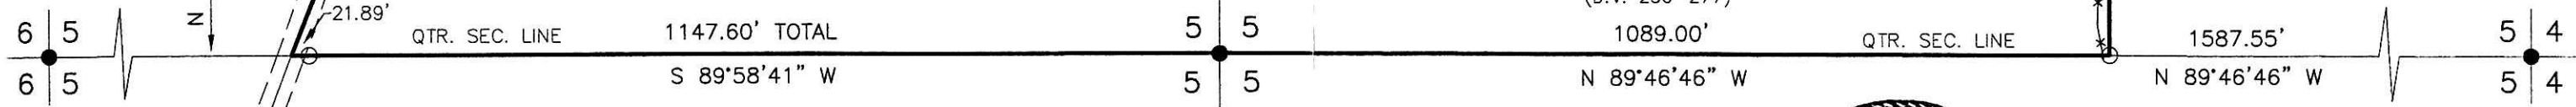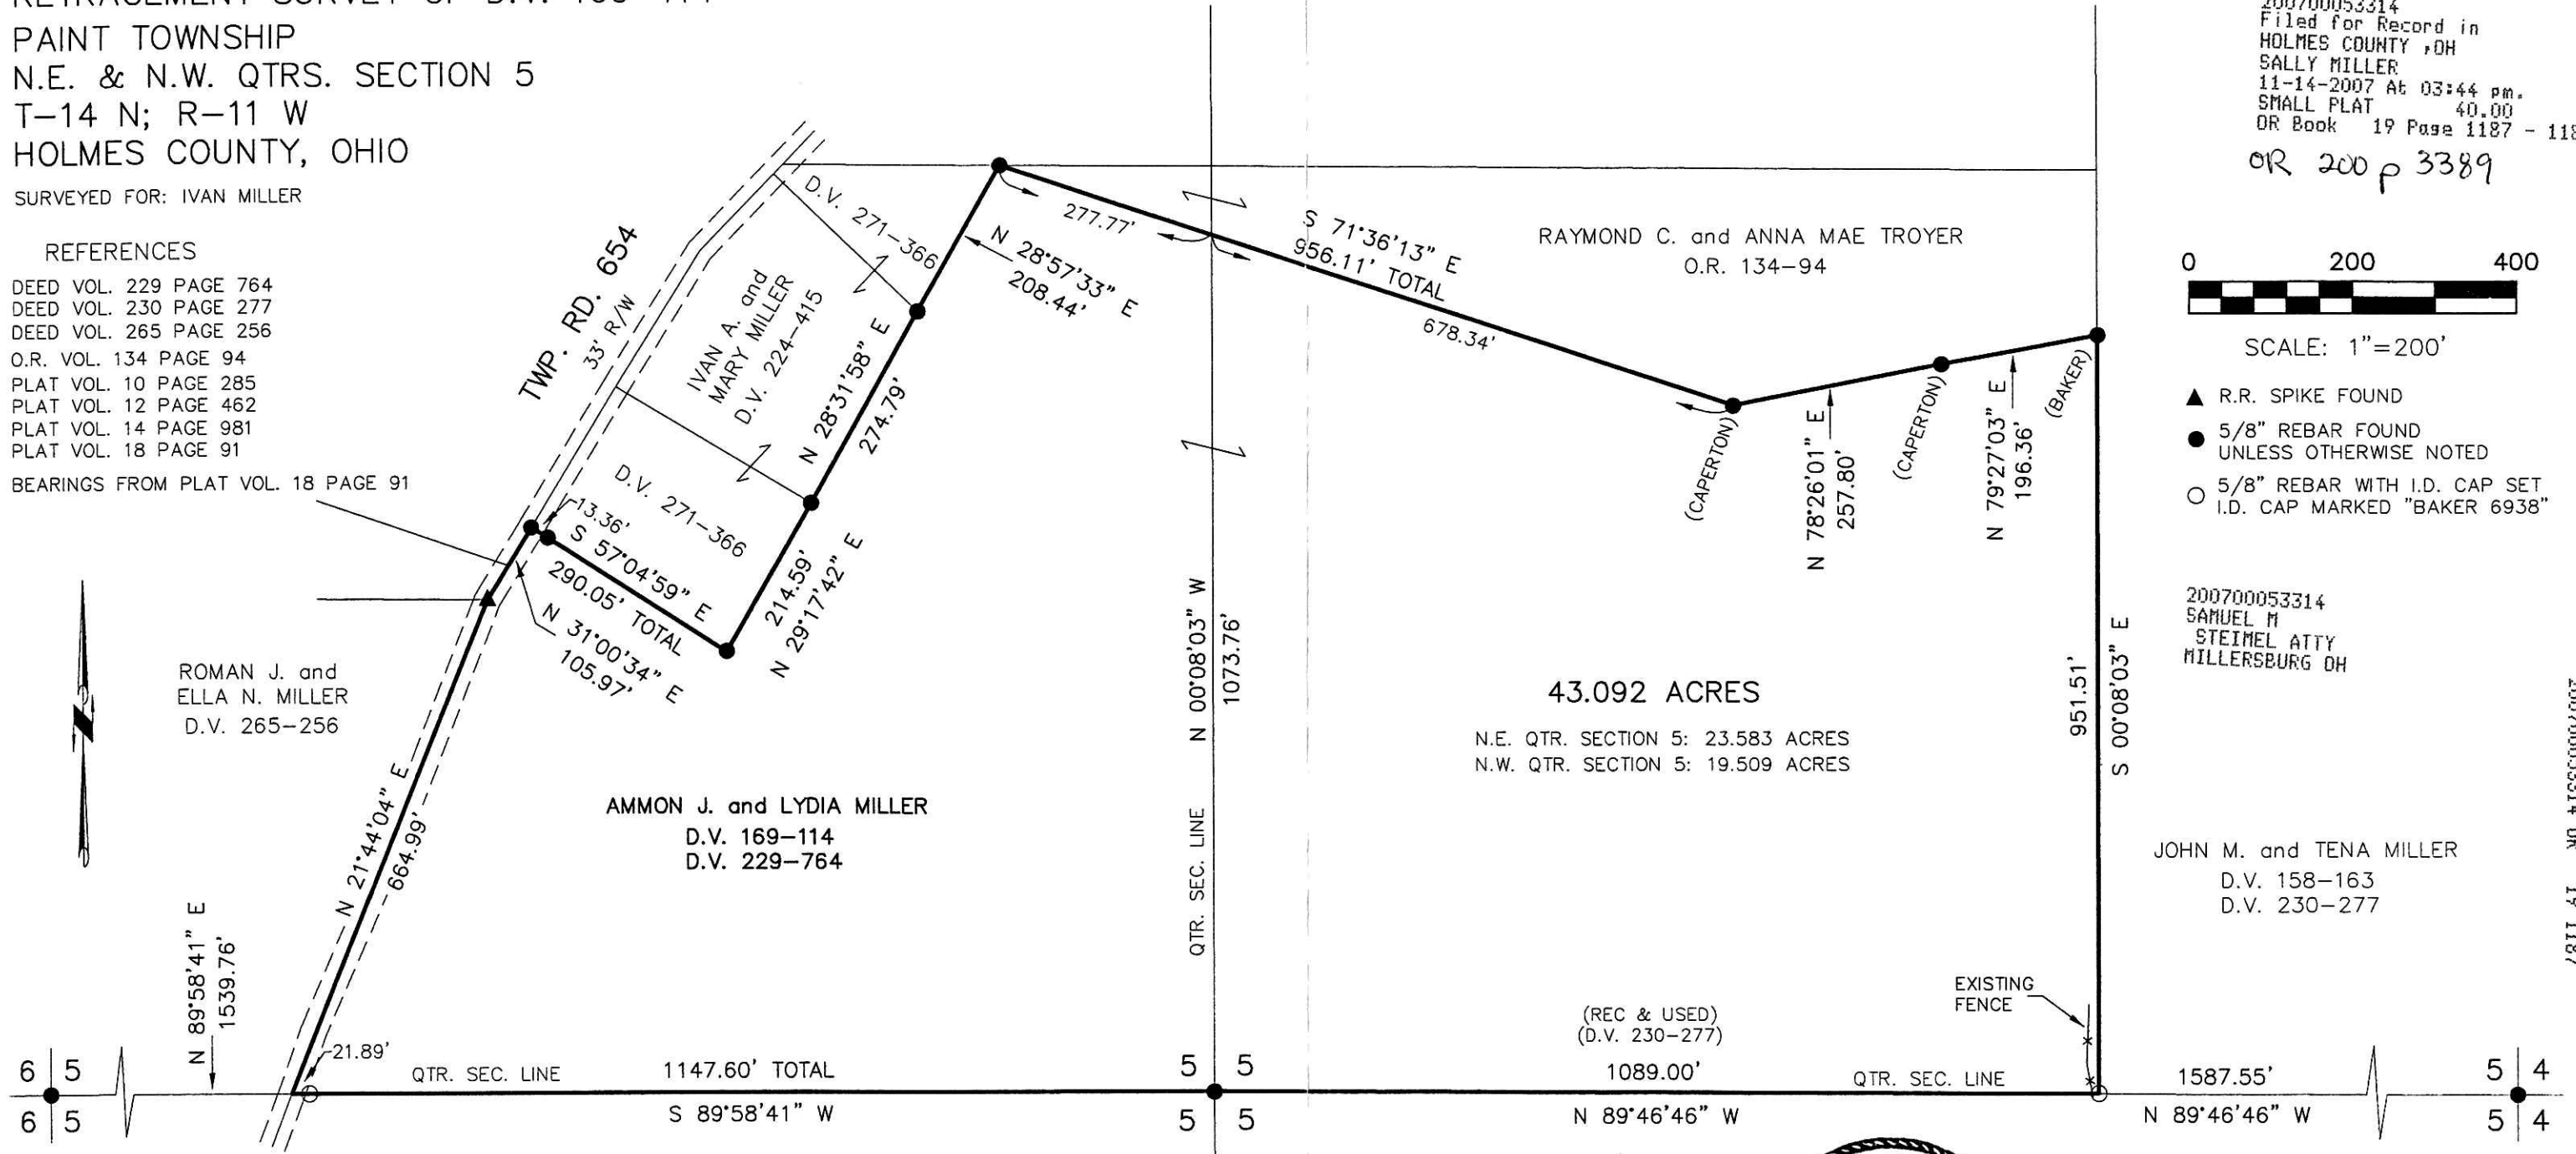

DONALD C. BAKER SURVEYING  
 138 N. CLAY ST.  
 MILLERSBURG, OHIO, 44654  
 PH. 330-674-4788  
 FAX. 330-674-6027



I CERTIFY THIS SURVEY TO BE CORRECT TO THE BEST OF MY KNOWLEDGE.  
*Donald C. Baker*  
 DONALD C. BAKER P.S. 6938  
 DATE: AUG. 27, 2007  
 FDB\ALG-AEG  
 File Name: WORK2\S-501-07\ERZ

PLAT APPROVED

*11/7/2007*