


Instrument 200800054355 OR Book Page 19 1236

RETRACEMENT SURVEY OF AN EXISTING TRACT



- ▲ R.R. SPIKE FOUND
- 5/8" REBAR FOUND  
UNLESS OTHERWISE NOTED
- 5/8" REBAR SET WITH I.D. CAP  
I.D. CAP MARKED "BAKER 6938"
- △ R.R. SPIKE SET

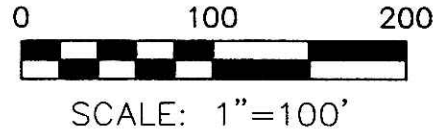



KNOX TOWNSHIP  
 1ST. QTR., LOT 5  
 T-9 N; R-9 W  
 HOLMES COUNTY, OHIO

SURVEYED FOR: VERONICA BECKER

REFERENCES


DEED VOL. 262 PAGE 196  
 O.R. VOL. 125 PAGE 31  
 PLAT VOL. 6 PAGE 168  
 BEARINGS FROM PLAT VOL. 6 PAGE 168

200800054355  
 Filed for Record in  
 HOLMES COUNTY, OH  
 SALLY MILLER  
 01-25-2008 At 03:01 pm.  
 SMALL PLAT 40.00  
 OR Book 19 Page 1236 - 1236  
 ORV 202 page 728

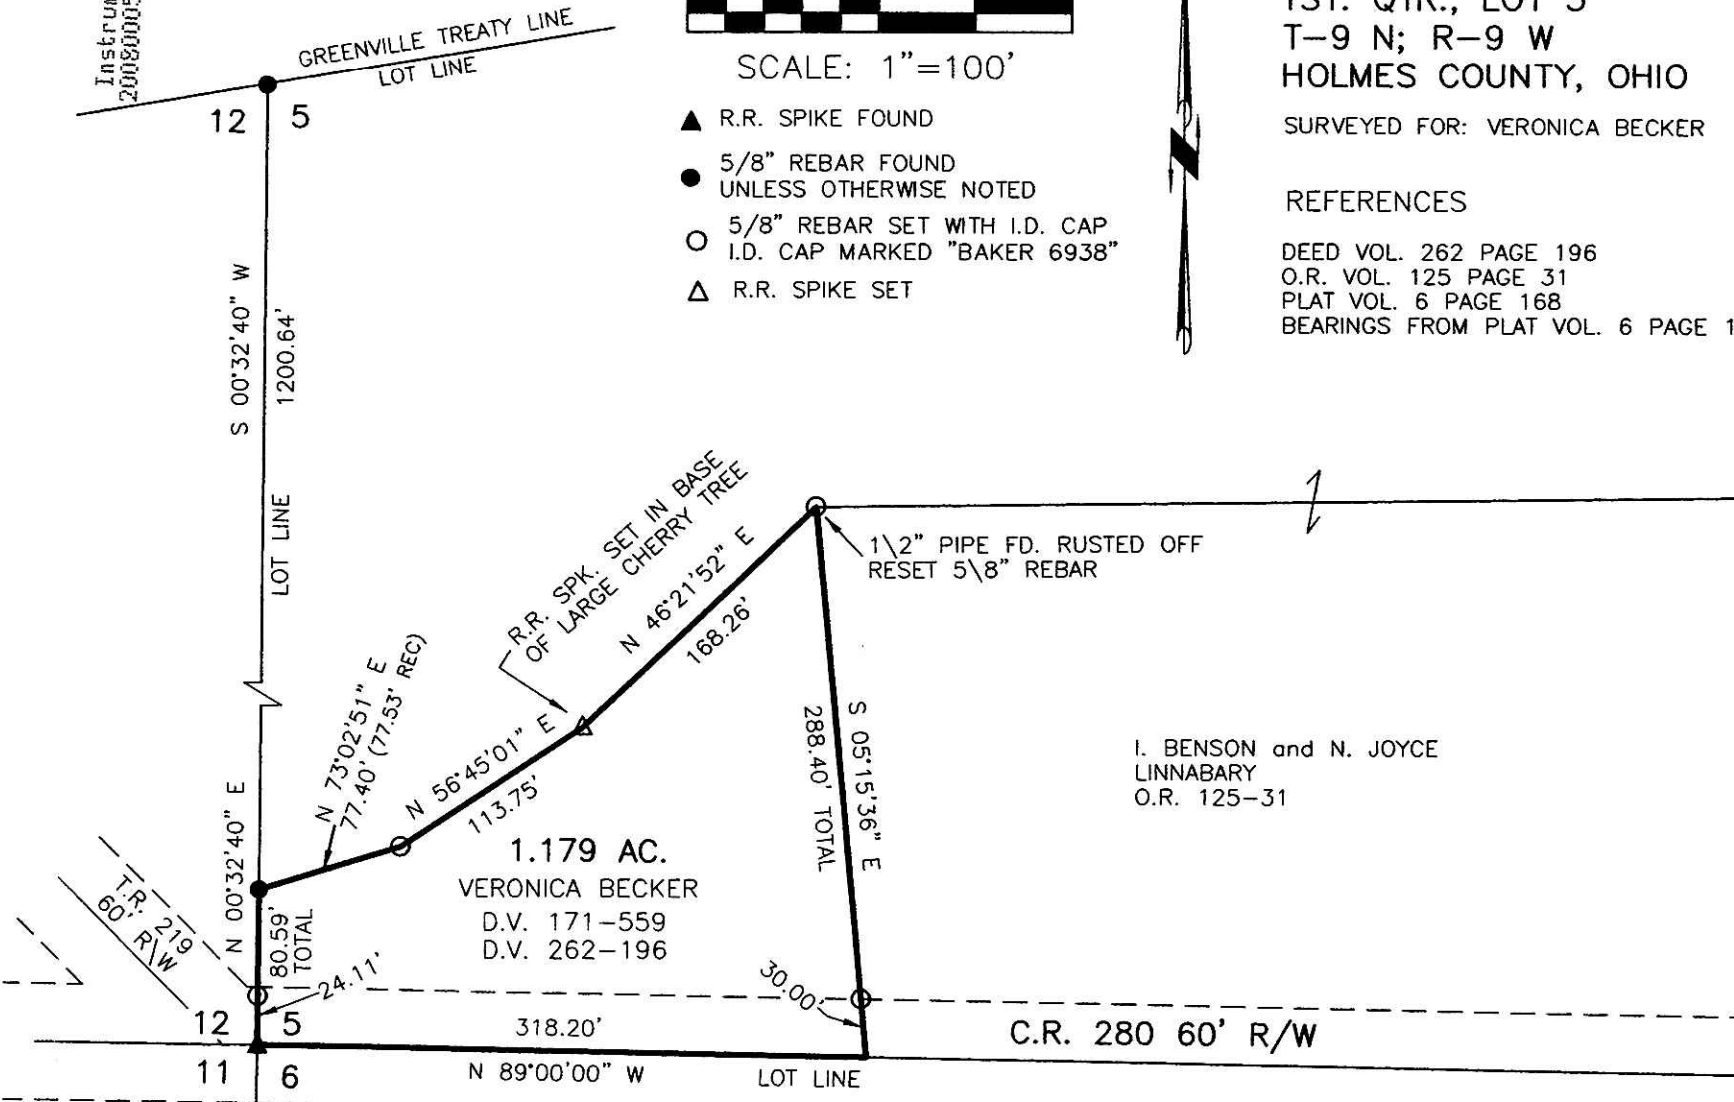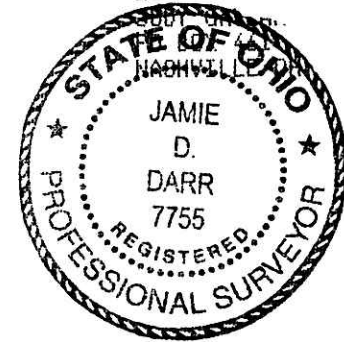

I CERTIFY THIS SURVEY TO BE CORRECT  
 TO THE BEST OF MY KNOWLEDGE.

JAMIE D. DARR P.S. 7755  
 DATE: DECEMBER 11, 2007  
 JDD\ERZ  
 FILE NAME: WORK3A\S-710-07\DCB\MLD

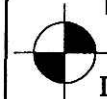

DONALD C. BAKER SURVEYING  
 138 N. CLAY STREET  
 MILLERSBURG, OHIO 44654  
 PH. 330-674-4788  
 FAX 330-674-6027

PLAT APPROVED

*1/25/2008*