


RETRACEMENT SURVEY OF O.R. 201-3284

KILLBUCK TOWNSHIP  
N.E. QTR. SECTION 1  
T-8 N; R-8 W  
HOLMES COUNTY, OHIO

200800055995  
Filed for Record in  
HOLMES COUNTY, OH  
SALLY MILLER  
05-07-2008 At 03:48 pm.  
SMALL PLAT 40.00  
OR Book 19 Page 1302 - 1302


SURVEYED FOR: RESOURCETITLE

OR 204 8 1247

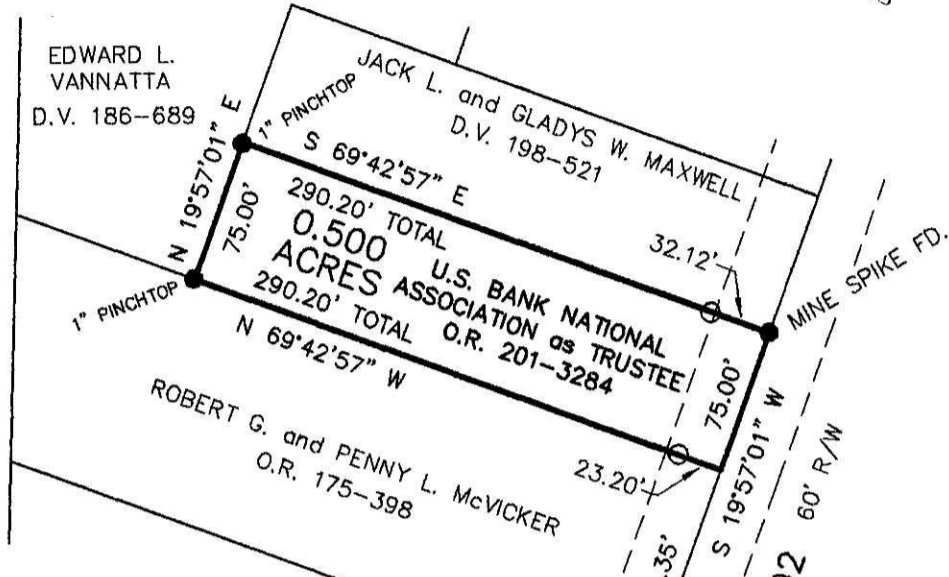

REFERENCES

- DEED VOL. 198 PAGE 521
- O.R. VOL. 188 PAGE 2045
- O.R. VOL. 201 PAGE 3284
- PLAT VOL. 5 PAGES 50 & 84
- PLAT VOL. 7 PAGES 59 & 210
- PLAT VOL. 19 PAGE 696
- BEARINGS FROM PLAT VOL. 19 PAGE 696

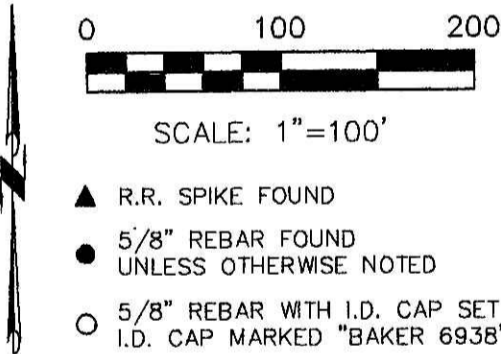

- ▲ R.R. SPIKE FOUND
- 5/8" REBAR FOUND UNLESS OTHERWISE NOTED
- 5/8" REBAR WITH I.D. CAP SET I.D. CAP MARKED "BAKER 6938"

200800055995  
RESOURCE  
TITLE  
INDEPENDENCE OH


CONRAD D. and LOIS A. MILLER  
O.R. 188-2045

NANCY L. JUDSON, TRUSTEE  
O.R. 77-245



PLAT APPROVED

5/5/2008

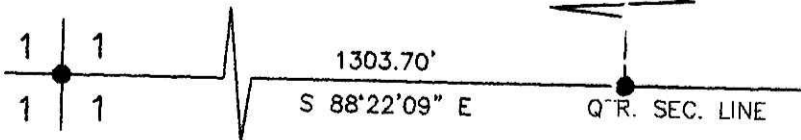


I CERTIFY THIS SURVEY TO BE CORRECT TO THE BEST OF MY KNOWLEDGE.

*Donald C. Baker*

DONALD C. BAKER P.S. 6938  
DATE: APRIL 16, 2008

KES\DB  
File Name: WORK2\S-158-08\ERZ

 DONALD C. BAKER SURVEYING  
138 N. CLAY ST.  
MILLERSBURG, OHIO, 44654  
PH. 330-674-4788  
FAX. 330-674-6027