

RETRACEMENT SURVEY OF
D.V. 273-518 & O.R. 128-154


CLARK TOWNSHIP
S.E. QTR. SECTION 7
T-8 N; R-5 W
HOLMES COUNTY, OHIO

SURVEYED FOR: DANIEL MILLER


Instrument 200800058545 OR Book Page 19 1399

REFERENCES

- DEED VOL. 273 PAGE 518
- O.R. VOL. 21 PAGE 841
- O.R. VOL. 94 PAGE 70
- O.R. VOL. 128 PAGE 154
- PLAT VOL. 16 PAGE 942
- PLAT VOL. 18 PAGE 429
- BEARINGS FROM PLAT VOL. 18 PAGE 429

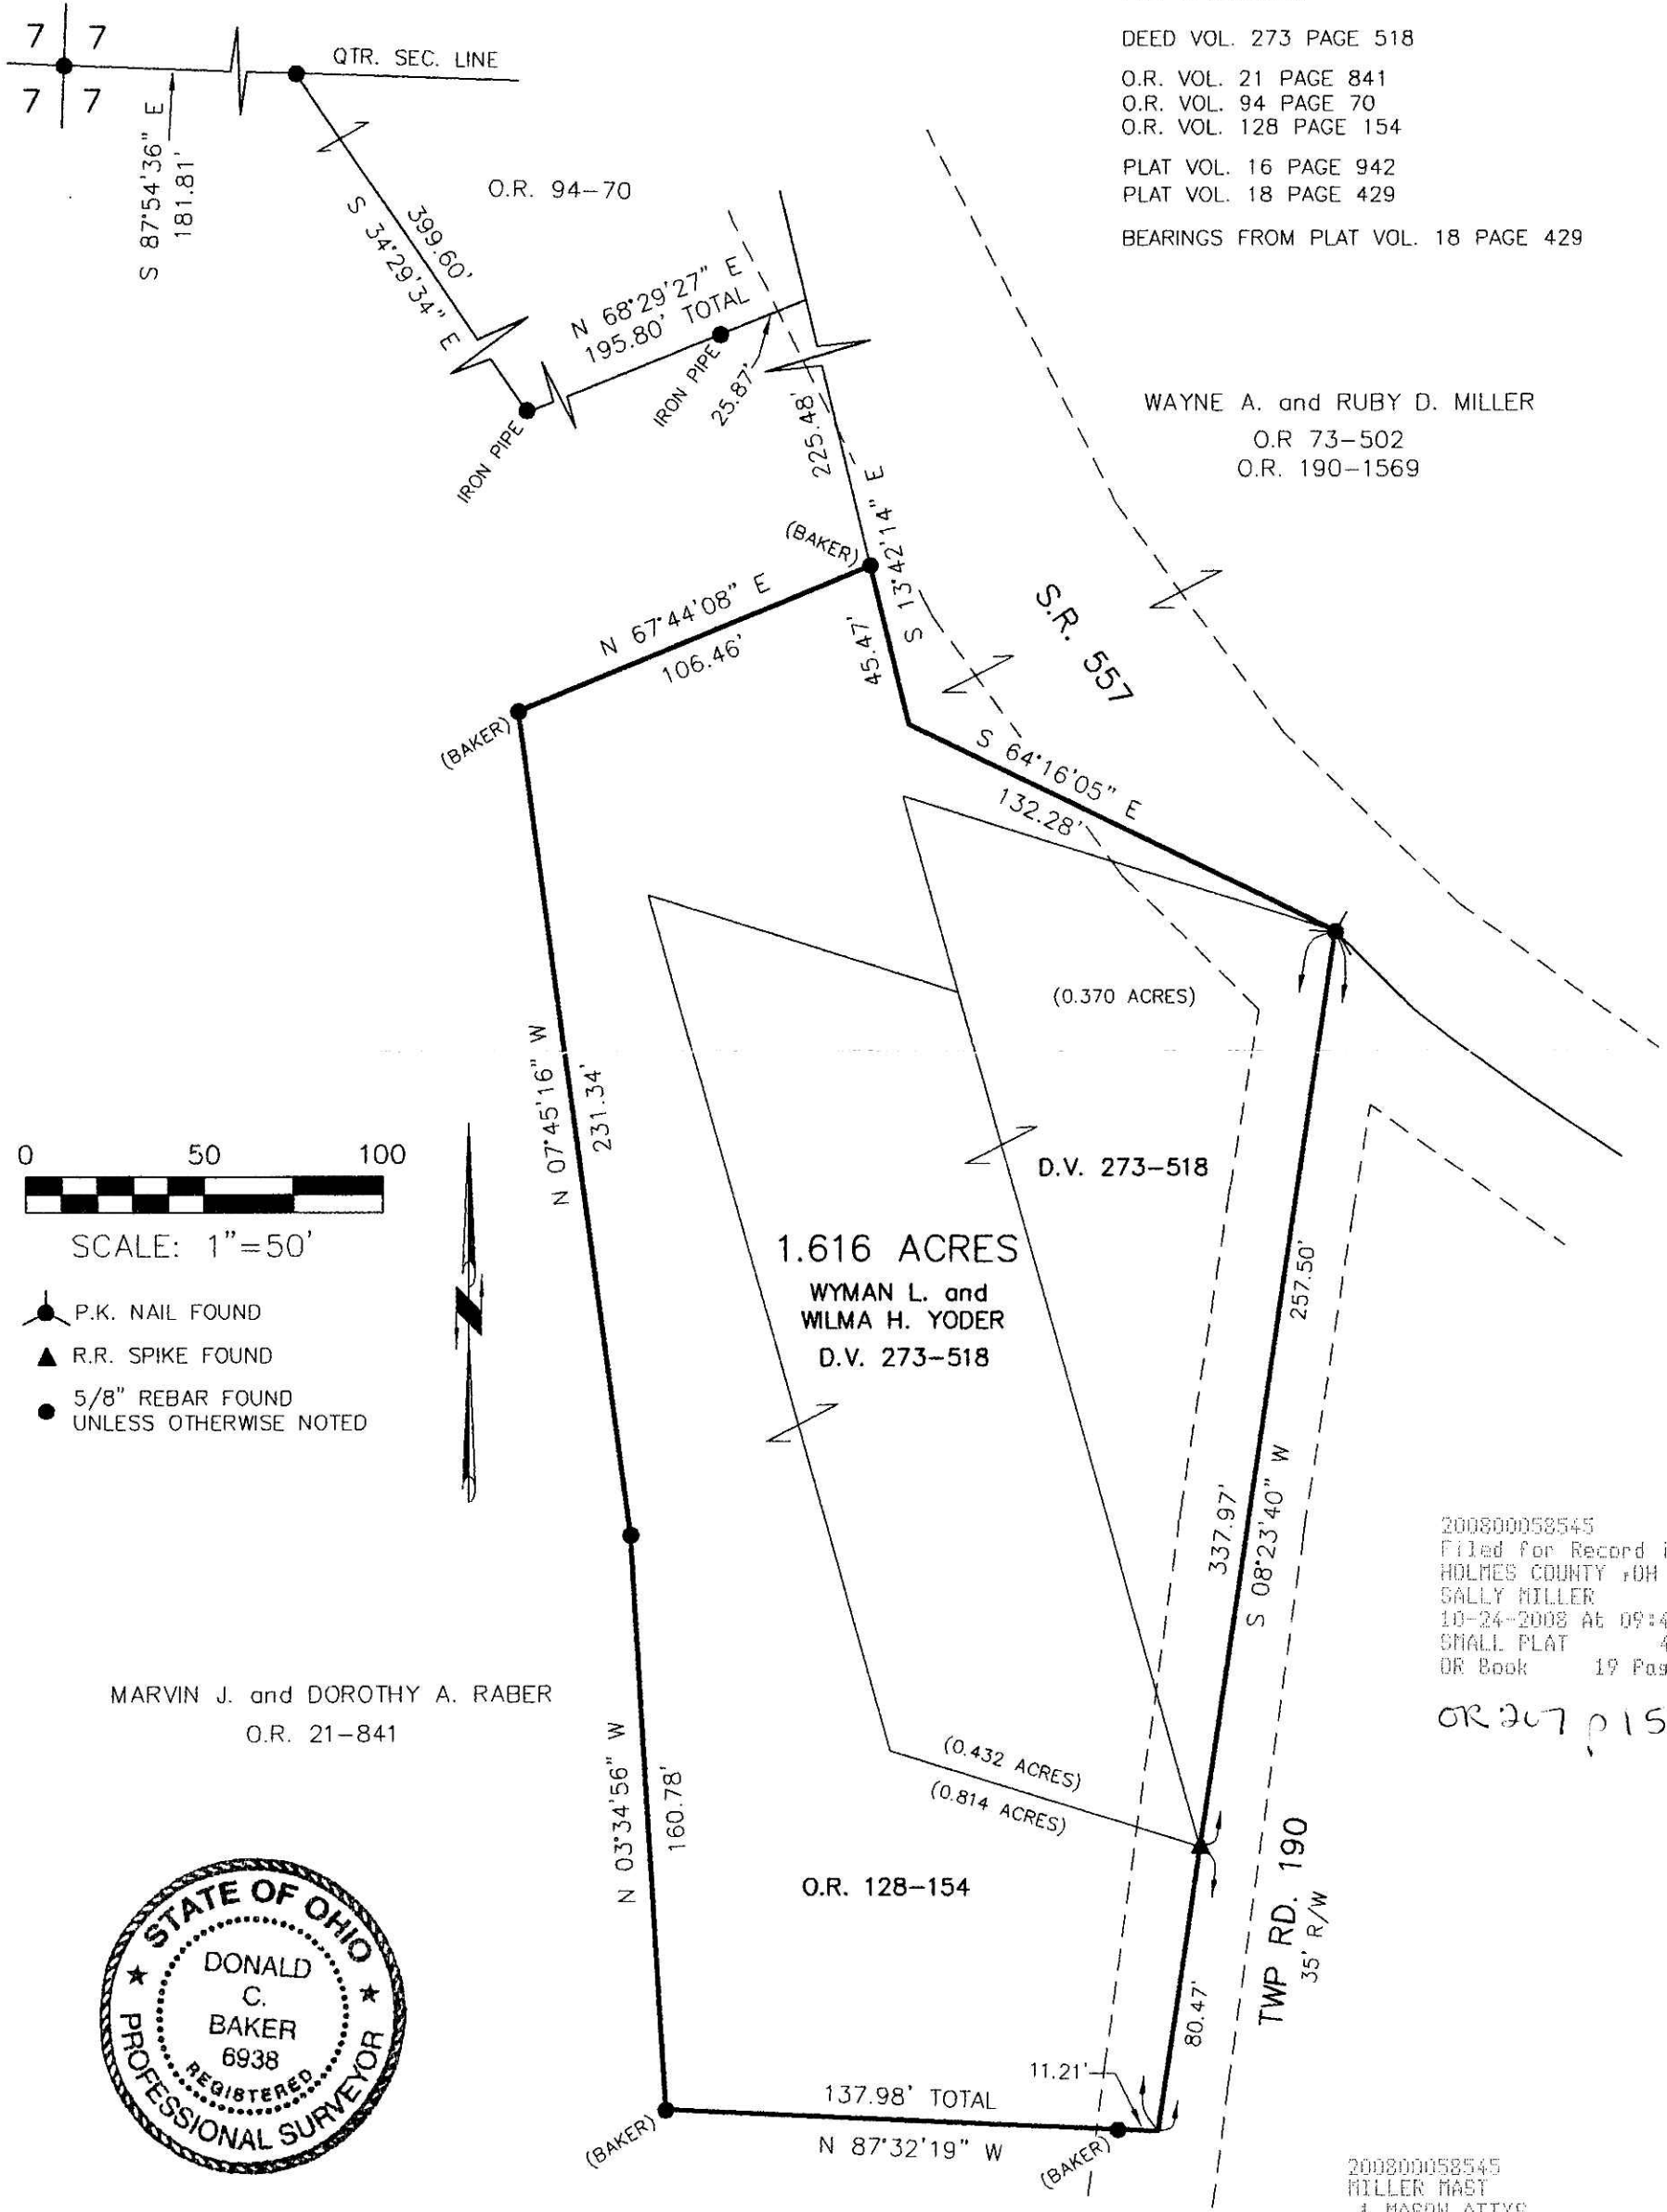

WAYNE A. and RUBY D. MILLER
O.R. 73-502
O.R. 190-1569

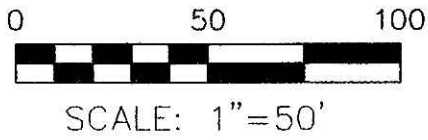

- P.K. NAIL FOUND
- ▲ R.R. SPIKE FOUND
- 5/8" REBAR FOUND UNLESS OTHERWISE NOTED

MARVIN J. and DOROTHY A. RABER
O.R. 21-841



200800058545
Filed for Record in
HOLMES COUNTY OH
SALLY MILLER
10-24-2008 At 09:48 am.
SMALL PLAT 40.00
OR Book 19 Page 1399 - 1399

OR 207 p 1582

200800058545
MILLER HAST
& MASON ATTYS
MILLERSBURG OH


I CERTIFY THIS SURVEY TO BE CORRECT
TO THE BEST OF MY KNOWLEDGE.

Donald C. Baker

DONALD C. BAKER P.S. 6938

DATE: OCT. 7, 2008

FDB\ALG
FILE NAME: WORK4\S-482-08\ERZ

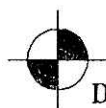

DONALD C. BAKER SURVEYING
138 N. CLAY STREET
MILLERSBURG, OHIO 44654
PH. 330-674-4788
FAX 330-674-6027

PLAT APPROVED

10/17/2008