RETRACEMENT SURVEY OF D.V. 276-524

RICHLAND TOWNSHIP
S.W. QTR. SECTION 23
S.E. QTR. SECTION 24
T-8 N; R-9 W
HOLMES COUNTY, OHIO

SURVEYED FOR: TIM STERKEL

0 200 400

SCALE: 1"=200'

- ■ STONE FOUND
- ● 5/8" REBAR FOUND UNLESS OTHERWISE NOTED
- ○ 5/8" REBAR SET WITH I.D. CAP I.D. CAP MARKED "BAKER 6938"

REFERENCES

DEED VOL. 186 PAGES 133 & 136
DEED VOL. 257 PAGE 913
DEED VOL. 267 PAGE 378
DEED VOL. 273 PAGE 272
DEED VOL. 276 PAGE 524

O.R. VOL. 36 PAGE 565
O.R. VOL. 151 PAGE 830

PLAT VOL. 2 PAGES 244 & 425
PLAT VOL. 7 PAGE 189
PLAT VOL. 16 PAGE 978
PLAT VOL. 17 PAGE 615

DEED VOL. 339 PAGE 660 (COSHOCTON CO.)

BEARINGS FROM O.R. VOL. 38 PAGE 713 OF THE COSHOCTON COUNTY OFFICIAL RECORDS

DONALD C. BAKER SURVEYING
138 N. CLAY STREET
MILLERSBURG, OHIO 44654
PH. 330-674-4788
FAX 330-674-6027

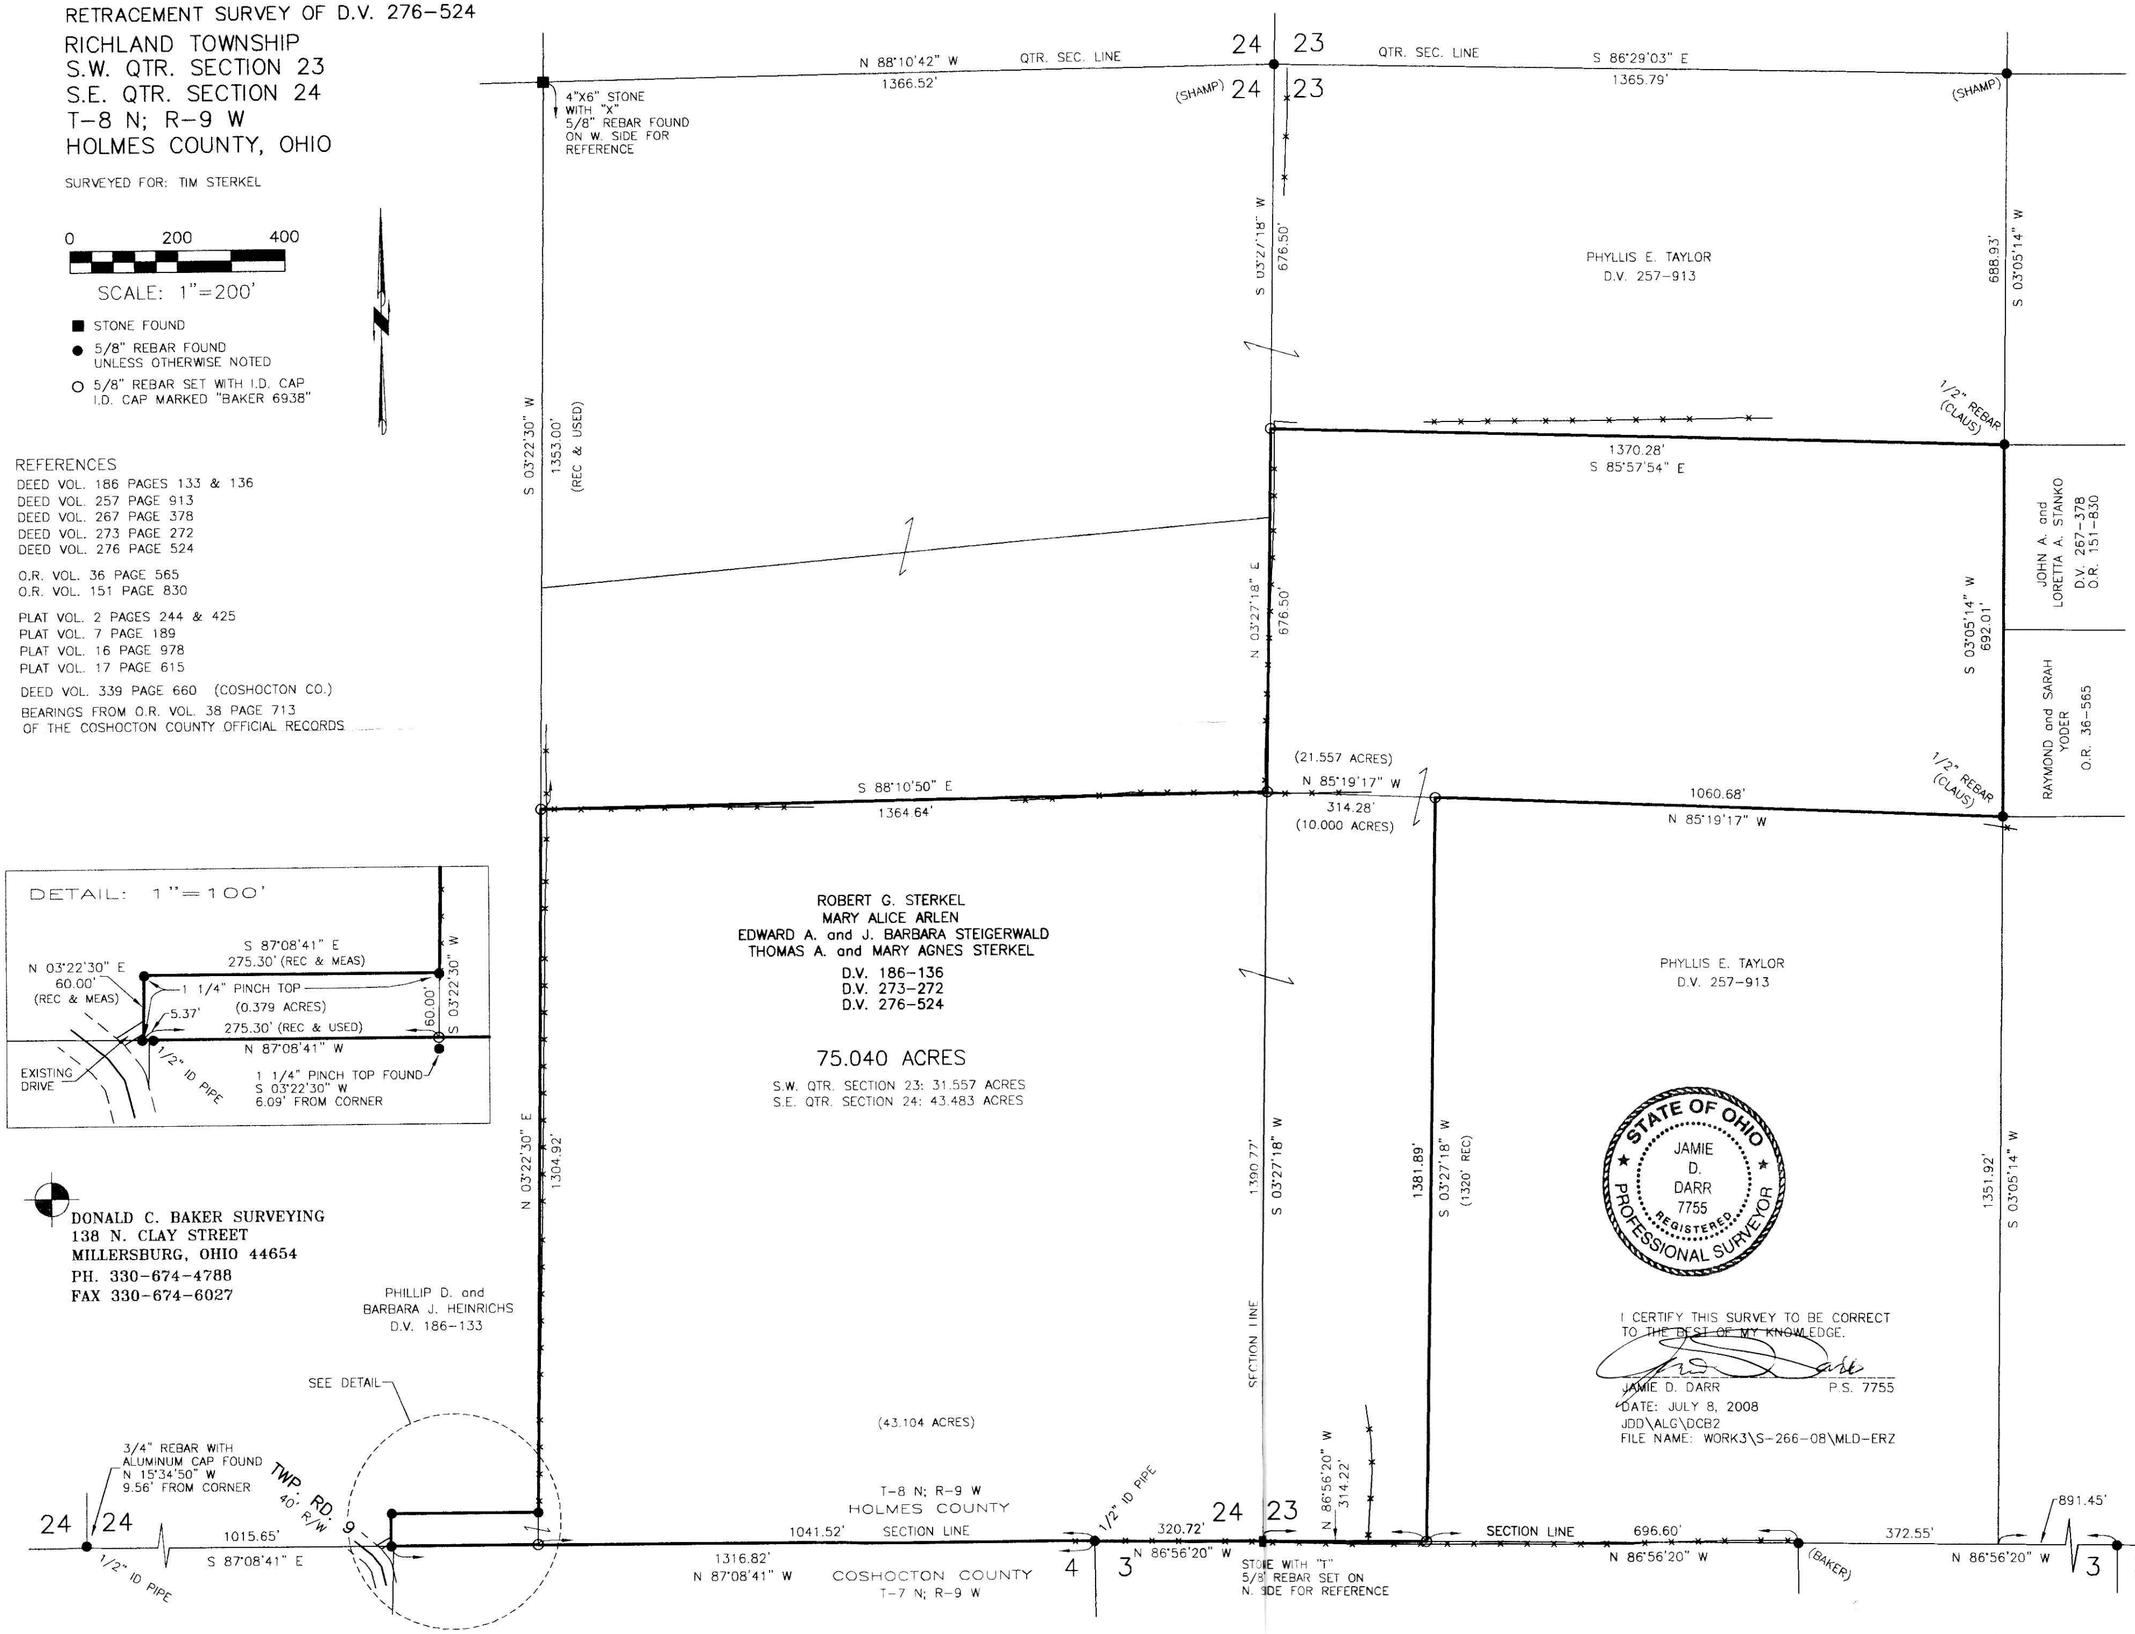

STATE OF OHIO
JAMIE D. DARR
7755
REGISTERED PROFESSIONAL SURVEYOR

I CERTIFY THIS SURVEY TO BE CORRECT TO THE BEST OF MY KNOWLEDGE.

JAMIE D. DARR P.S. 7755

DATE: JULY 8, 2008
JDD\ALG\DCB2
FILE NAME: WORK3\S-266-08\MLD-ERZ

Instrument 200800058775 OR | Book Page 19 1407

200800058775
Filed for Record in
HOLMES COUNTY ,OH
SALLY MILLER
11-07-2008 At 12:21 pm.
PLAT MED 43.20
OR Book 19 Page 1407 - 1407
ORV 207 pages 2498-2501-2504

200800058775
TIM STERKEL
1414 S GREEN
STE 310
CLEVELAND OH 44121

PLAT APPROVED
8/25/2008