

WALNUT CREEK TOWNSHIP
 S.E. QTR. SECTION 18
 T-9 N; R-5 W
 HOLMES COUNTY, OHIO

SURVEYED FOR: ANDY RABER



REFERENCES

- DEED VOL. 179 PAGE 289
- DEED VOL. 218 PAGE 664
- DEED VOL. 243 PAGE 674
- O.R. VOL. 182 PAGE 1529
- O.R. VOL. 194 PAGES 3349 & 3351
- PLAT VOL. 12 PAGE 231
- PLAT VOL. 19 PAGES 421 & 936
- BEARINGS FROM PLAT VOL. 19 PAGE 936

Instrument 200900062085 OR Book Page 19 1535

200900062085
 Filed for Record in
 HOLMES COUNTY, OH
 ANITA HALL
 06-30-2009 At 12:40 pm.
 SMALL PLAT 40.00
 OR Book 19 Page 1535 - 1535
 OR all page 2800

200900062085
 PAUL MILLER LAW OFFICE
 MILLESBURG OH 44654

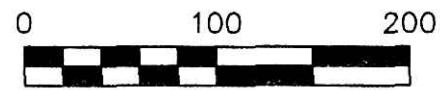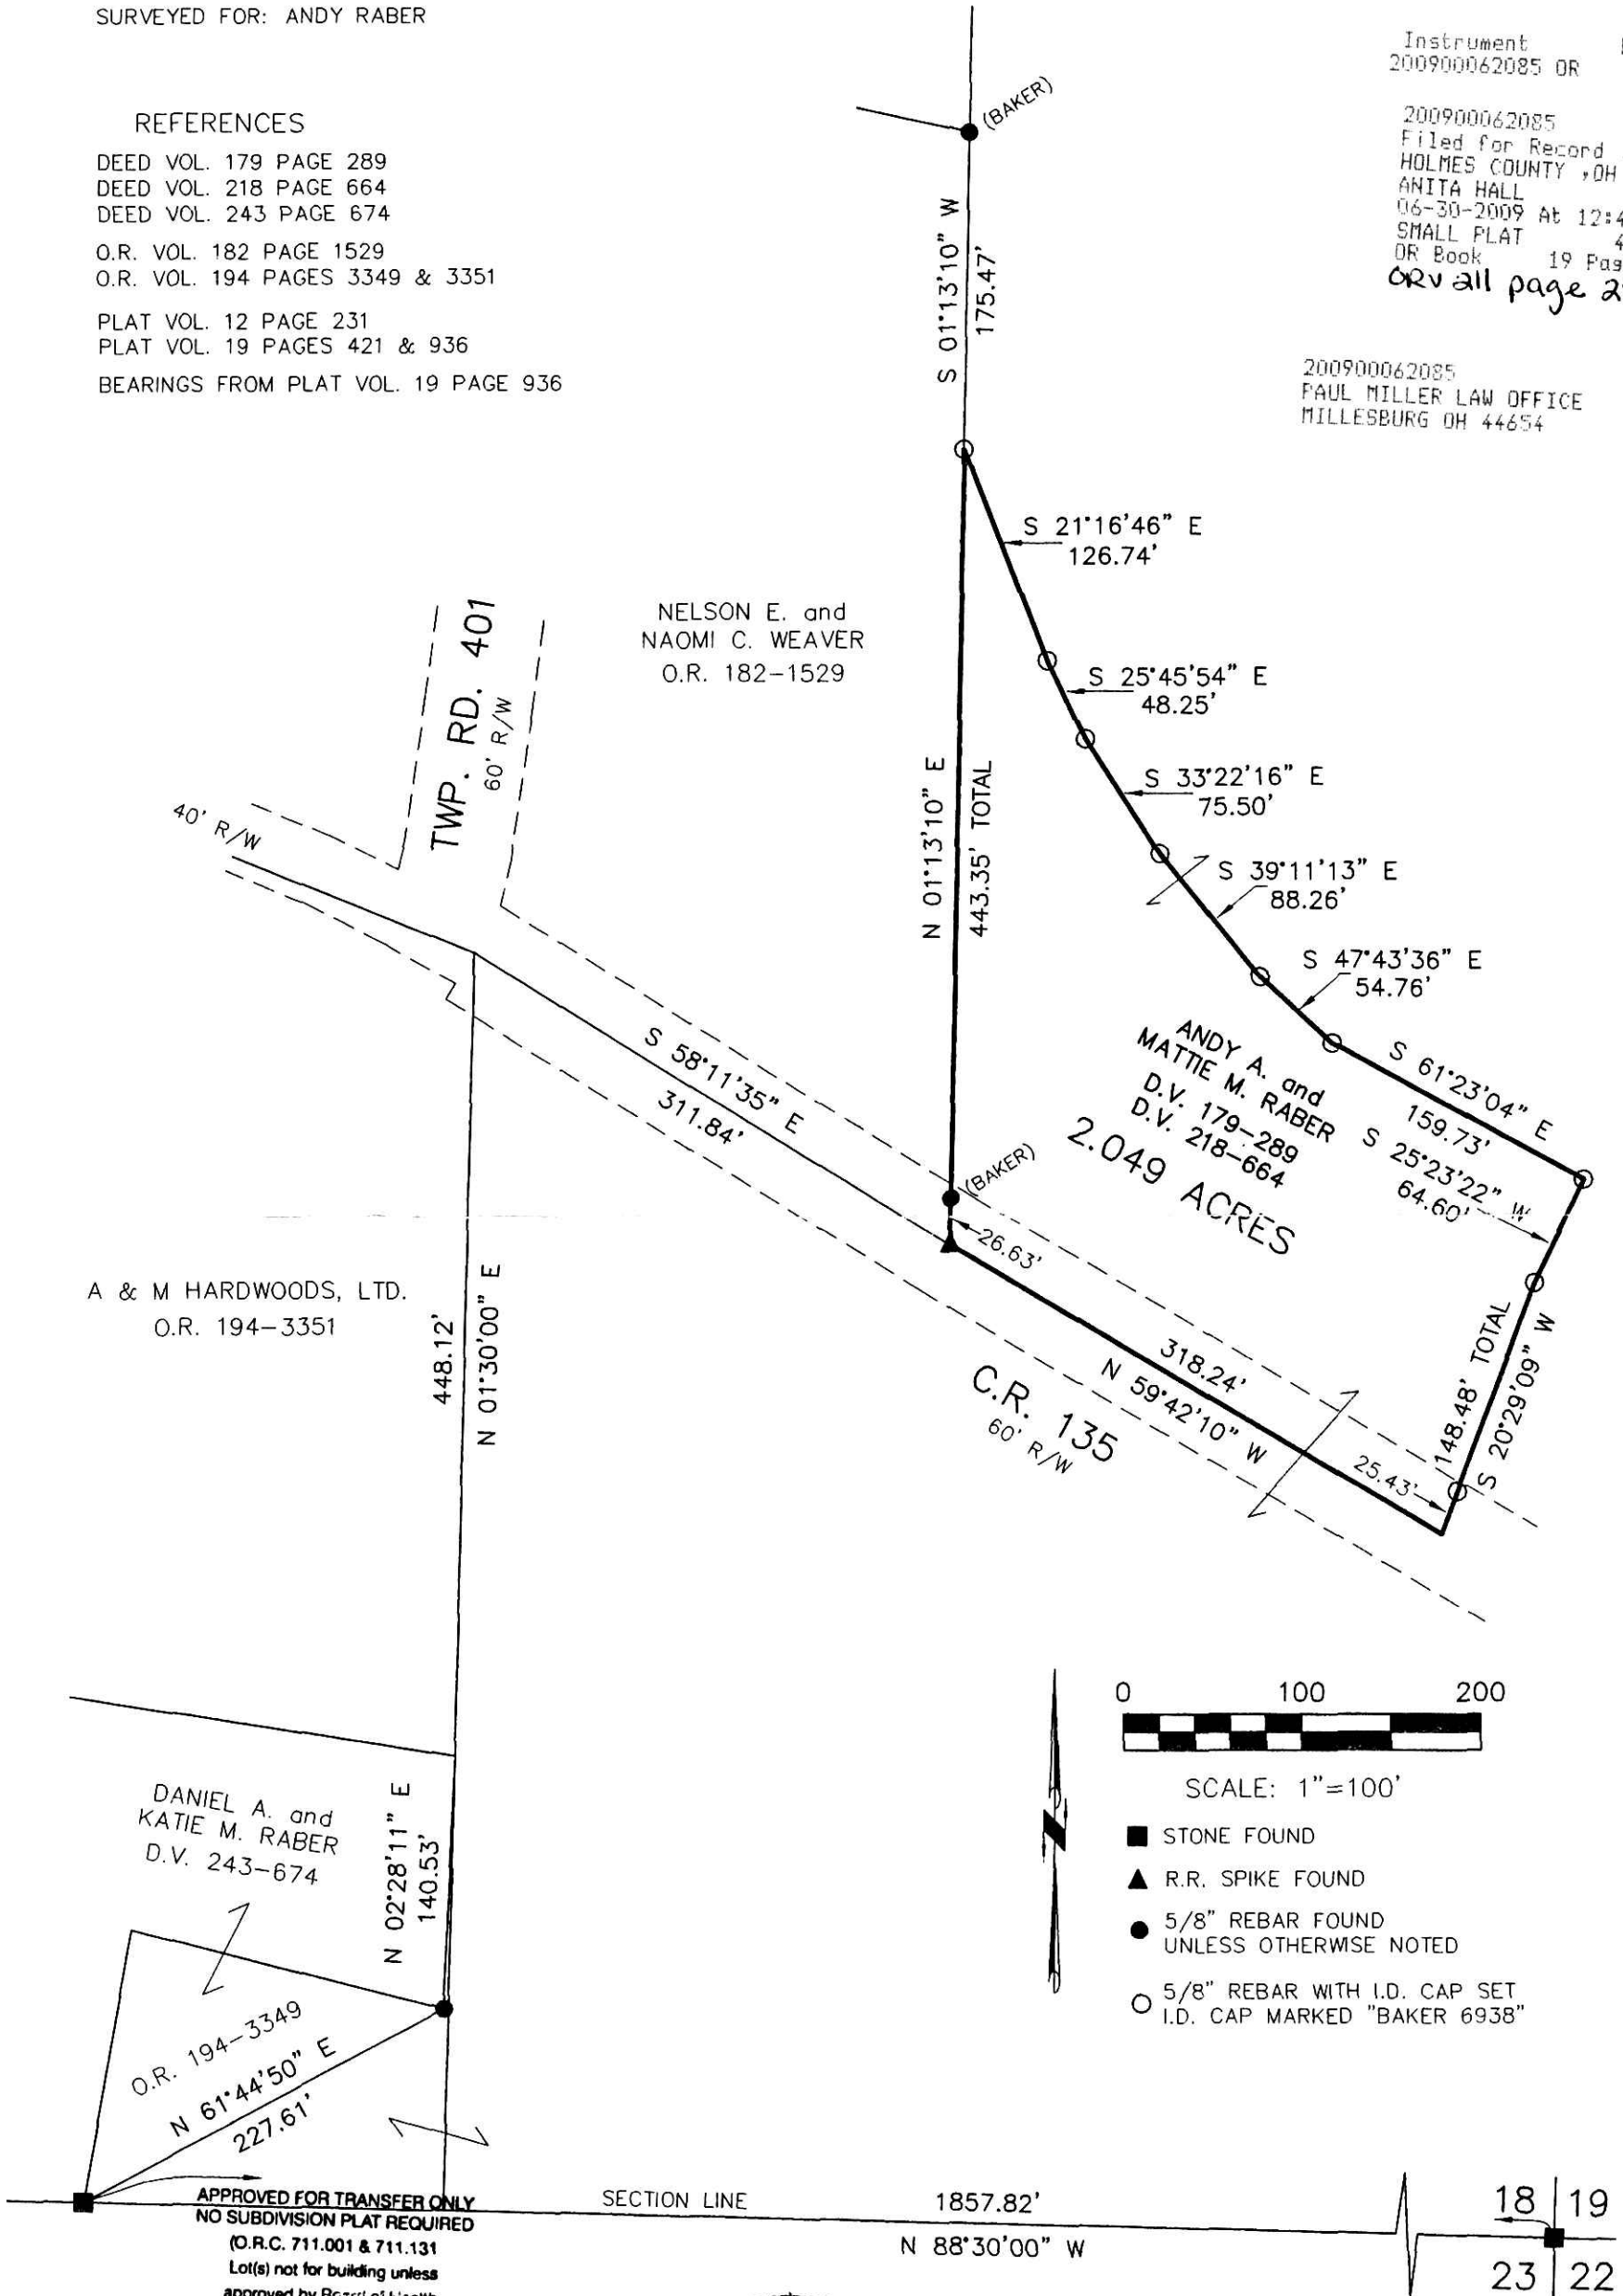

SCALE: 1"=100'

- STONE FOUND
- ▲ R.R. SPIKE FOUND
- 5/8" REBAR FOUND UNLESS OTHERWISE NOTED
- 5/8" REBAR WITH I.D. CAP SET I.D. CAP MARKED "BAKER 6938"

APPROVED FOR TRANSFER ONLY
 NO SUBDIVISION PLAT REQUIRED
 (O.R.C. 711.001 & 711.131
 Lot(s) not for building unless
 approved by Board of Health.
 HOLMES CO. PLANNING COMM.

By DB Date 6-17-09

I CERTIFY THIS SURVEY TO BE CORRECT
 TO THE BEST OF MY KNOWLEDGE.

Donald C. Baker
 DONALD C. BAKER P.S. 6938
 DATE: MAY 12, 2009

KES\ACB
 File Name: WORK2\S-140-09\ERZ



PLAT APPROVED

6-11-09 Jef



DONALD C. BAKER SURVEYING
 138 N. CLAY ST.
 MILLERSBURG, OHIO, 44654
 PH. 330-674-4788
 FAX. 330-674-6027