

WALNUT CREEK TOWNSHIP
 N.W. QTR. SECTION 13
 T-9 N; R-5 W
 HOLMES COUNTY, OHIO


SURVEYED FOR: MYRON MILLER

200900062214
 HENRY RIDGE
 TITLE
 MILLERSBURG, OHIO

Instrument 200900062214 DR Book Page 19 1542

200900062214
 Filed for Record in
 HOLMES COUNTY #09
 ANITA HALL
 07-09-2009 At 03:33 pm.
 SHALL PLAT \$0.00
 DR Book 19 Page 1542 - 1542

CR 211 p 3482, 3484, 3486

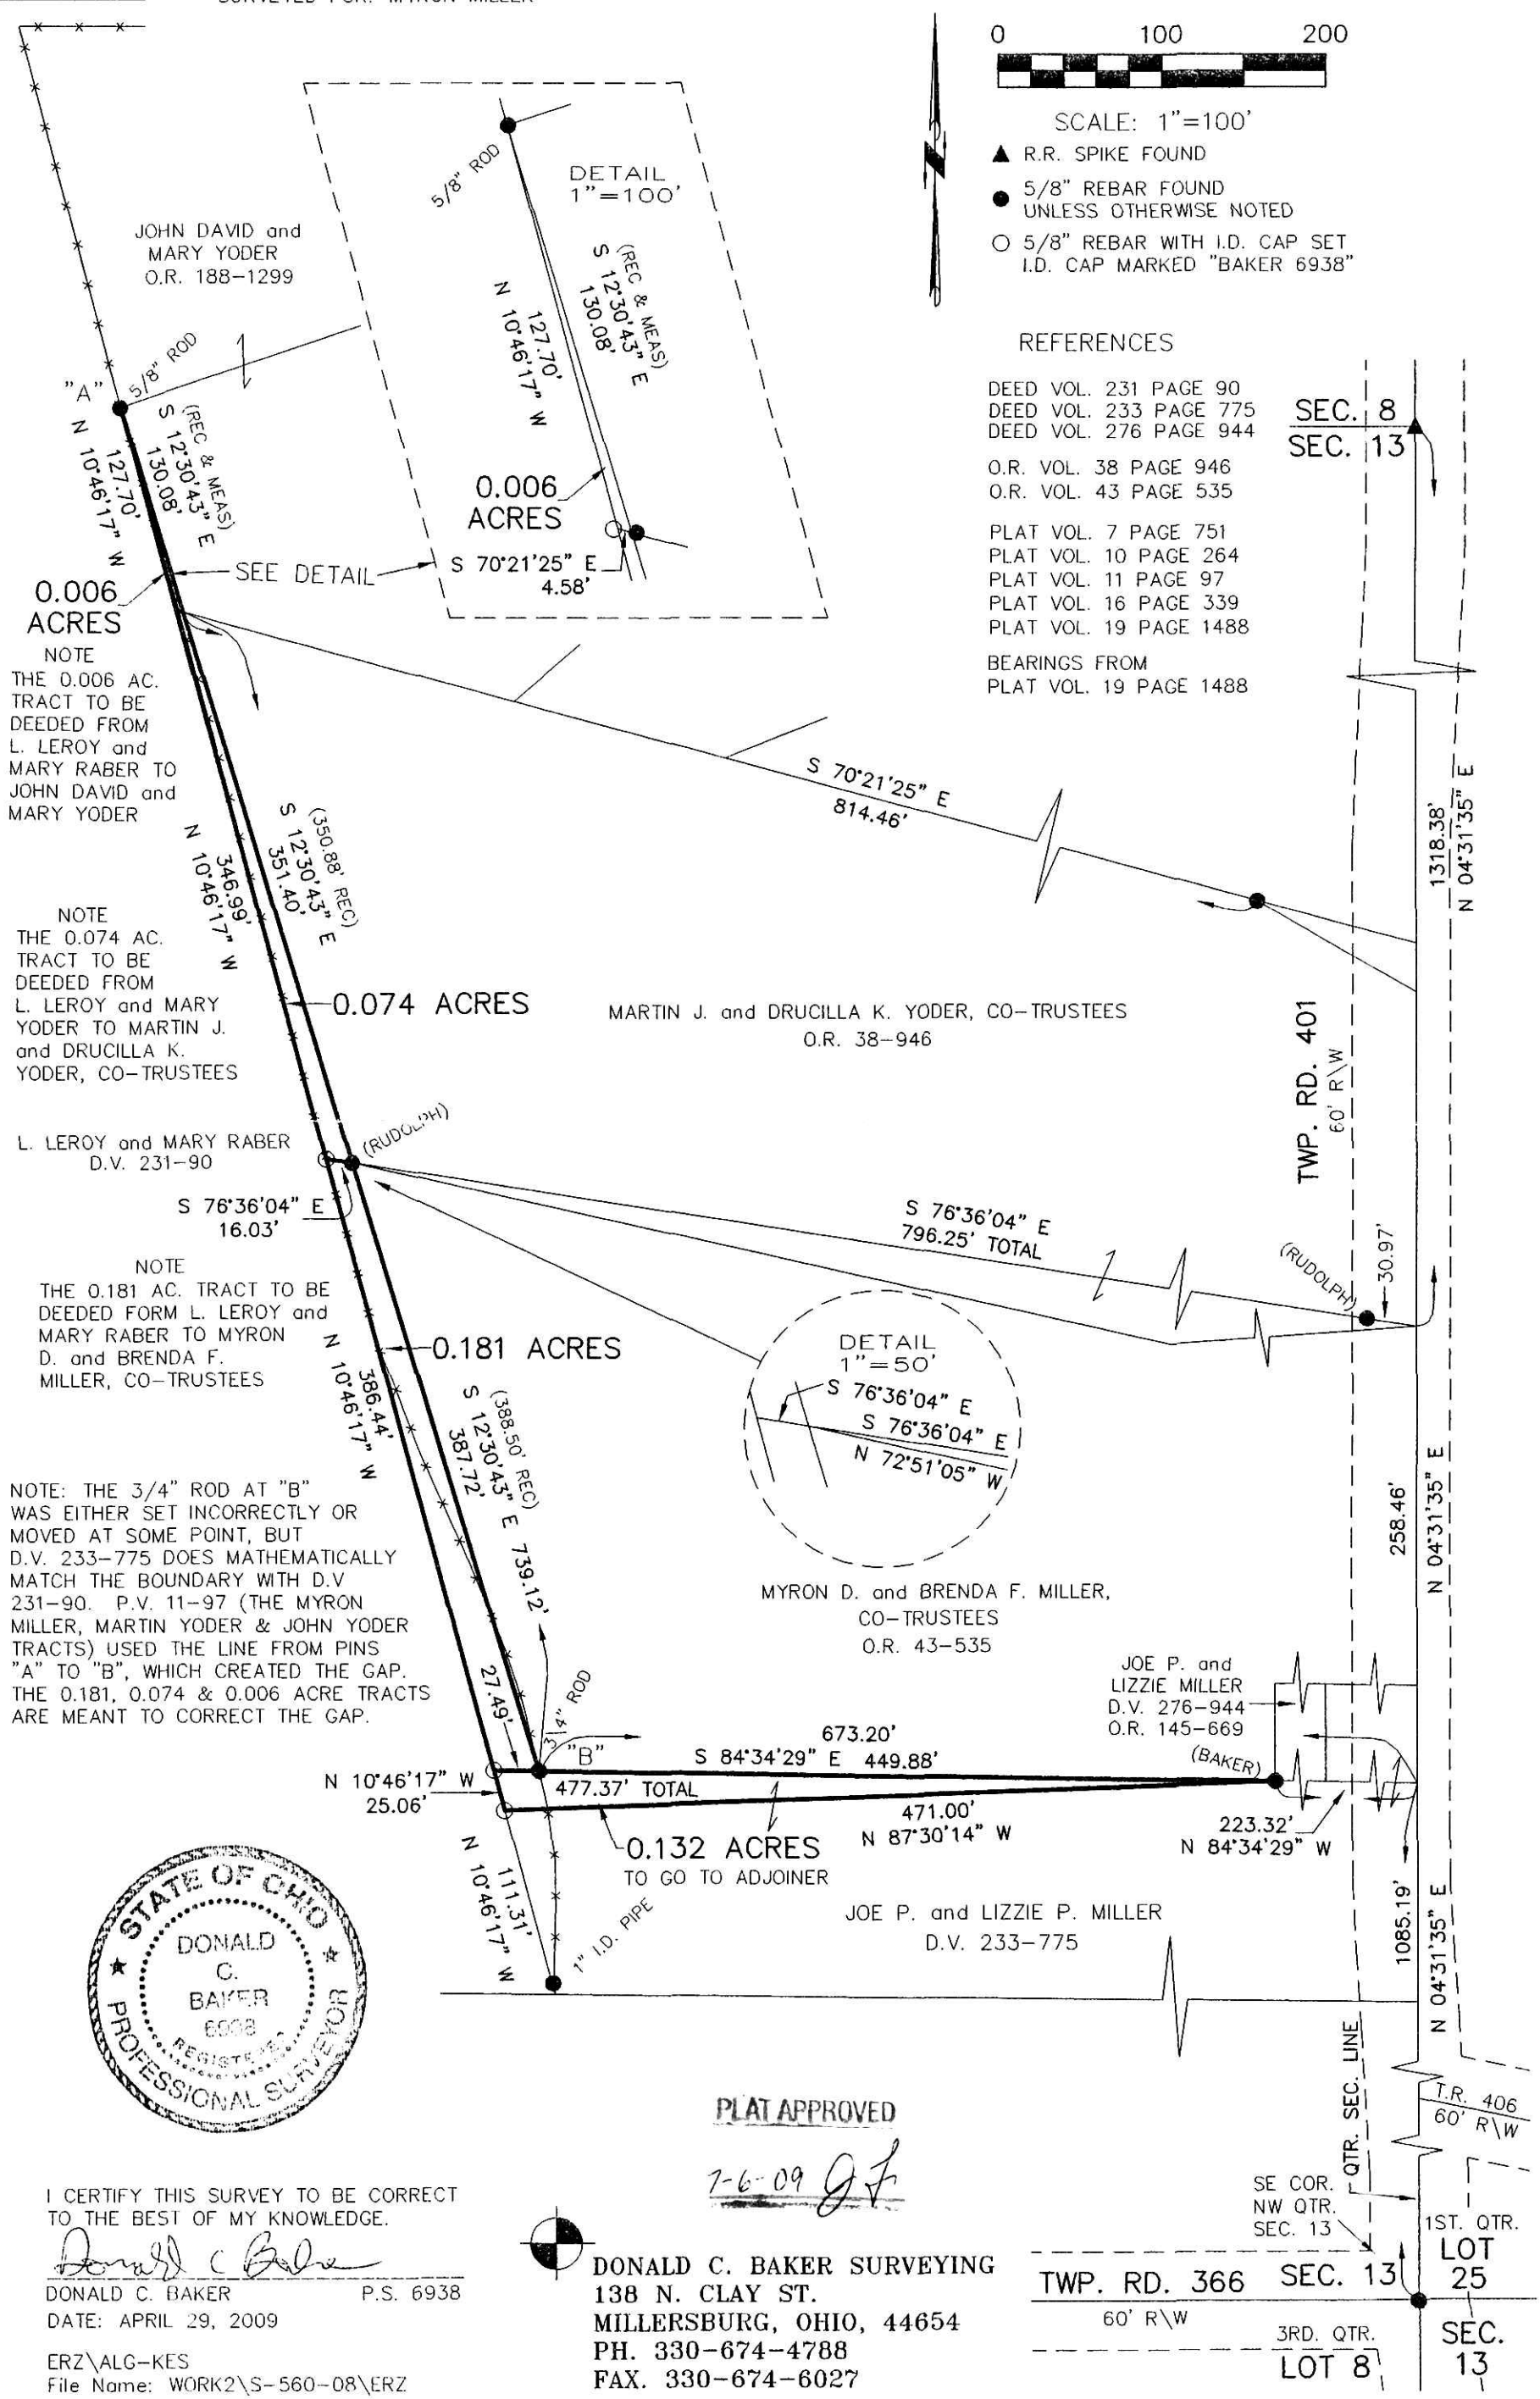

SCALE: 1"=100'

- ▲ R.R. SPIKE FOUND
- 5/8" REBAR FOUND UNLESS OTHERWISE NOTED
- 5/8" REBAR WITH I.D. CAP SET I.D. CAP MARKED "BAKER 6938"

REFERENCES

- DEED VOL. 231 PAGE 90
- DEED VOL. 233 PAGE 775
- DEED VOL. 276 PAGE 944
- O.R. VOL. 38 PAGE 946
- O.R. VOL. 43 PAGE 535
- PLAT VOL. 7 PAGE 751
- PLAT VOL. 10 PAGE 264
- PLAT VOL. 11 PAGE 97
- PLAT VOL. 16 PAGE 339
- PLAT VOL. 19 PAGE 1488
- BEARINGS FROM PLAT VOL. 19 PAGE 1488

SEC. 8
 SEC. 13


NOTE
 THE 0.006 AC. TRACT TO BE DEEDED FROM L. LEROY and MARY RABER TO JOHN DAVID and MARY YODER

NOTE
 THE 0.074 AC. TRACT TO BE DEEDED FROM L. LEROY and MARY YODER TO MARTIN J. and DRUCILLA K. YODER, CO-TRUSTEES

L. LEROY and MARY RABER D.V. 231-90

NOTE
 THE 0.181 AC. TRACT TO BE DEEDED FROM L. LEROY and MARY RABER TO MYRON D. and BRENDA F. MILLER, CO-TRUSTEES

NOTE: THE 3/4" ROD AT "B" WAS EITHER SET INCORRECTLY OR MOVED AT SOME POINT, BUT D.V. 233-775 DOES MATHEMATICALLY MATCH THE BOUNDARY WITH D.V. 231-90. P.V. 11-97 (THE MYRON MILLER, MARTIN YODER & JOHN YODER TRACTS) USED THE LINE FROM PINS "A" TO "B", WHICH CREATED THE GAP. THE 0.181, 0.074 & 0.006 ACRE TRACTS ARE MEANT TO CORRECT THE GAP.

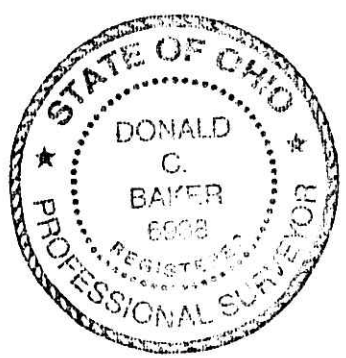

I CERTIFY THIS SURVEY TO BE CORRECT TO THE BEST OF MY KNOWLEDGE.
Donald C. Baker
 DONALD C. BAKER P.S. 6938
 DATE: APRIL 29, 2009
 ERZ\ALG-KES
 File Name: WORK2\S-560-08\ERZ

PLAT APPROVED

7-6-09 *gf*

DONALD C. BAKER SURVEYING
 138 N. CLAY ST.
 MILLERSBURG, OHIO, 44654
 PH. 330-674-4788
 FAX. 330-674-6027

TWP. RD. 366 SEC. 13
 60' R\W
 3RD. QTR. LOT 8
 1ST. QTR. LOT 25
 SEC. 13